

INDEX OF SHEETS

1	TITLE SHEET
2	GENERAL NOTES & DETAILS
3	SITE PLAN
4	LOCATION AND BUILDING - 40' X 64' SALT SHED
5	LOCATION AND BUILDING - 50' X 64' SALT SHED
6	QUANTITY SHEET

B-5	SLOPE GRADING, EMBANKMENTS, MUCK	06/01/94
D-3	TREATED GUTTERS	06/01/94
T-1	TEMPORARY EROSION CONTROL DETAILS	06/01/94
T-2	TEMPORARY EROSION CONTROL DETAILS	06/01/94

STANDARDS

RECORD PLANS

CONTRACTOR: SPATES CONST.  
DERBY LINE, VT

RESIDENT ENGINEER: ROSS CLARK

CONSTRUCTION BEGAN: OCTOBER 27, 1998

CONSTRUCTION COMPLETED: SEPTEMBER 30, 1999

RECORD PLANS BY: CONSTRUCTION CADD


I HEREBY CERTIFY THAT ALL THE CONSTRUCTION REQUIRED BY THIS SET OF DRAWINGS HAS BEEN ACCOMPLISHED AS INDICATED HEREIN.

BY: *[Signature]* RESIDENT ENGINEER



DATE: 09/27/01

NOTE: ANY FURTHER INFORMATION CONCERNING FINAL QUANTITIES, AMOUNTS OR OTHER DETAILS RELATIVE TO THIS PROJECT MAY BE FOUND ON MICROFILM IN CENTRAL FILES.

STATE OF VERMONT  
AGENCY OF TRANSPORTATION  
PROPOSED IMPROVEMENT  
CONSTRUCTION OF NEW  
SAND & SALT SHEDS  
TOWN OF CANAAN  
COUNTY OF ESSEX

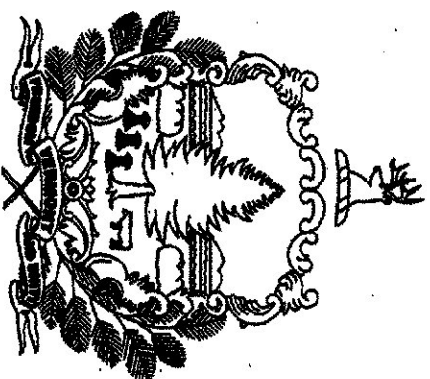

WORK TO BE PERFORMED UNDER THIS CONTRACT INCLUDES CONSTRUCTION OF NEW SAND & SALT SHEDS, SITE WORK, PAVING, DRAINAGE, LANDSCAPING, AND INCIDENTAL ITEMS.

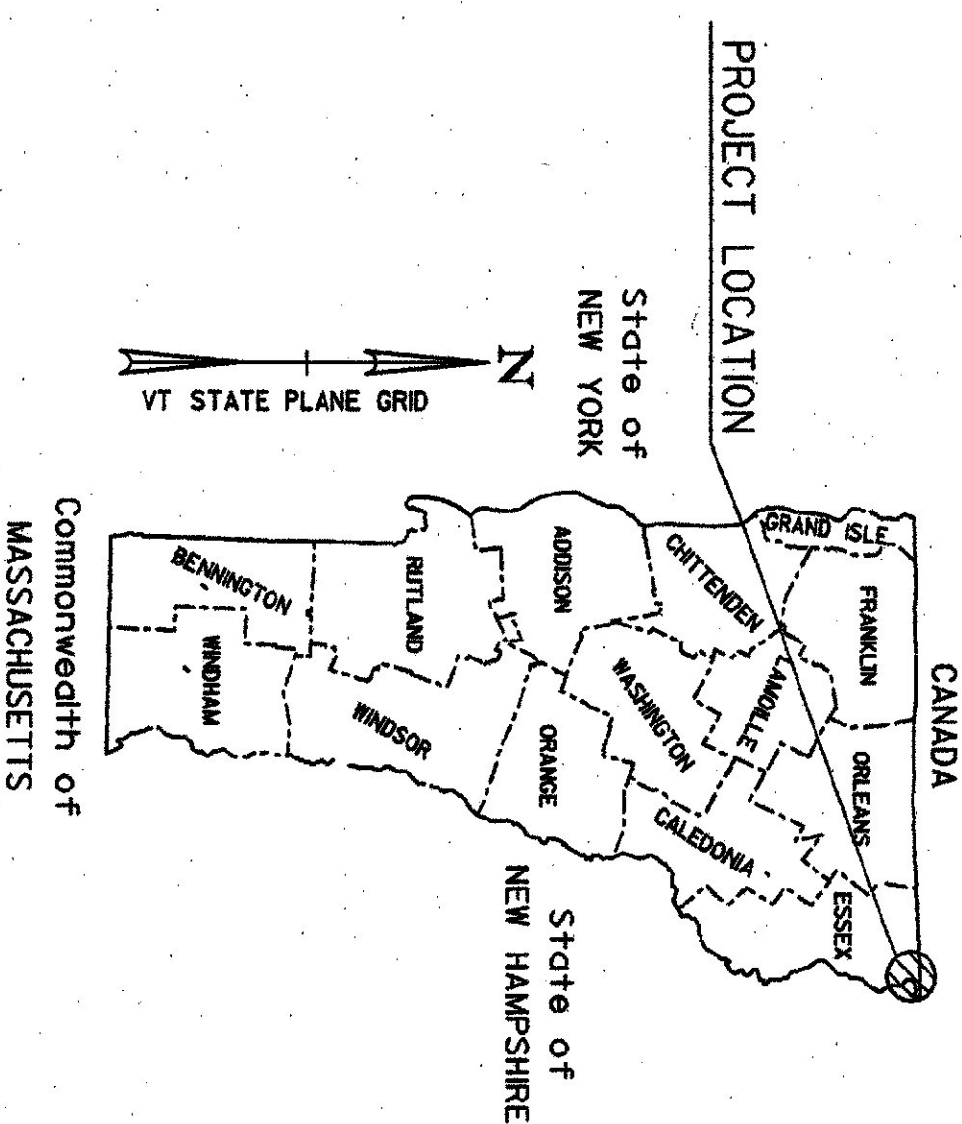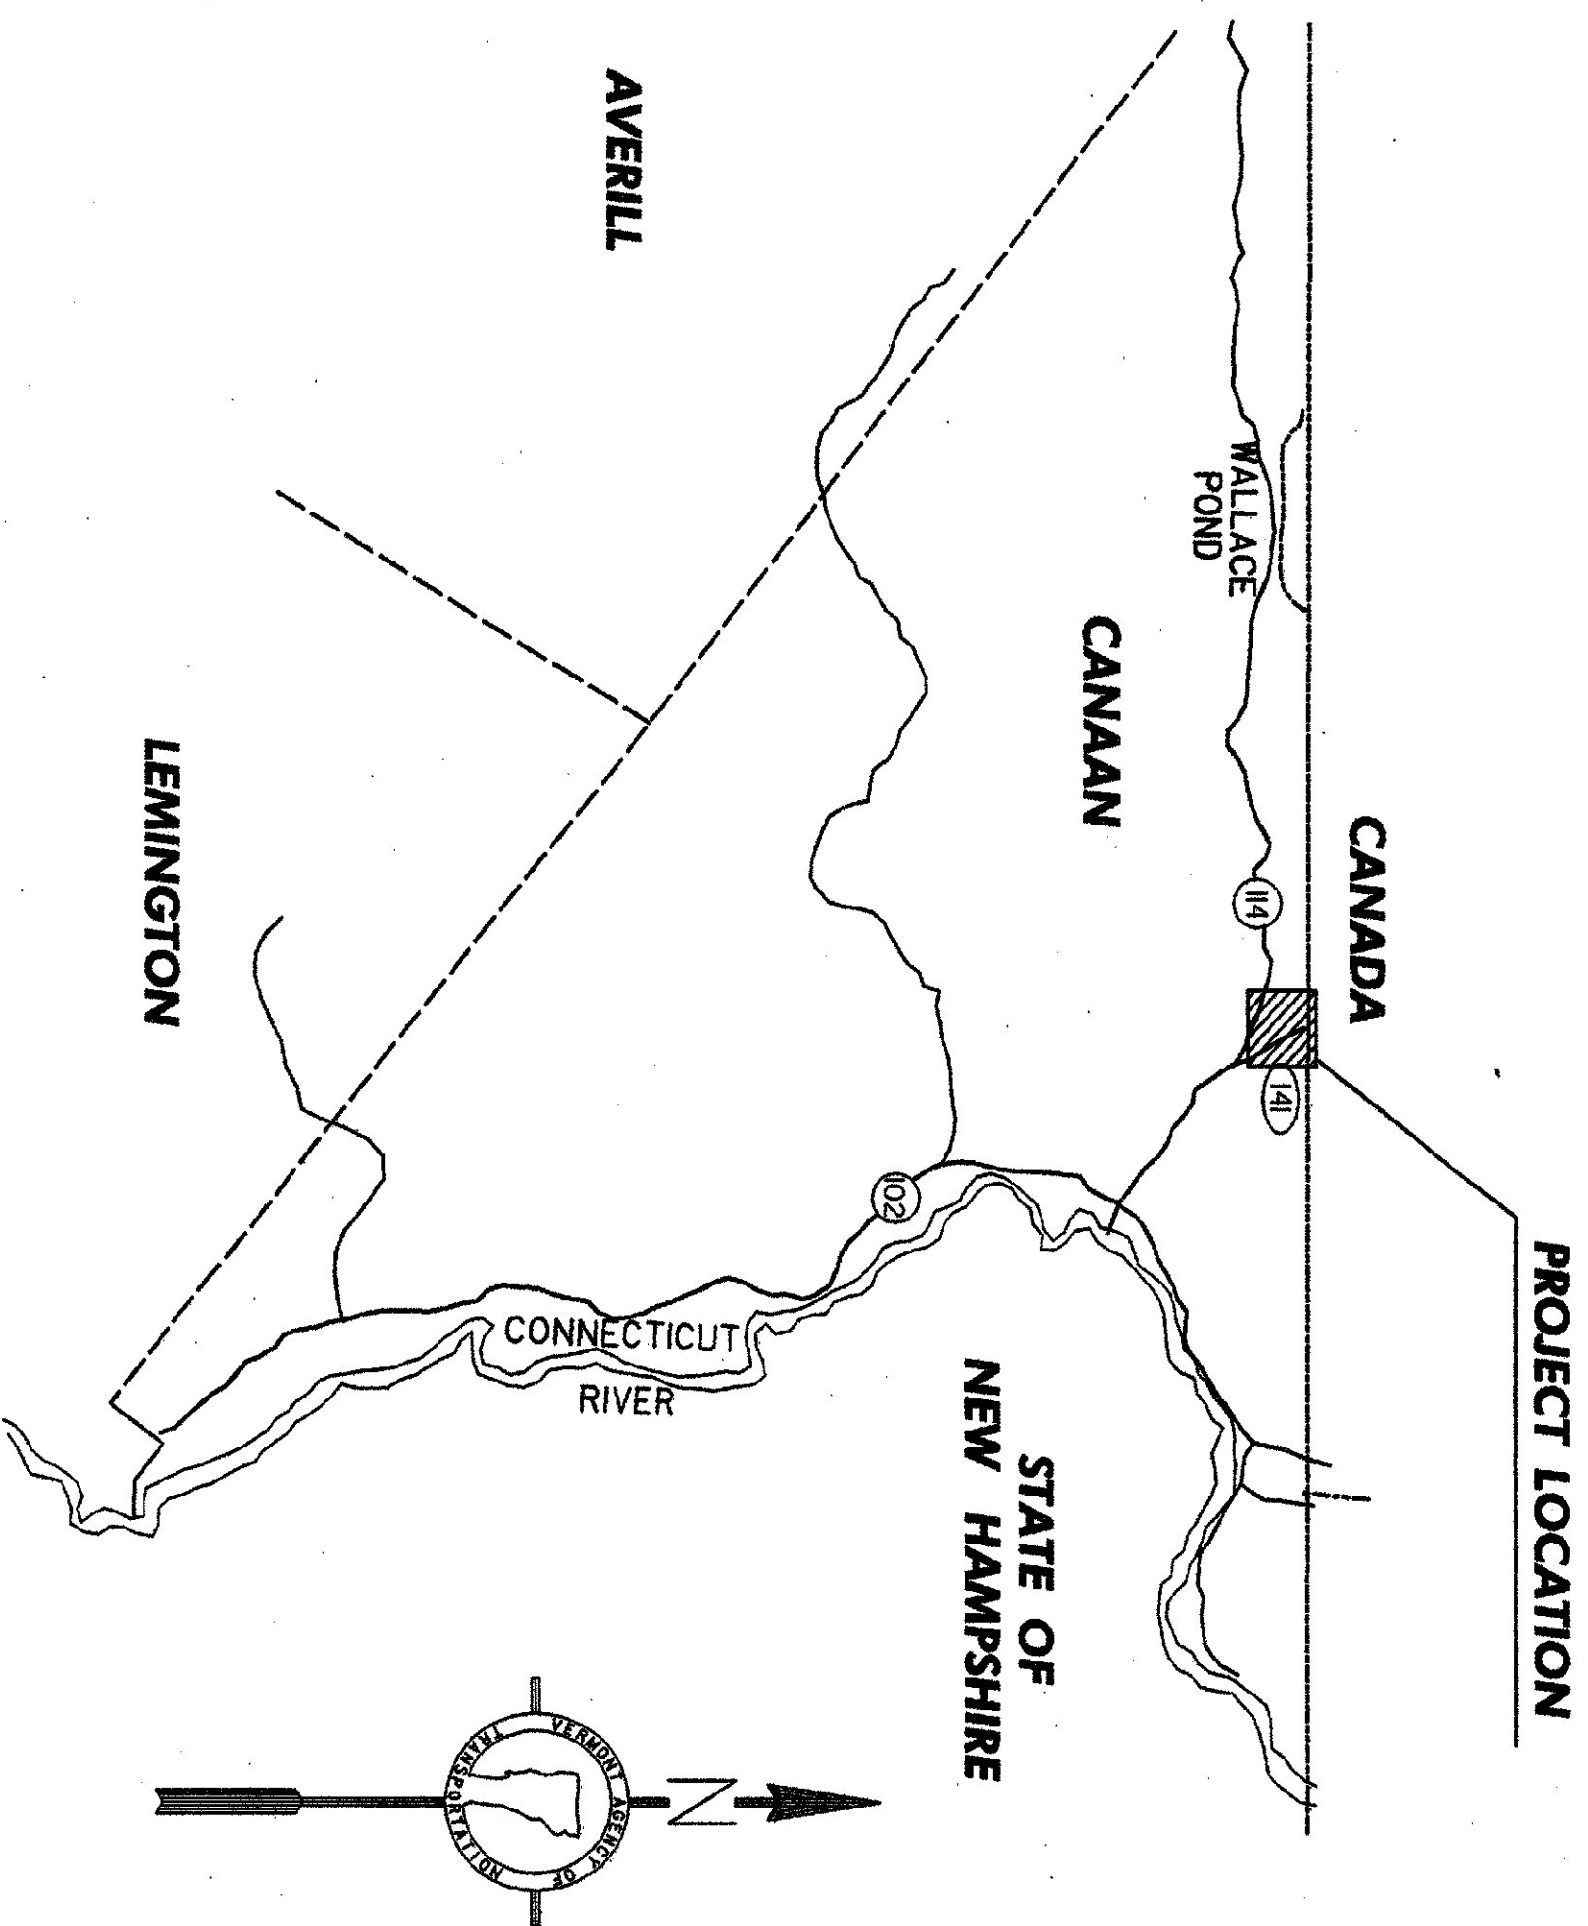

ARCHIVED  
IN DPR

THESE PLANS ARE SUBJECT TO SUCH ENGINEERING CHANGES AS MAY BE REQUIRED BY THE CHIEF ENGINEER. CONSTRUCTION IS TO BE CARRIED ON IN ACCORDANCE WITH THESE PLANS AND THE STANDARD SPECIFICATIONS FOR CONSTRUCTION DATED 1990, AS APPROVED BY THE FEDERAL HIGHWAY ADMINISTRATION ON MARCH 15, 1990 FOR USE ON THIS PROJECT, INCLUDING ALL SUBSEQUENT REVISIONS AND SUCH REVISED SPECIFICATIONS AND SPECIAL PROVISIONS AS ARE INCORPORATED IN THESE PLANS.

APPROVED: *[Signature]* DATE: 9/10/99  
DIRECTOR OF PROJECT DEVELOPMENT  
PROJECT: CANAAN STP SA17(3)S  
SHEET 1 OF 6 SHEETS



DATUM  
VERTICAL  
HORIZONTAL

