
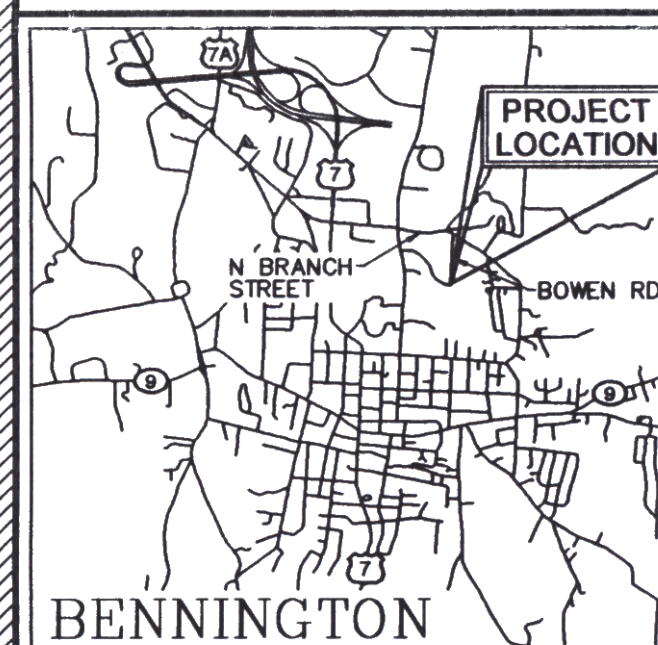


SITE ENGINEER:  
  
**CIVIL ENGINEERING ASSOCIATES, INC.**  
 P.O. BOX 485 SHELBURNE, VT 05482  
 802-885-2323 FAX: 802-885-2271 web: www.cesvt.com  
 COPYRIGHT © 2002 - ALL RIGHTS RESERVED

DRAWN  
**PJM**  
 CHECKED  
**BCE**  
 APPROVED  
**BCE**

OWNER:  
**TOWN OF BENNINGTON**  
 205 SOUTH STREET  
 P.O. BOX 469  
 BENNINGTON, VERMONT

PROJECT:  
**BENNINGTON DRAINAGE and UTILITY IMPROVEMENTS**  
 DISTRICT 1 OFFICE/GARAGE  
 BENNINGTON, VERMONT



**LOCATION MAP**  
 1" = ±1 MILE

DATE	CHECKED	REVISION

**AS-BUILT PLAN**

DATE  
 1/6/2005  
 SCALE  
 1" = 20'  
 PROJ. NO.  
 03146.01  
 DRAWING NUMBER  
**AB1**

- LEGEND**
- 336--- EXISTING CONTOUR
  - APPROXIMATE PROPERTY LINE
  - OE--- OVERHEAD ELECTRIC
  - ST--- STORM DRAINAGE LINE
  - W--- WATER LINE
  - W--- ABANDONED WATER LINE
  - POWER POLE
  - CATCH BASIN
  - LIGHT POLE
  - ☼ CONIFEROUS TREE
  - DECIDUOUS TREE
  - CHAIN LINK FENCE
  - +680.91--- DRAINAGE SWALE
  - SPOT ELEVATION

NOTES:  
 1. Underground utilities shown hereon are based on utility evidence visible at ground surface and are subject to field verification by excavation. Utilities shown do not purport to constitute or represent all utilities located upon or adjacent to the surveyed premises. All discrepancies shall be reported to the Engineer. The Contractor shall contact Dig Safe (800-225-4977) prior to any construction.  
 2. Waterline as-built information provided by the installation contractor and/or VTrans.

