

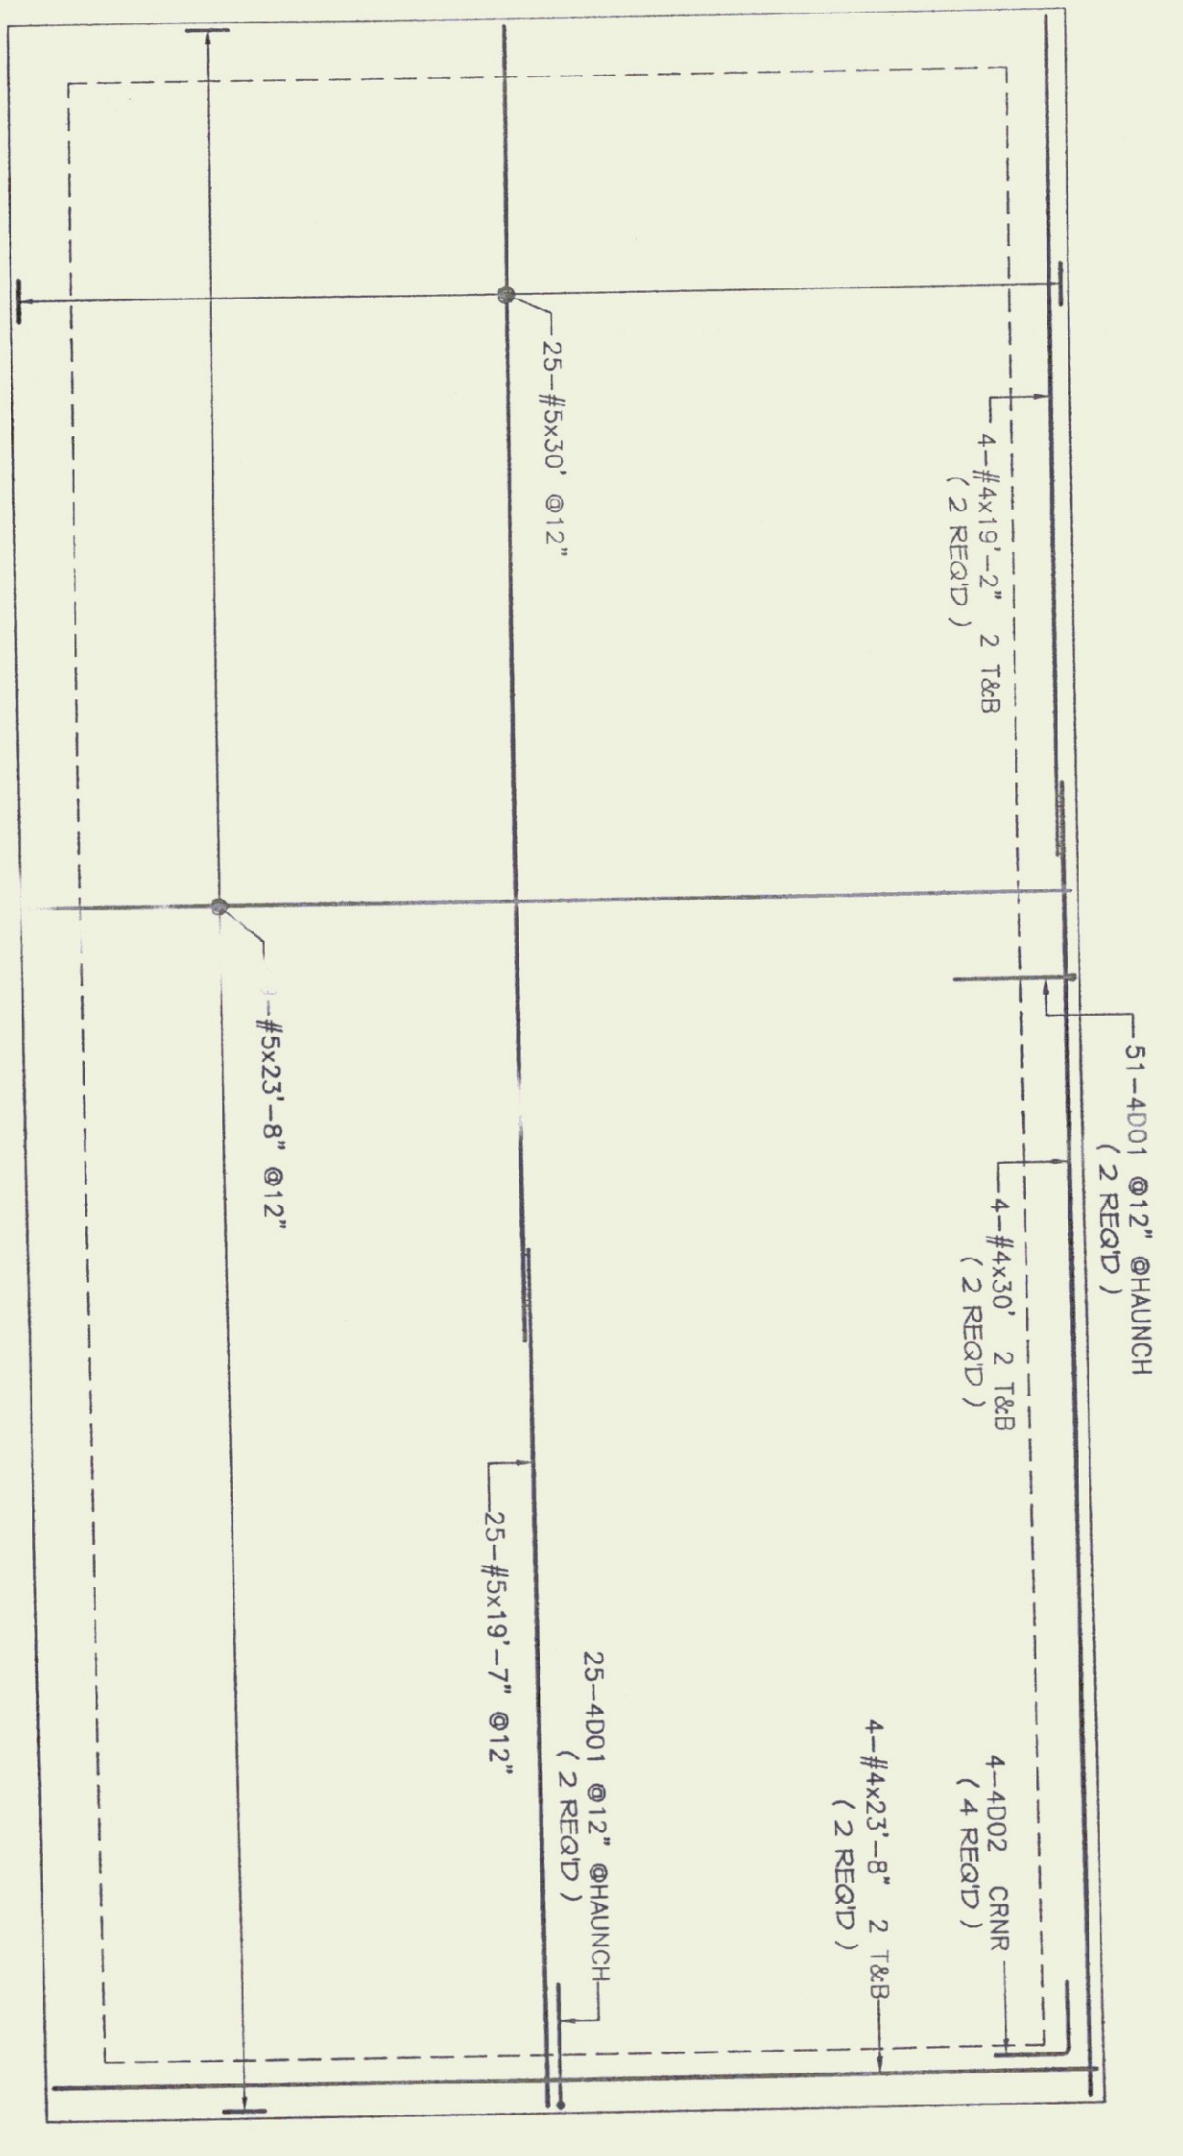


Release Code: SHED SLAB


Rev	Max	On	Scale	Revised	By	Check	Date
001	10/14	10/14	3/8" X 1/4"	10/14	10/14	10/14	10/14
002	11/14	11/14	3/4" X 1/4"	11/14	11/14	11/14	11/14

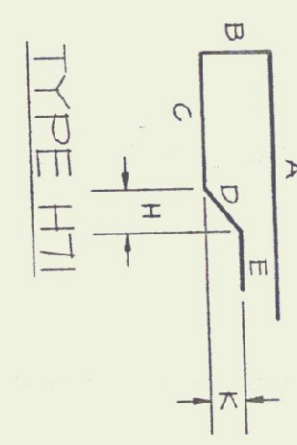

SHED SLAB ON GRADE REINFE PLAN

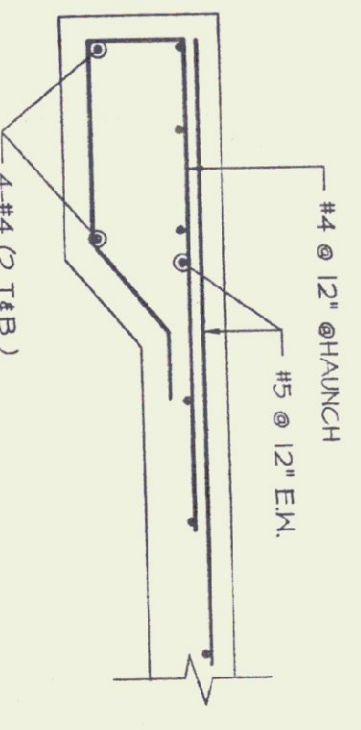

TYP. SLAB SECTION

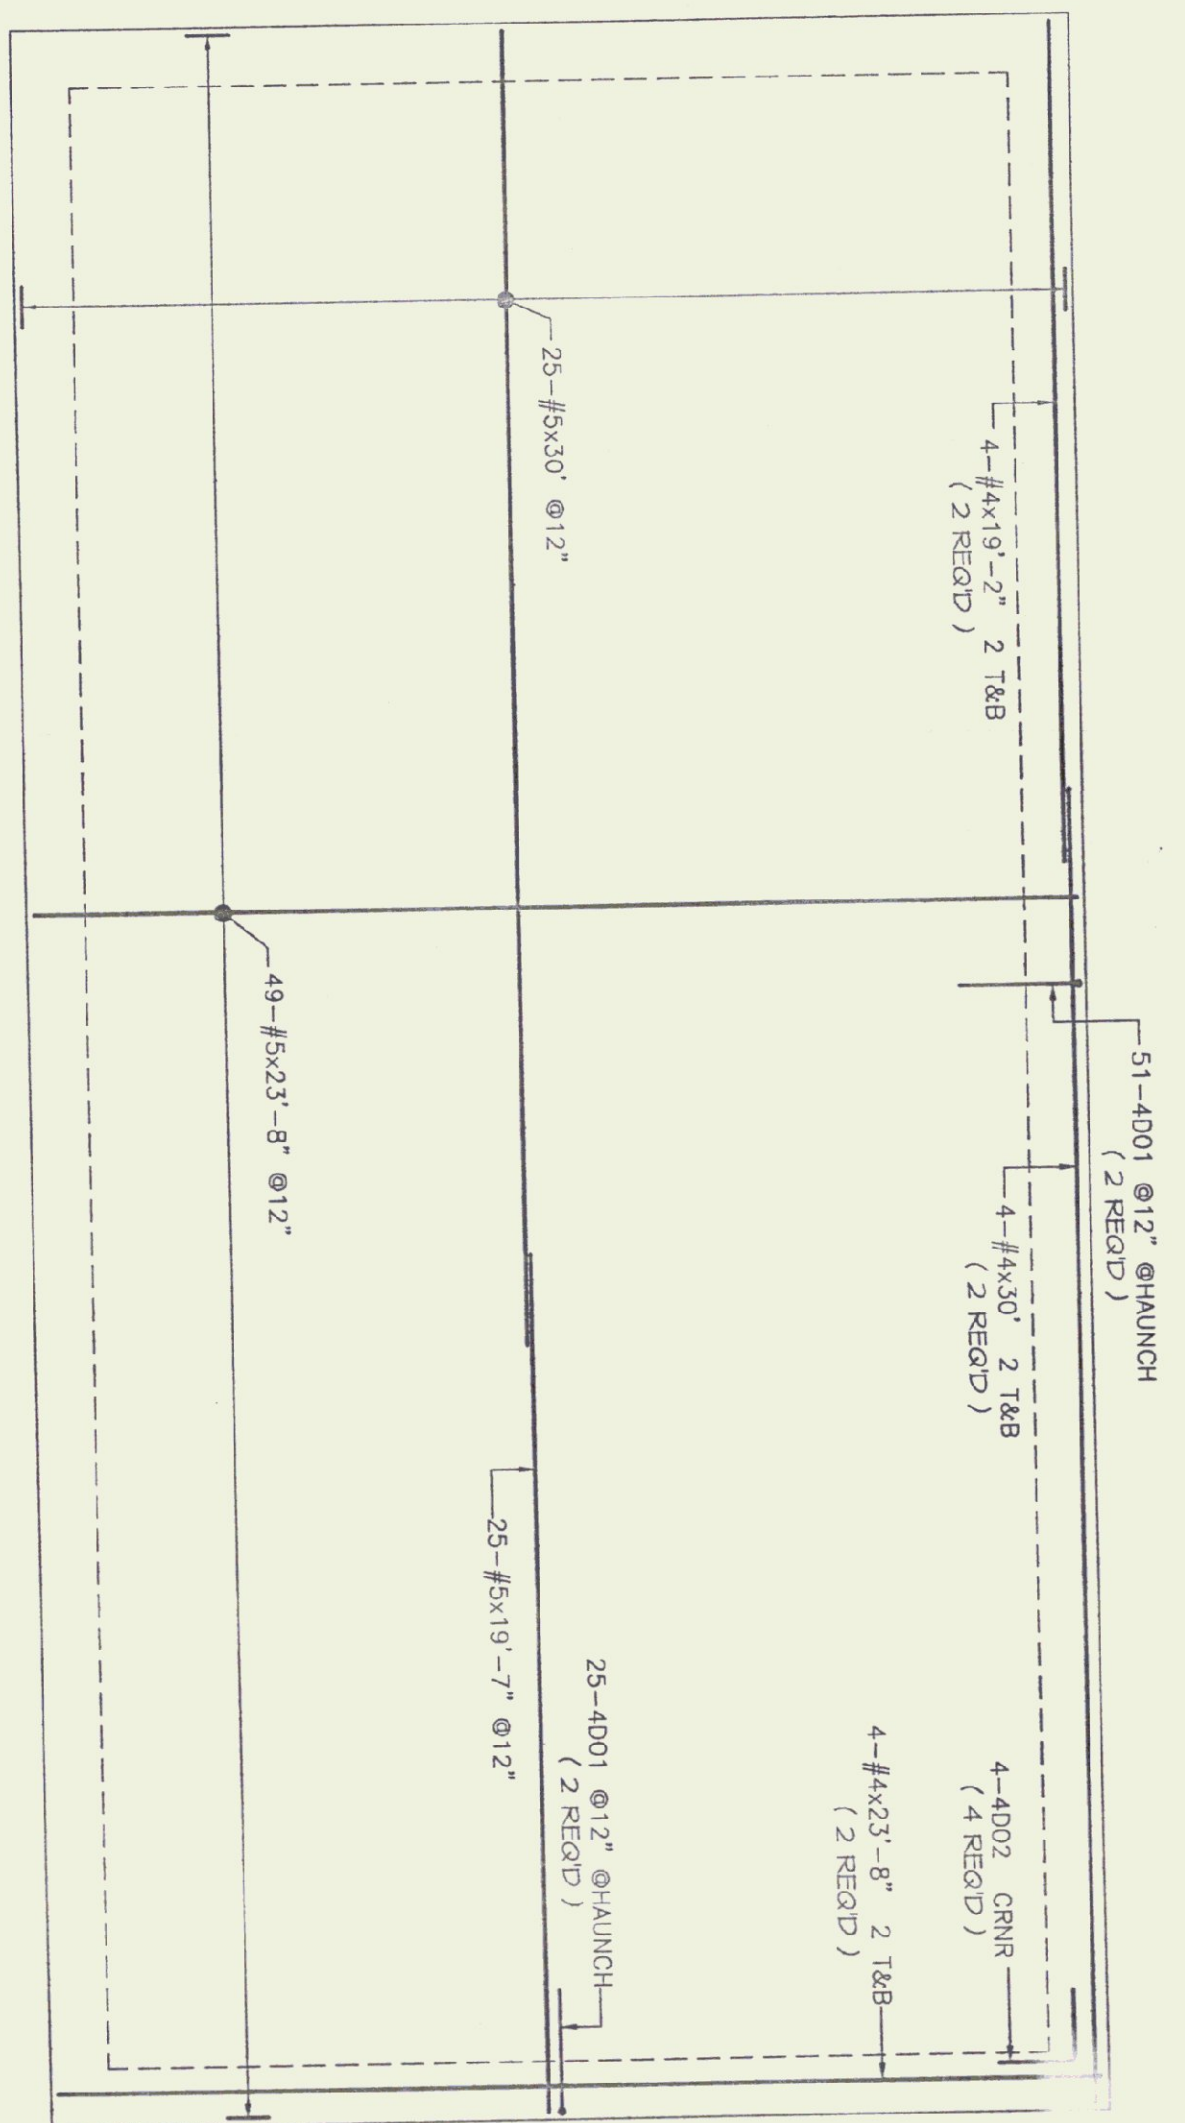

SHED SLAB ON GRADE REINFE PLAN

VERMONT STATE BUILDINGS DIVISION
 MONTPELIER, VERMONT
 JOB: *Lebanon & Breen Builders*
 4 APPROVED AS CORRECTED
 3 NOT APPROVED
 2 REVISE AND RESUBMIT
 1 STOP DRAWING APPROVAL IS GRANTED AND ONLY FOR CONFIRMATION WITH THE DESIGN CONCEPT OF THE PROJECT. APPROVAL SHALL NOT RELIEVE CONTRACTOR OF RESPONSIBILITY FOR ADEQUACY OF CONTRACT DOCUMENTS FOR PERMITS, ORDINANCES, ETC.
 BY: *[Signature]*
 DATE: *June 29, 1995*

DATE	REV	DESCRIPTION	DATE	RECORD & JOB USE
6-6-94	1	DATE REVISION #002 FROM REV	6-6-94	APPROVAL
			4-28-94	SENT FOR

BARKER STEEL CO., INC.

REFERENCE DWG.

NOTICE

REINFORCING BARS 60
 ANGLE IRON 40
 LAP ALL CONTIGUOUS BARS 40
 #3 = #6 = #9 =
 #4 = #7 = #10 =
 #5 = #8 = #11 =

Legend:
 IF Inside Face
 OF Outside Face
 NE Near Face
 FF Each Face

Vertical
 Horizontal
 Each Way
 Bottom
 Top
 Support Bars

LEBANON

MAINTENANCE GARAGE & SHEDS
 OFF RTE 100
 LUDLOW, VT.

STATE OF VT-AOT
 NAYLOR & BREEN BUILDERS
 Drawn By: *JEANAL*
 Date: 4-28-94
 Reviewed By: *[Signature]*
 Job No. 05930444

SHED SLAB REINFE.
 Drawing no. R02