


State of Vermont
 Department of Buildings & General Services
5-BAY MAINTENANCE GARAGE
 SALT/SAND SHEDS & STORAGE SHED
 Ludlow, Vermont

AS-BUILTS
 DECEMBER 1999


AGENCY OF ADMINISTRATION
 DEPT. OF BUILDINGS & GENERAL SERVICES
 2 GOVERNOR AIKEN AVENUE
 MONTPELIER, VERMONT 05633-5801
 THOMAS W. TORTI, COMMISSIONER

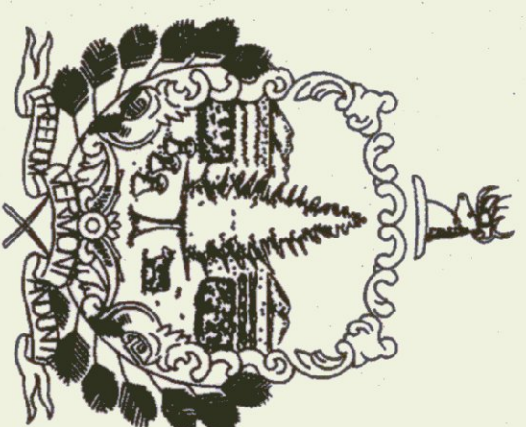

Howard Dean, M.D.
 Governor

MARCH 1999

TO PLYMOUTH

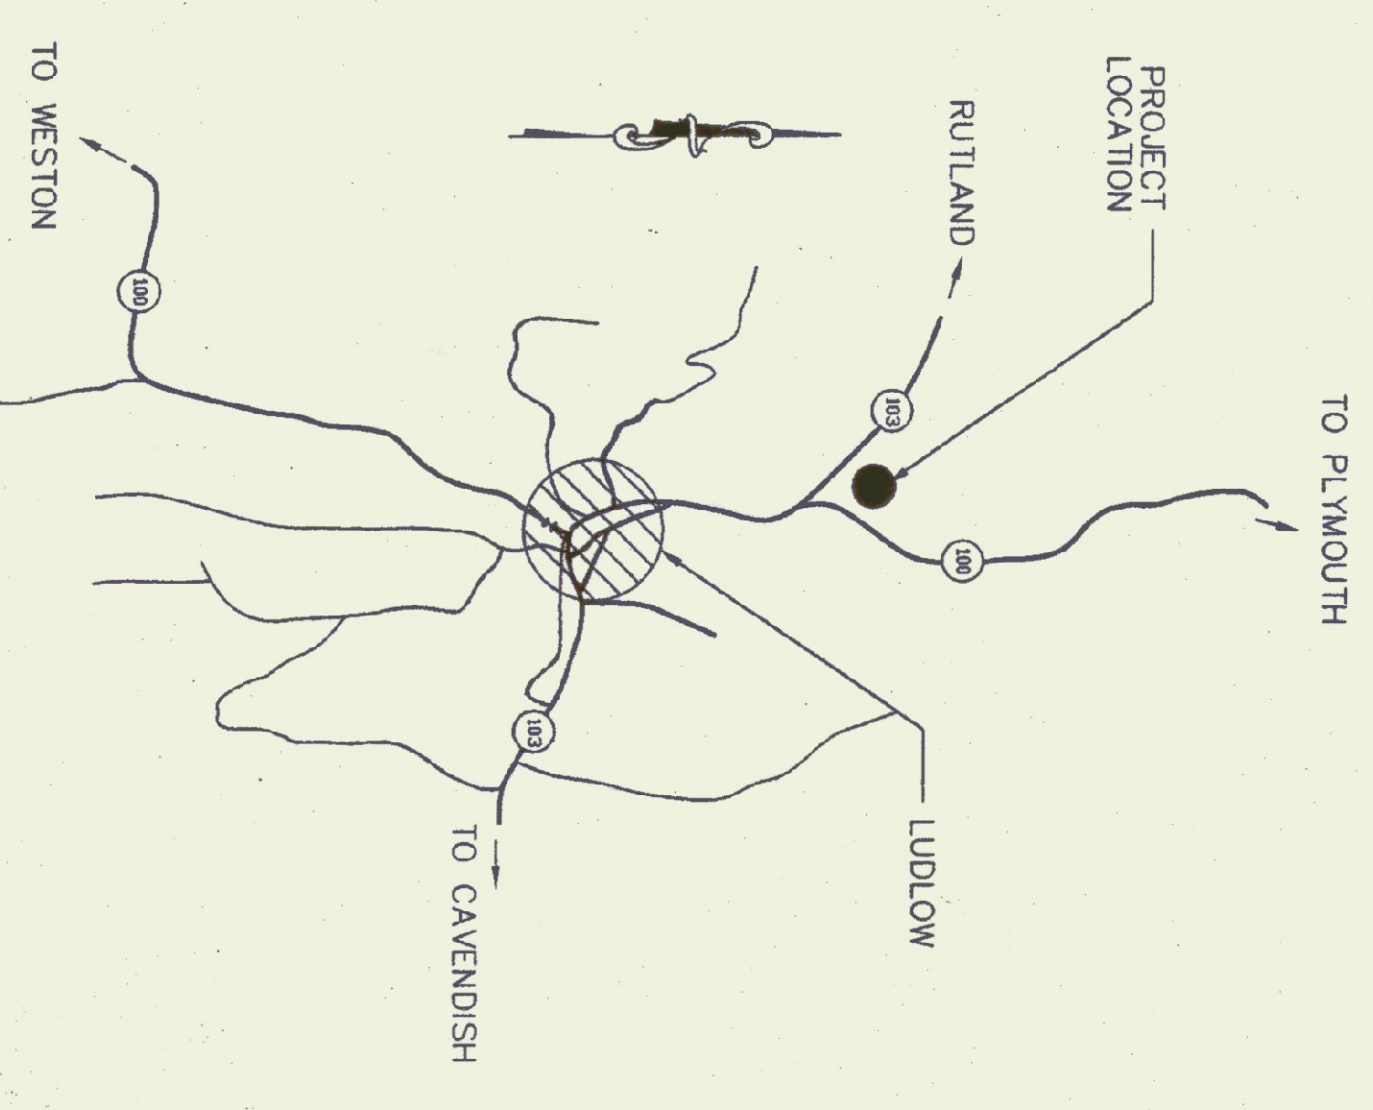

AGENCY OF TRANSPORTATION
 133 STATE STREET
 MONTPELIER, VERMONT 05633-5001
 GLENN GERSHANECK, SECRETARY

INDEX OF SHEETS

R-1	SITE PLAN
WS-1	WATER & SEWER PLAN
WS-2	WATER & SEWER DETAILS
G-1	GRADING PLAN
G-2	ACCESS ROAD & CENTERLINE PROFILE
G-3	ACCESS ROAD & CROSS SECTIONS
G-4	ACCESS ROAD & CROSS SECTIONS
G-5	ACCESS ROAD & CROSS SECTIONS
G-6	ACCESS ROAD & CROSS SECTIONS
G-7	ACCESS ROAD & CROSS SECTIONS
G-8	ACCESS ROAD & CROSS SECTIONS
G-9	ACCESS ROAD & CROSS SECTIONS
G-10	ACCESS ROAD & CROSS SECTIONS
G-11	GRADING & STORM WATER DETAILS
F-1	FUEL TANK
A-1	FIRST FLOOR/MEZZANINE PLANS & SECTIONS
A-2	GARAGE ELEVATIONS
A-3	INTERIOR & CHIMNEY SECTIONS/ELEVATIONS
A-4	WALL PLANS & SECTIONS
A-5	WALL SECTIONS, ROOF PLAN & SCHEDULES
A-6	DOOR, WINDOW & STAIR DETAILS
S-1	FOUNDATION PLANS & SECTIONS
S-2	STRUCTURAL STEEL FRAMING AT ROOF
S-3	STEEL SECTIONS & CONCRETE DETAILS
SS-1	SAND TRAP PLAN, SECTION & DRAINAGE PLAN
SS-1	40' X 84' SALT SHED/SAND SHED
SB-1	24' X 48' STORAGE BUILDING
P-1	PLUMBING PLAN
M-1	MECHANICAL PLAN & SECTIONS
M-2	MECHANICAL PLAN & SECTIONS
E-1	POWER & LIGHTING PLAN

PROJECT LOCATION