


STATE OF VERMONT
AGENCY OF TRANSPORTATION
SALT AND SAND SHED
MENDON, VERMONT

MAY 8, 1995



AGENCY OF ADMINISTRATION
DEPARTMENT OF STATE BUILDINGS
2 GOVERNOR AIKEN AVENUE
MONTPELIER, VERMONT 05602
JOHN J. ZAMPIERI, COMMISSIONER

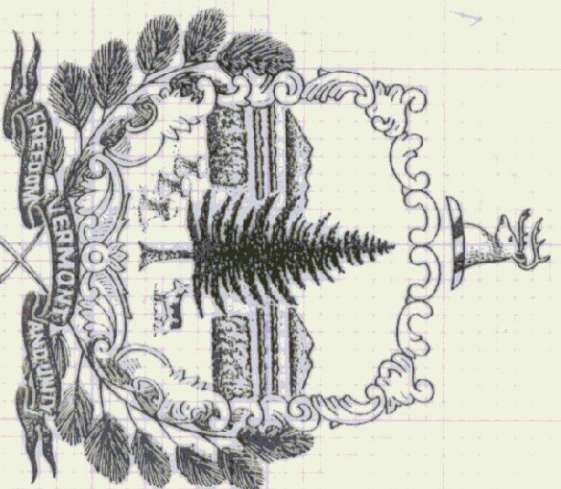

GOVERNOR HOWARD DEAN

AGENCY OF TRANSPORTATION
133 STATE STREET
MONTPELIER, VERMONT 05602
PATRICK J. GARAHAN, SECRETARY

INDEX OF DRAWINGS:
S-1 SITE PLAN
A-1 PLANS, ELEVATIONS,
SECTIONS & DETAILS

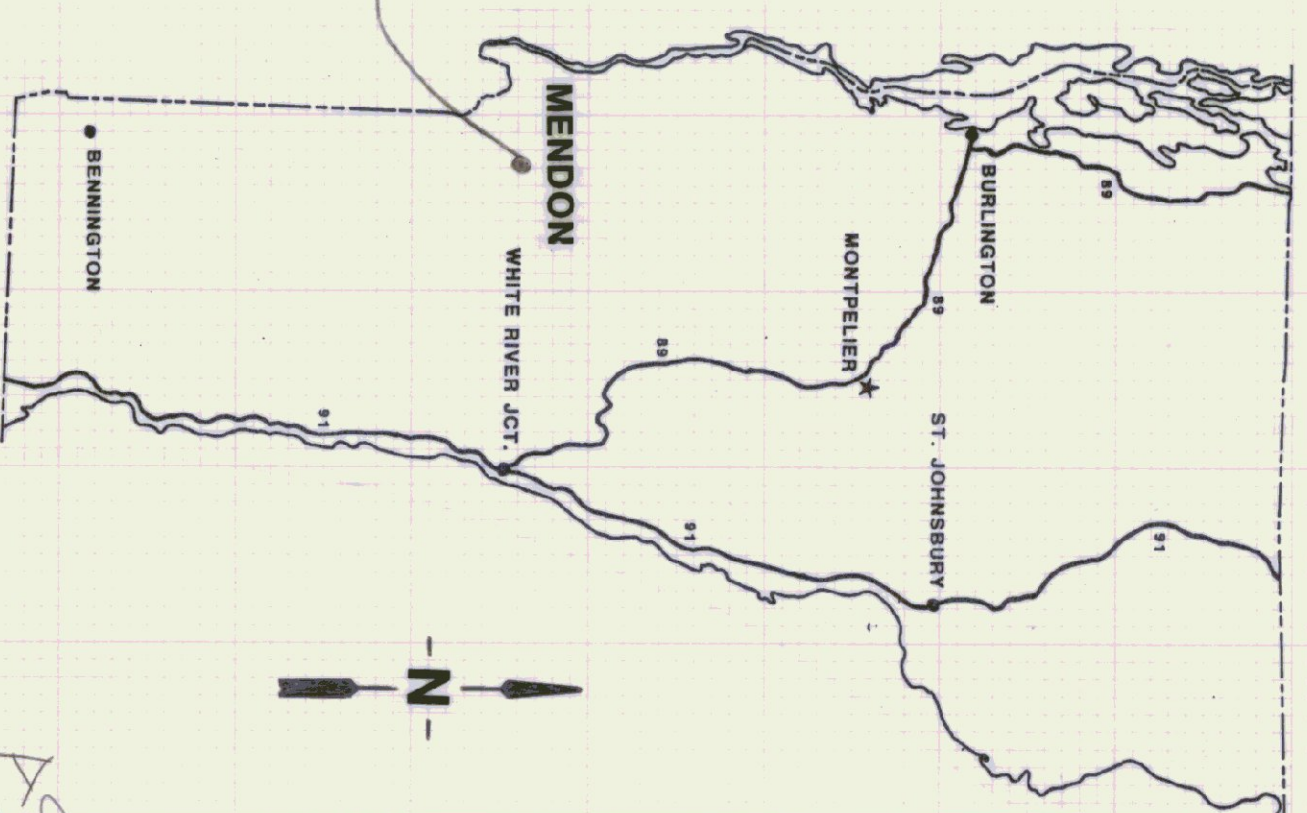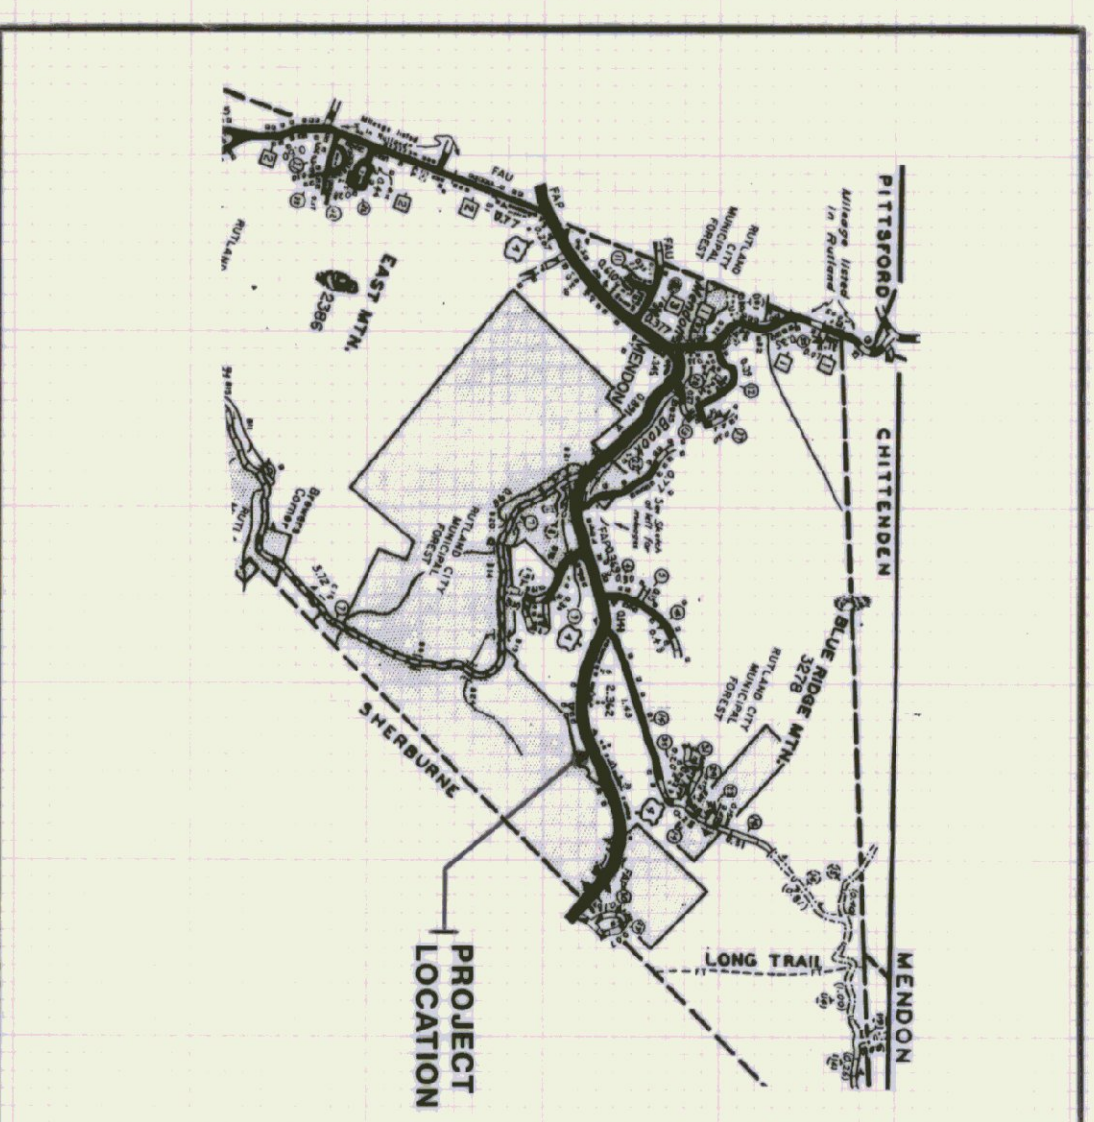

AS BUILT