


STATE OF VERMONT
AGENCY OF TRANSPORTATION
THREE BAY MAINTENANCE GARAGE
SUDBURY, VERMONT

AGENCY OF ADMINISTRATION
DEPARTMENT OF STATE BUILDINGS
2 GOVERNOR AIKEN AVENUE
MONTPELIER, VERMONT 05602
JOHN J. ZAMPIERI, COMMISSIONER

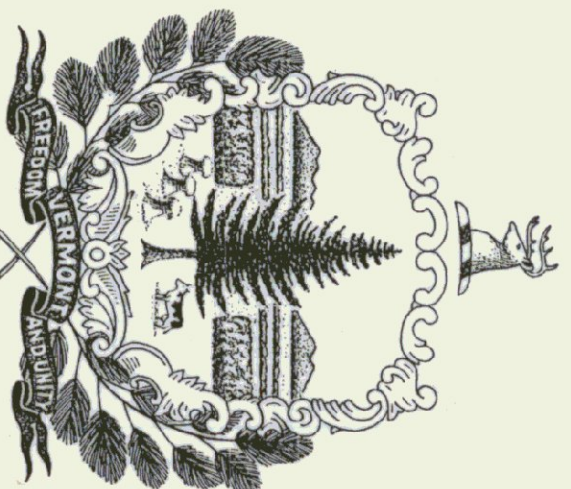


HOWARD DEAN, M.D.
GOVERNOR

AGENCY OF TRANSPORTATION
133 STATE STREET
MONTPELIER, VERMONT 05602
PATRICK J. GARAHAN, SECRETARY

APRIL 21, 1995

INDEX OF DRAWINGS

T-1	TITLE SHEET
SD-1	SITE PLAN
A-1	PLAN & SECTIONS OF 50' x 54' GARAGE
S-1	FOUNDATION PLAN & ELEVATION
M-1	MECHANICAL PLAN
E-1	ELECTRICAL PLAN
SS-1	40' X 64' SALT & SAND SHED
CSS-1	24' X 48' COLD STORAGE SHED

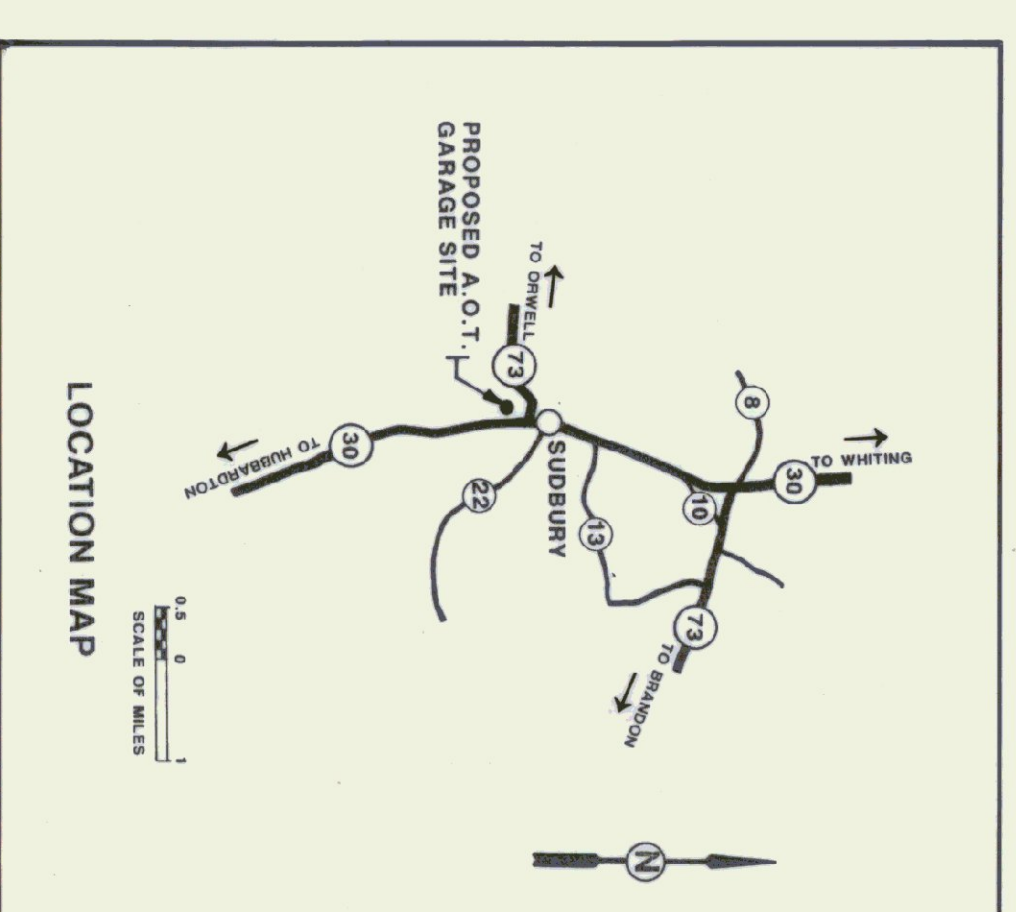

AS BUILT
01/22/96