


NOTE:
METAL CONTINUOUS
VENT AT RIDGE


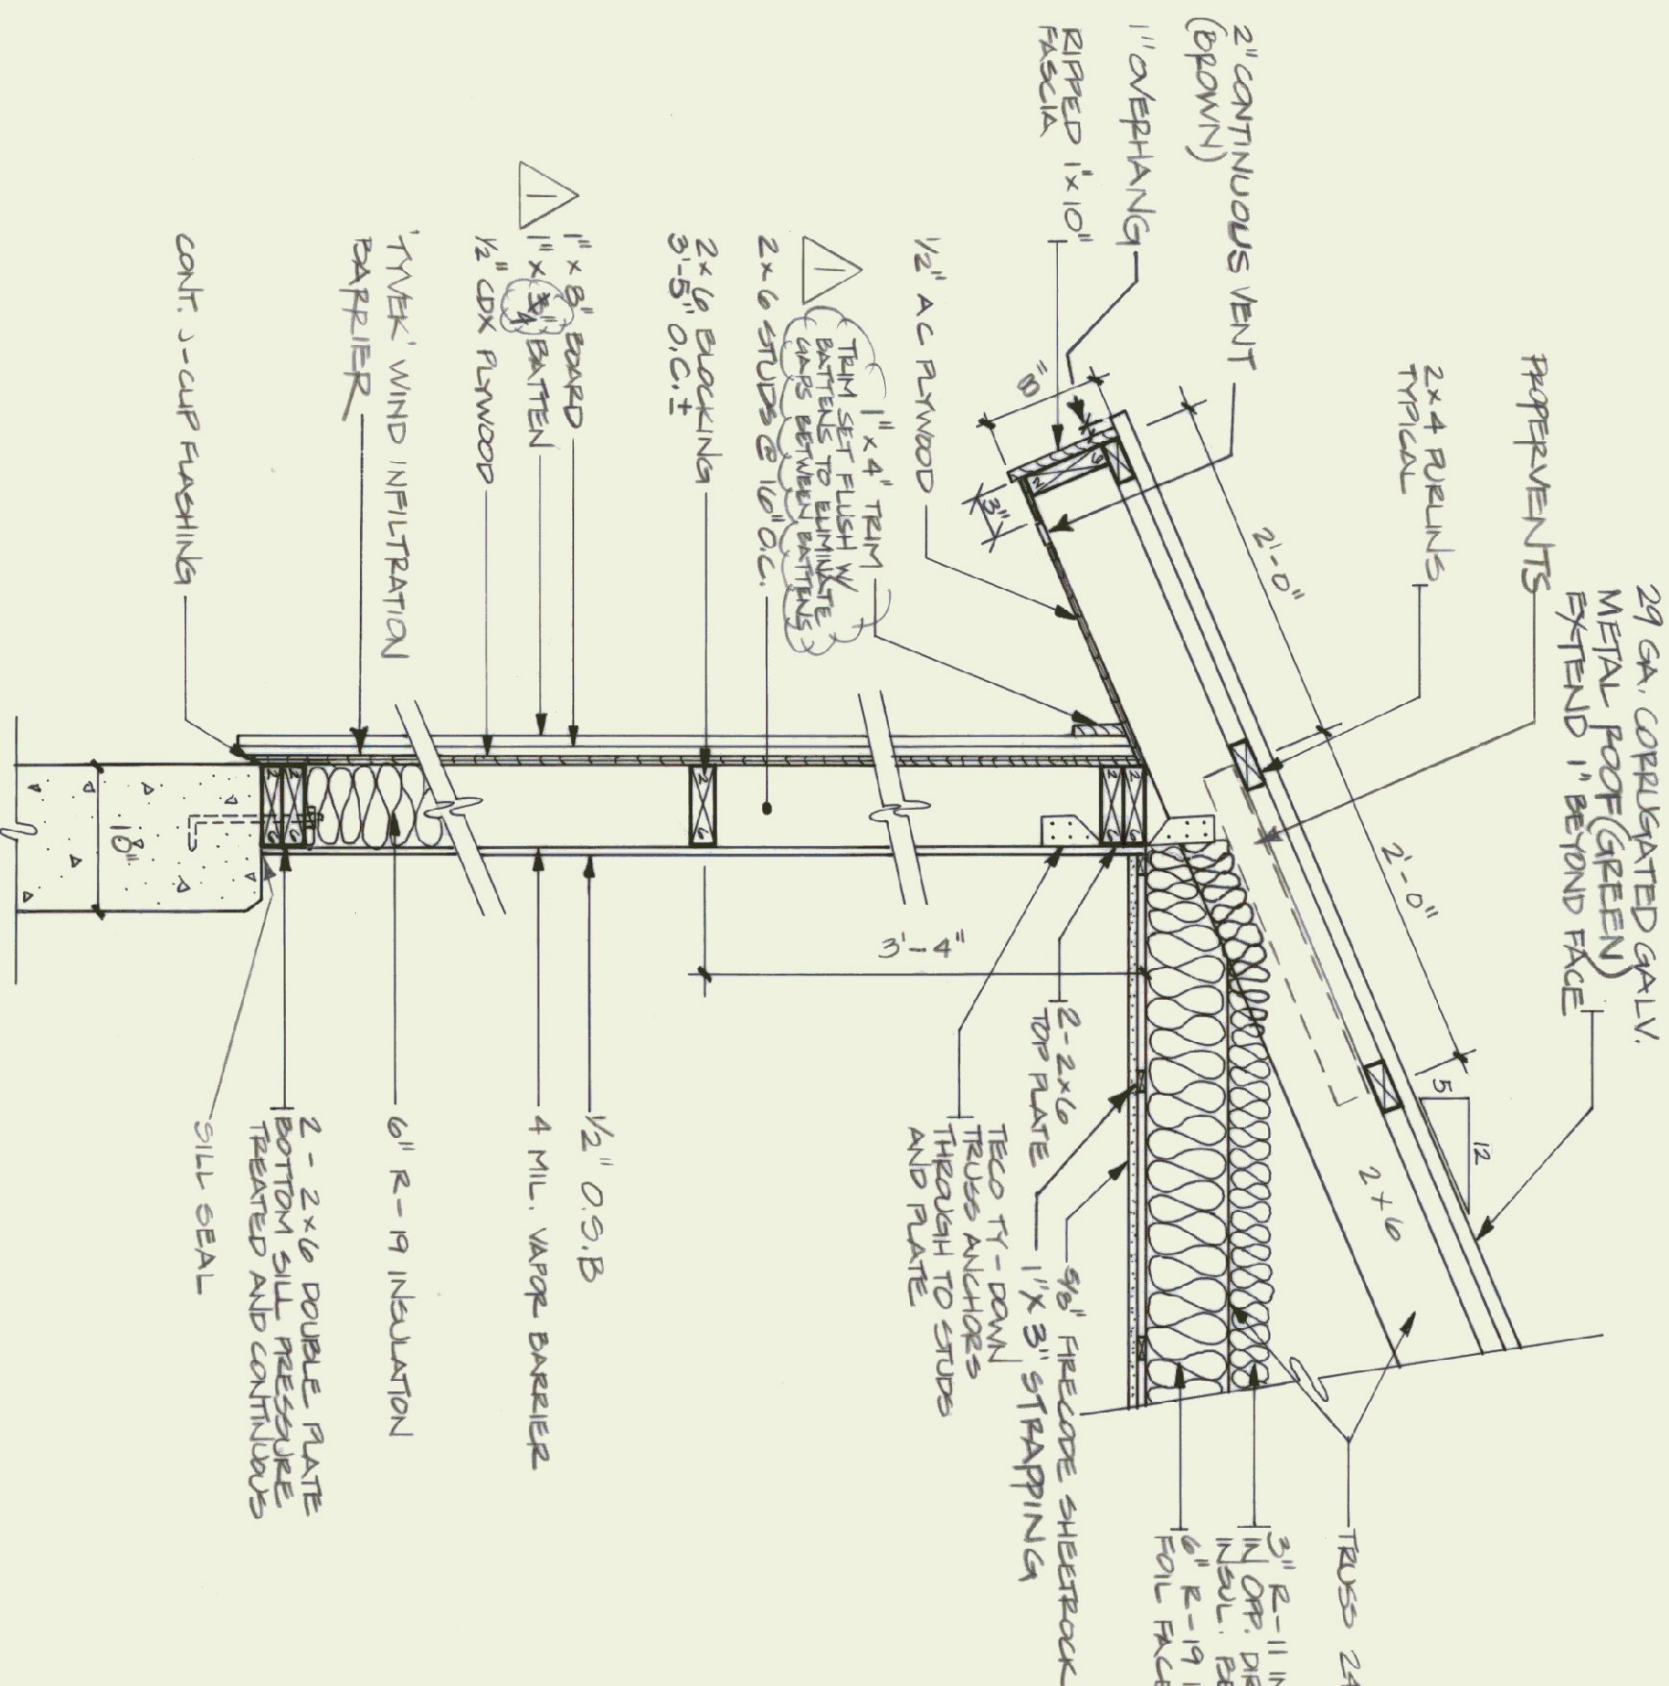


**SECTION A - A
WALL SECTION**
SCALE: 1" = 1'-0"


DOOR SCHEDULE										
NO	QTY	SIZE	TYPE	F. F.	MATERIAL	GLASS	BUTTS	HICKORY	CLOSER	REMARKS
1	1	3'-0" X 7'-0"	I	C	NEBL. MTL.	6/16\"/>				
2	1	3'-0" X 7'-0"	II	D	HOL. MTL.	6/16\"/>				
3	1	3'-0" X 7'-0"	III	C	"	"	"	"	"	"
4	3	14'-0" X 12'-0"	IV	C	NEBL. STEEL	ACRYLIC	"	"	"	"

WINDOW SCHEDULE


NO.	QTY	ROUGH OPENING	TYPE	REMARKS
A	3	3'-0" X 7'-0"	II	ACRYLIC GLASS, COMPLEMENTS 4000 SERIES SPACE
B	1	"	II	FROSTED

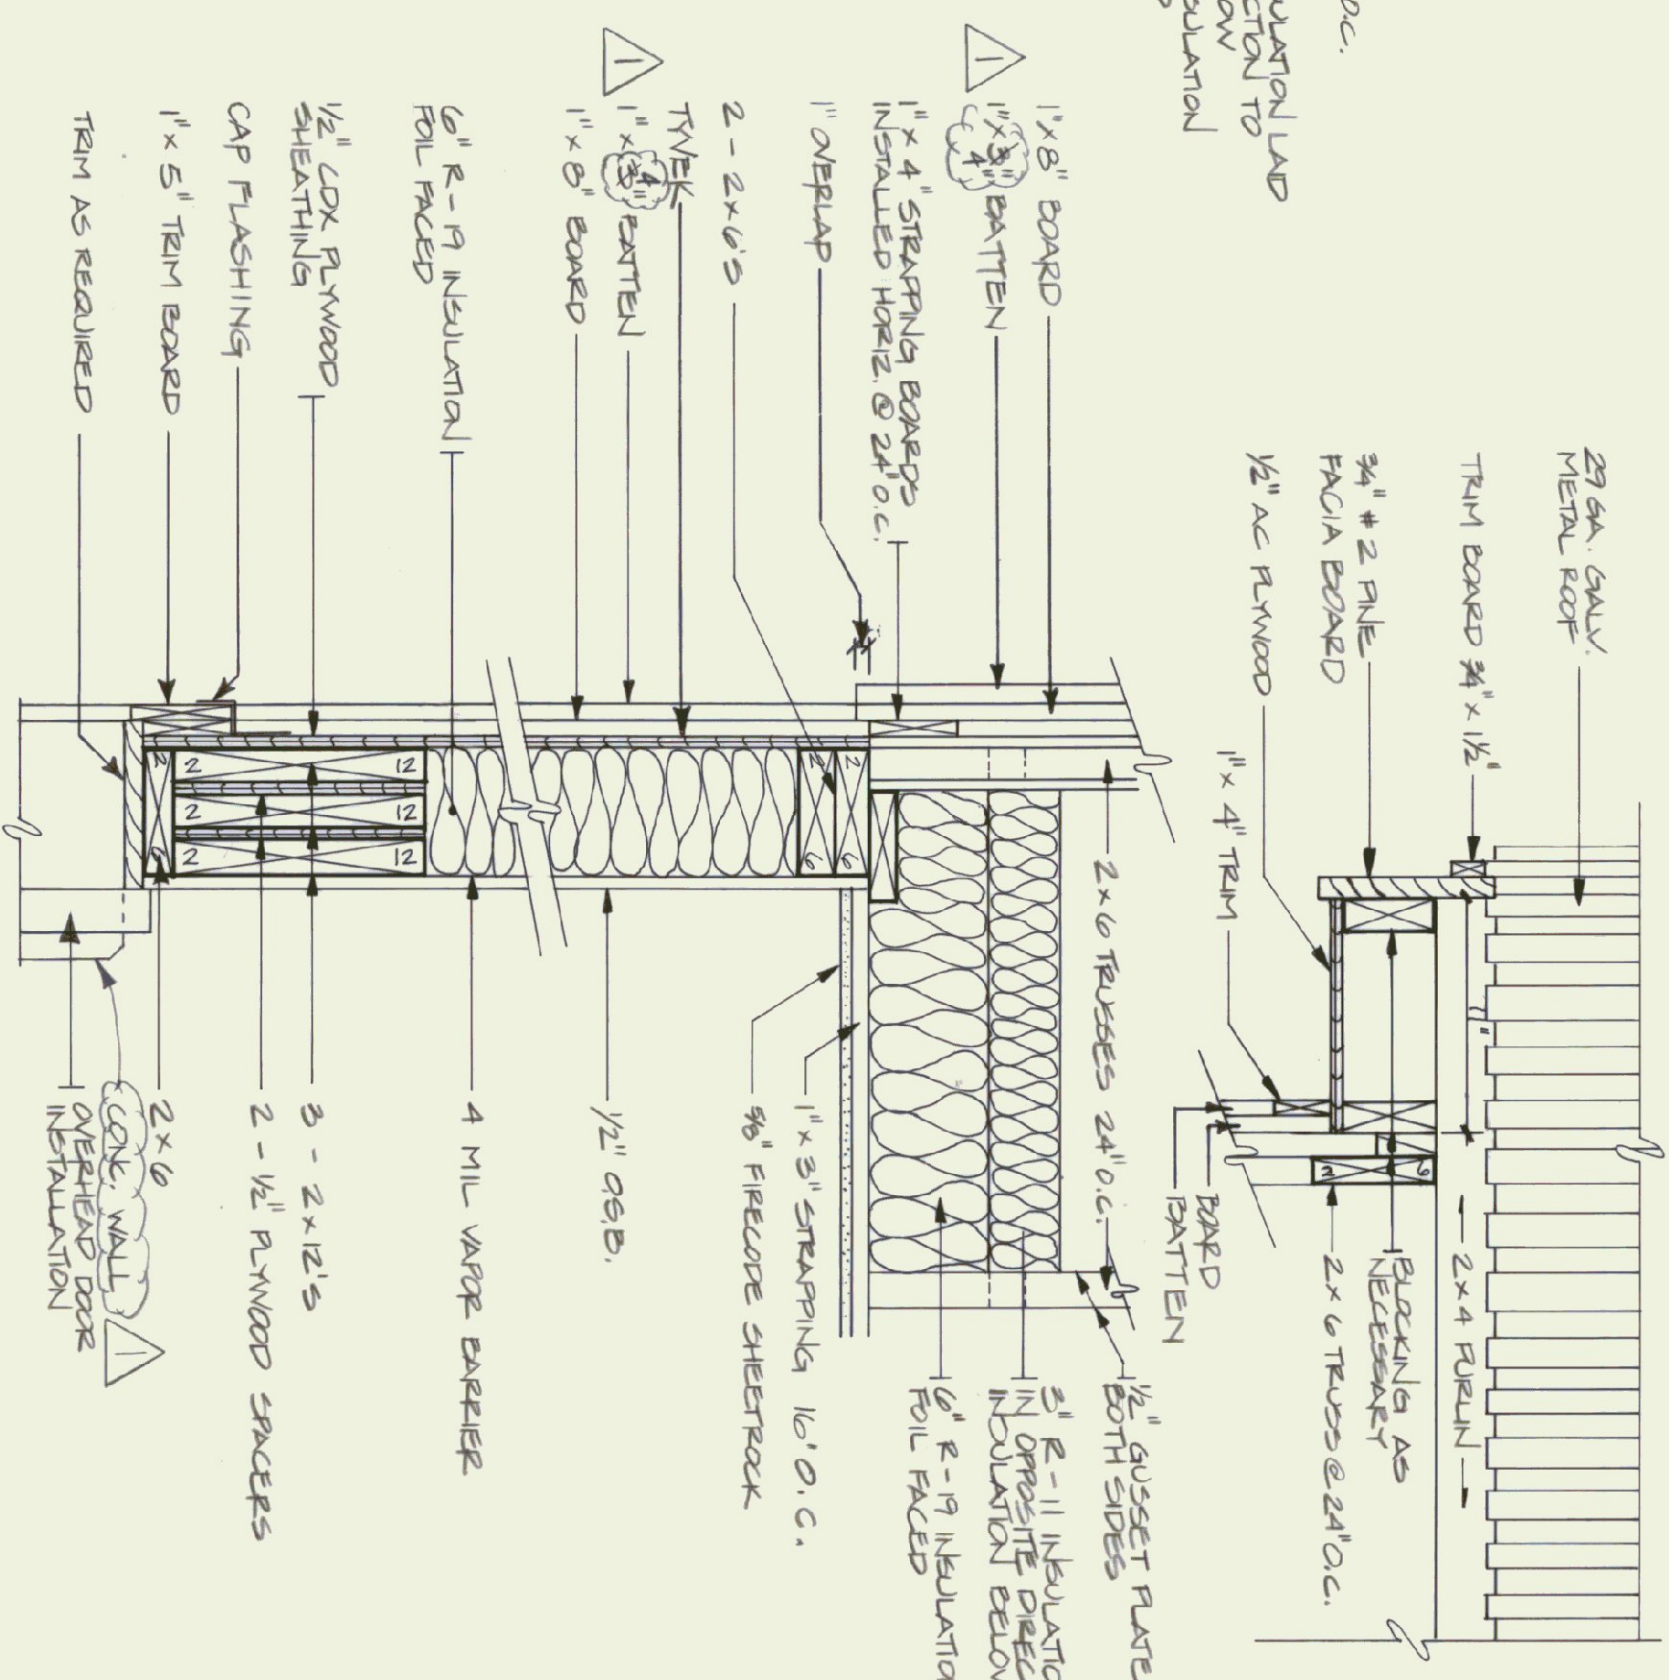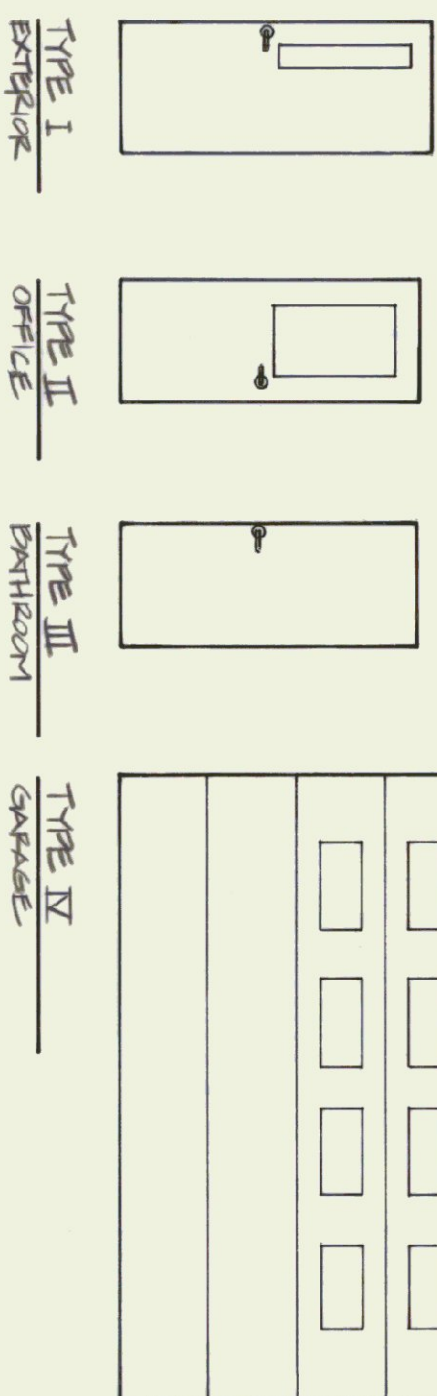


**SECTION B - B
HEADER DETAIL**
SCALE: 1 1/2" = 1'-0"

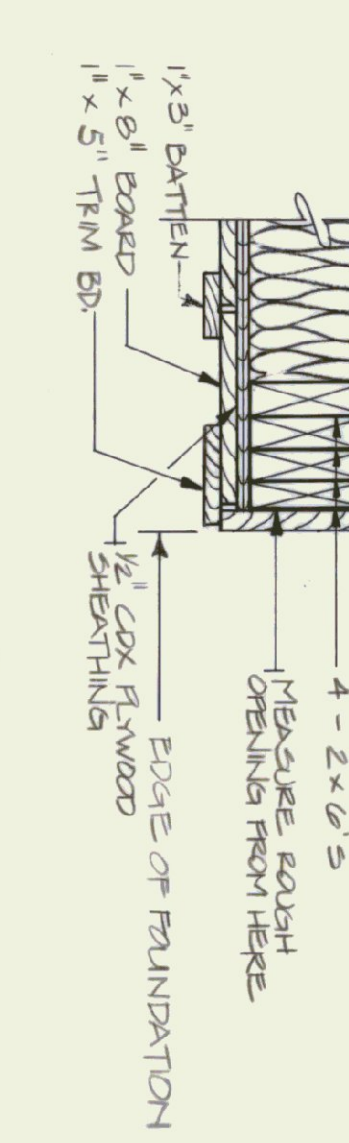


OVERHEAD DOOR JAMB
SCALE: 1 1/2" = 1'-0"

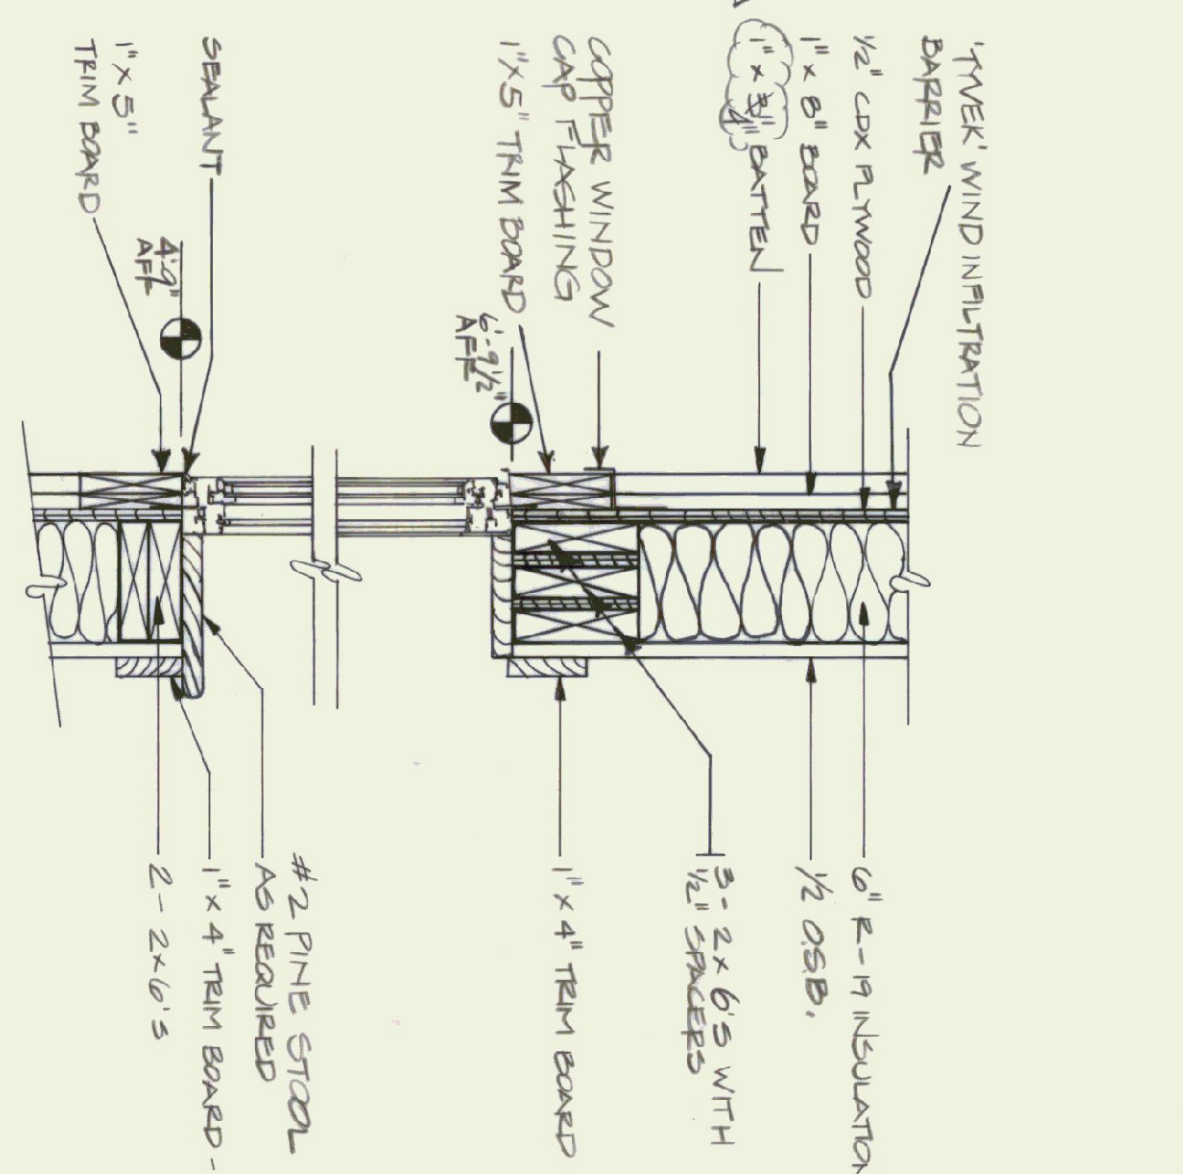

**SECTION C - C
WINDOW DETAIL**
SCALE: 1 1/2" = 1'-0"

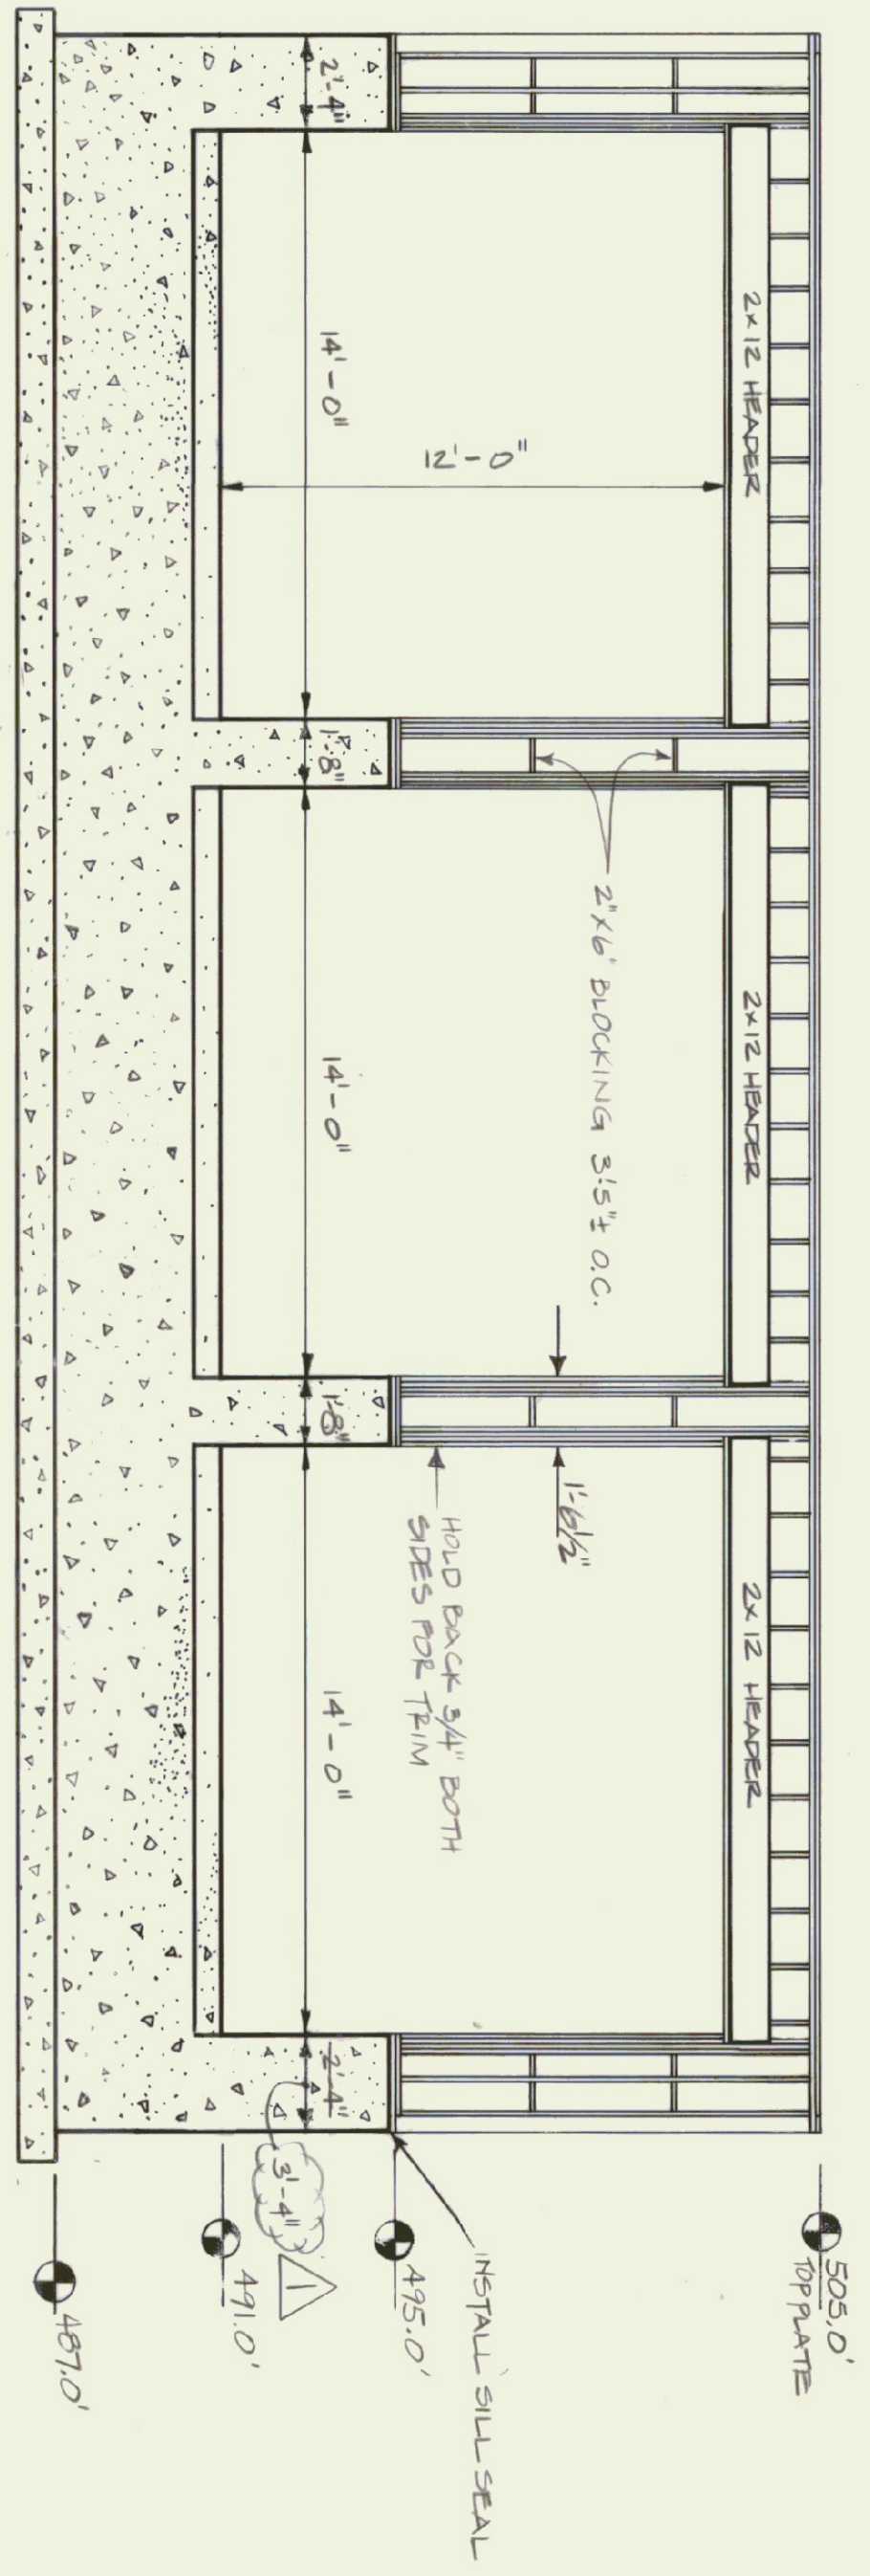

SECTION @ OVERHEAD DOOR
SCALE: 1/4" = 1'-0"

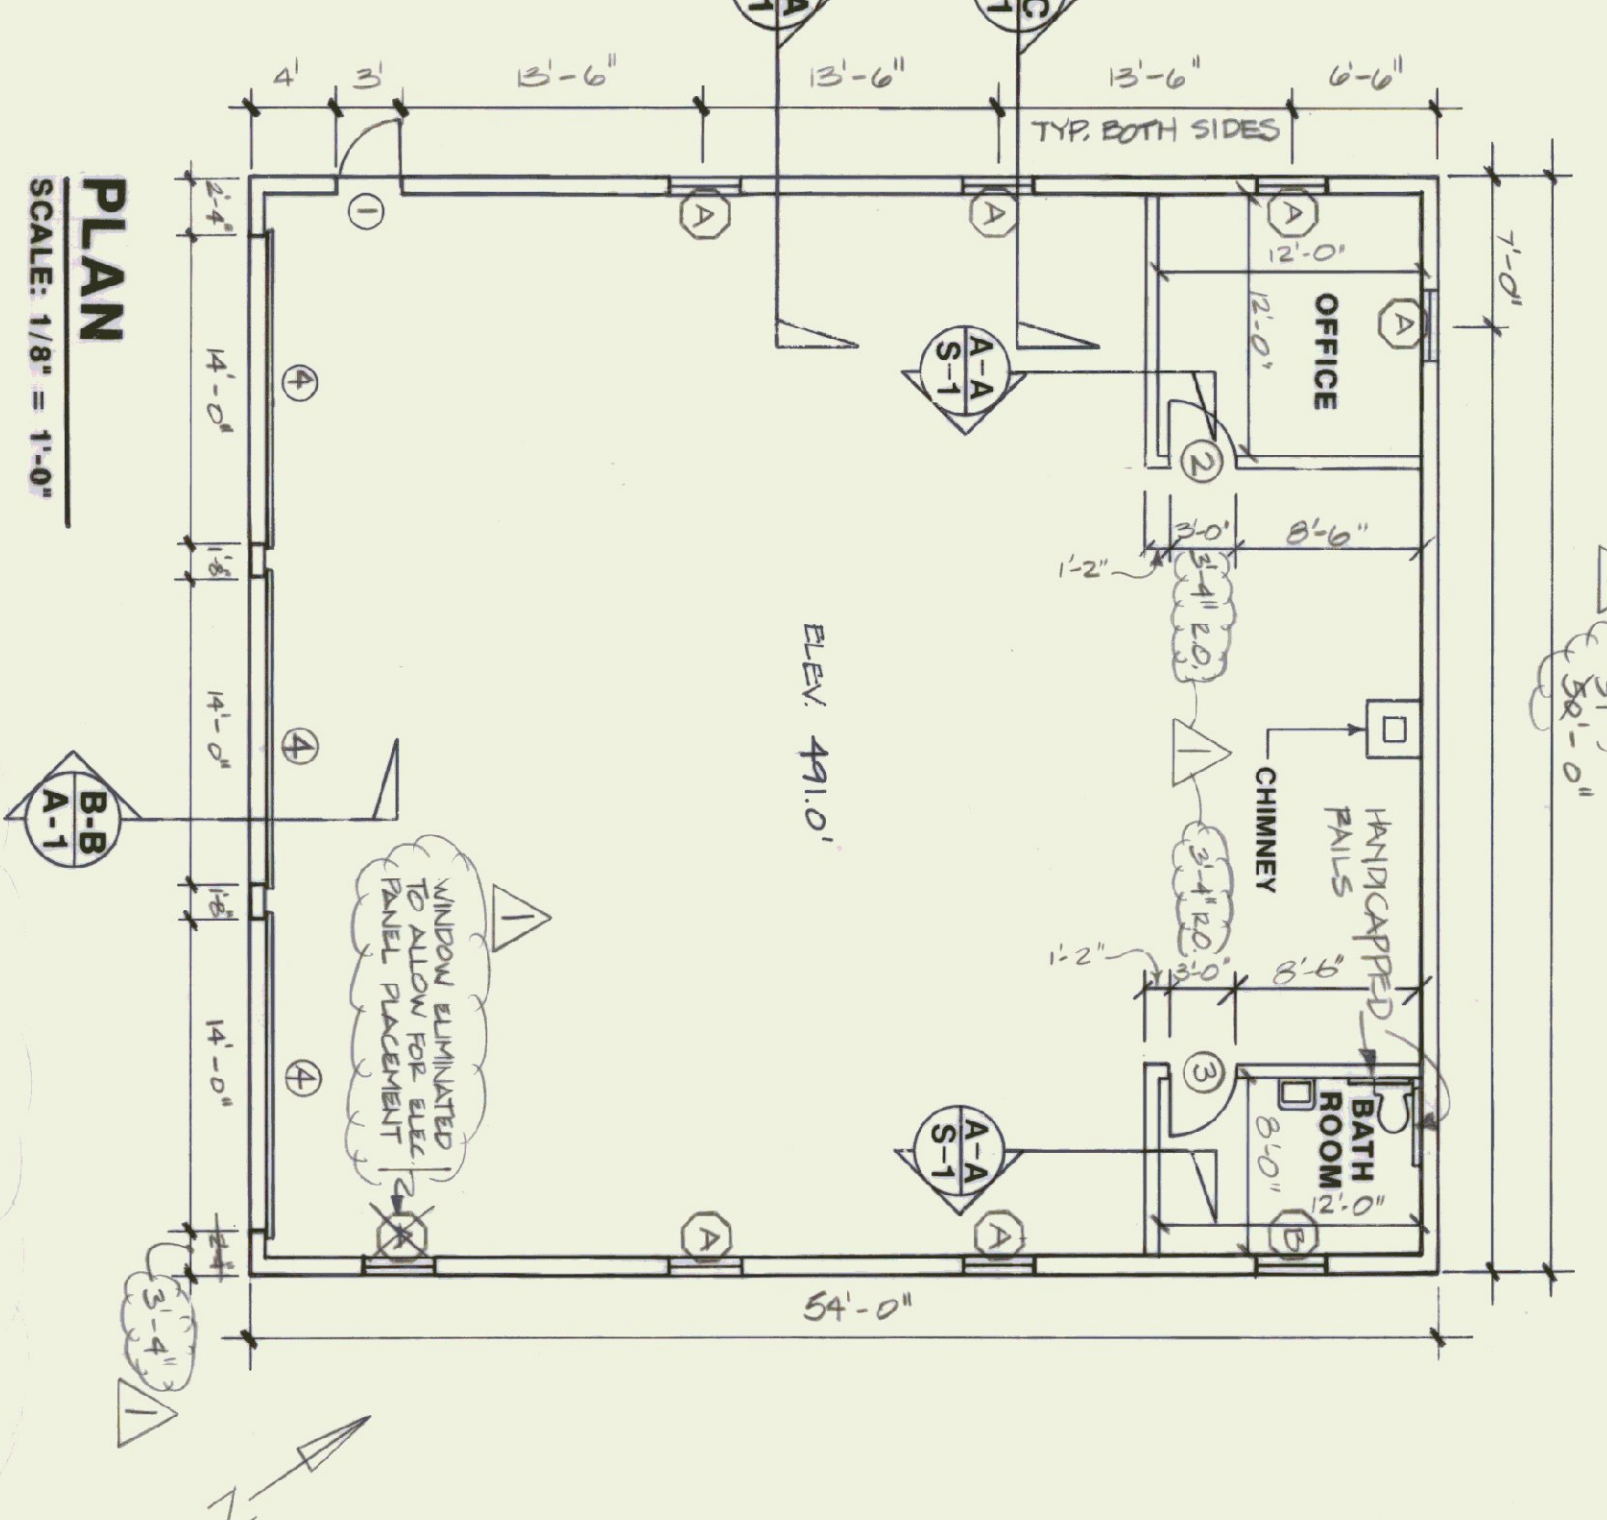

PLAN
SCALE: 1/8" = 1'-0"

STATE OF VERMONT
DEPARTMENT OF STATE BUILDINGS
AGENCY OF ADMINISTRATION
VERMONT

AGENCY OF TRANSPORTATION
PLAN & SECTIONS
SUBBURY MAINTENANCE FACILITY
3 BAY GARAGE

SUBBURY
DATE: April 21, 1995
SCALE: AS NOTED
DRAWN BY: A. POULIN
APPROVED BY: R. TREMBLAY

REVISIONS:
01/22/95 J.G.
DWG. NO. A-1
3 OF 8