


Scale 3/16" = 1'-0"

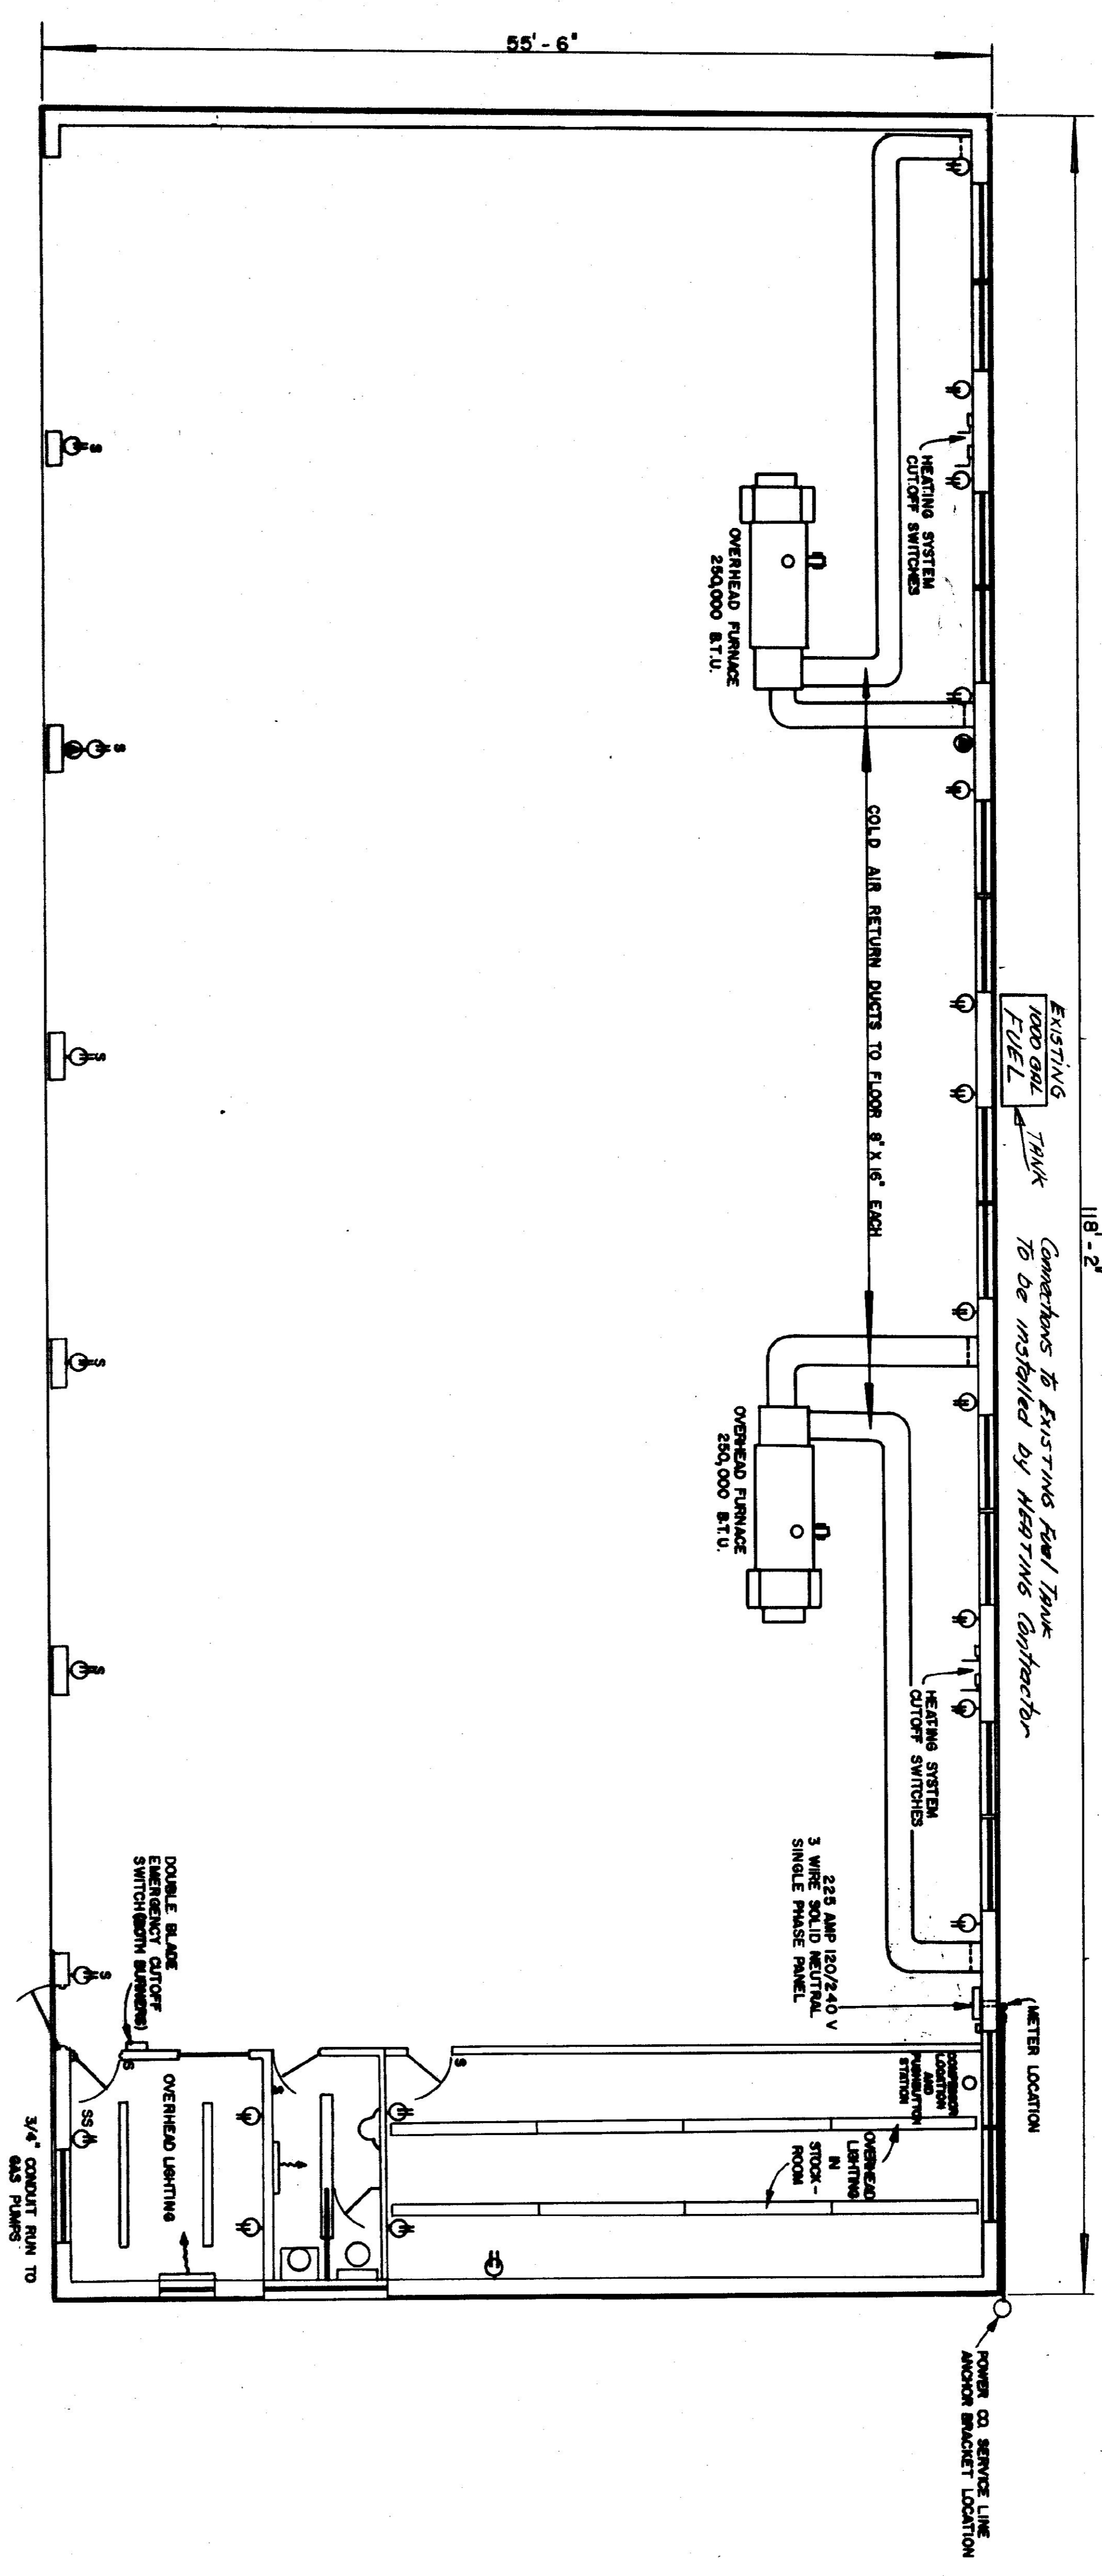

● 120 V. WIRELESS OUTLETS
 ~~~~~ WIRELESS HEATERS

ROYALTON

STATE OF VERMONT  
 HIGHWAY DEPARTMENT  
 GARAGE FOR DISTRICT 5  
 VT. ROUTE 14

WIRING LAYOUT

G. A. PIERCE JUNE 1962