


PLAN	SURVEYED	BY	DATE
NOTE BOOK	PLOTTED		
No.	ALIGNMENT CHECKED		
	ET. OF WAY CHECKED		


PROFILE	SURVEYED	BY	DATE
NOTE BOOK	PLOTTED		
No.	GRADES CHECKED		
	ET. OF WAY CHECKED		
	STRUCTURE NOTATIONS CHECKED		

SEE DVG. U-1 FOR
DISPOSAL FIELD DETAILS

SPK IN 3" BOX ELDER
EL. 172.4

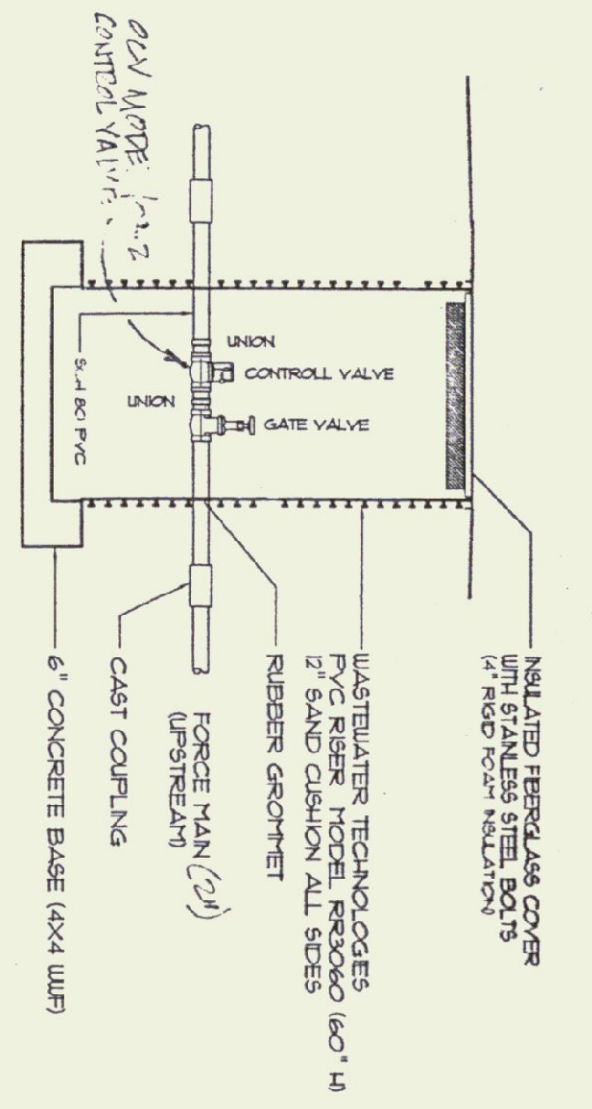

PRESSURE SUSTAINING VALVE
NPS

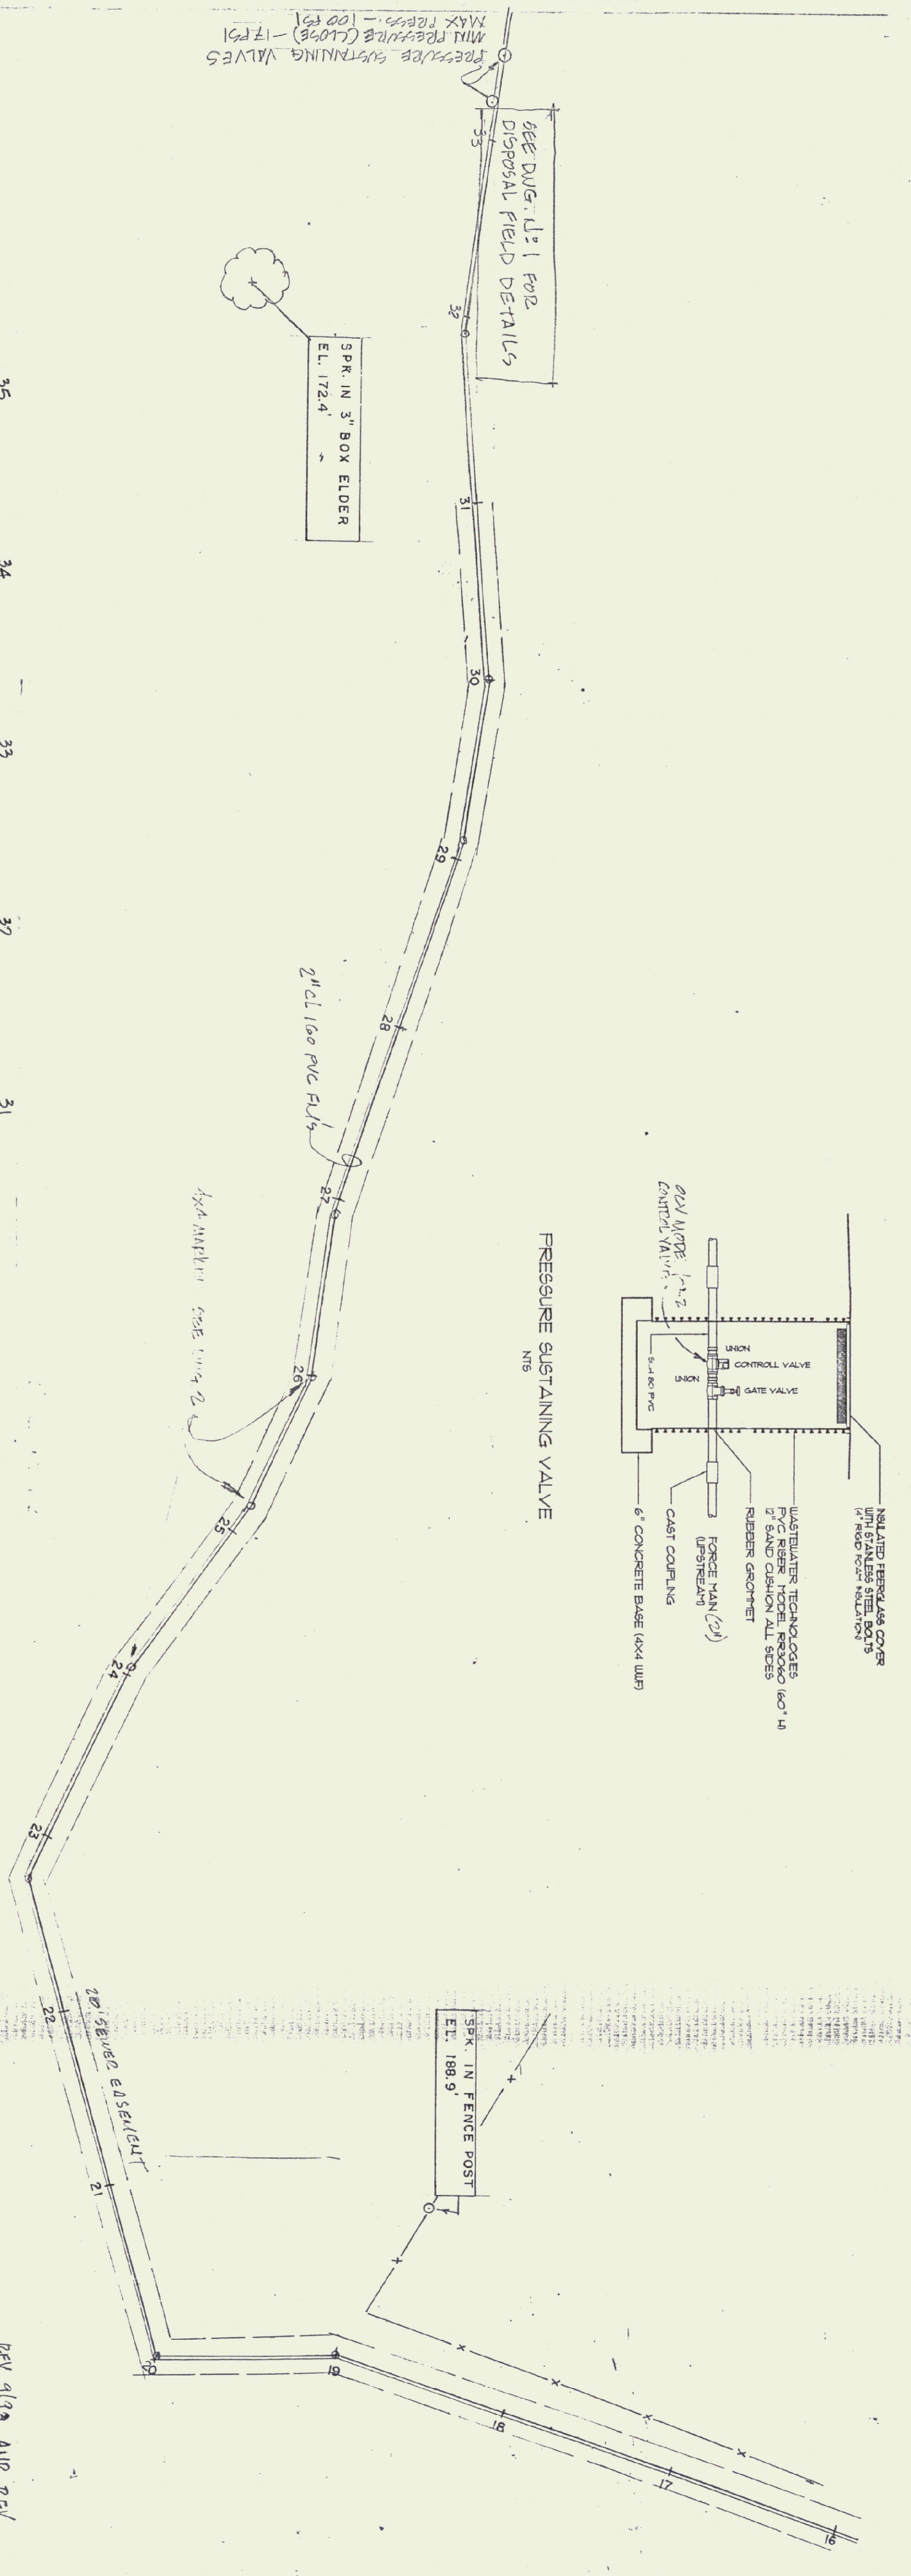

NORTH

REV 9/13 AUC. REV
1/2004 INTER. REV.
SCALE: 1\"/>

RECEIVED
BY: [Signature]
DATE: 11/20/04
DRAWING NO. 7 OF 3
JHSTUART ASSOCIATES
PO BOX 8367 ESSEX 05451

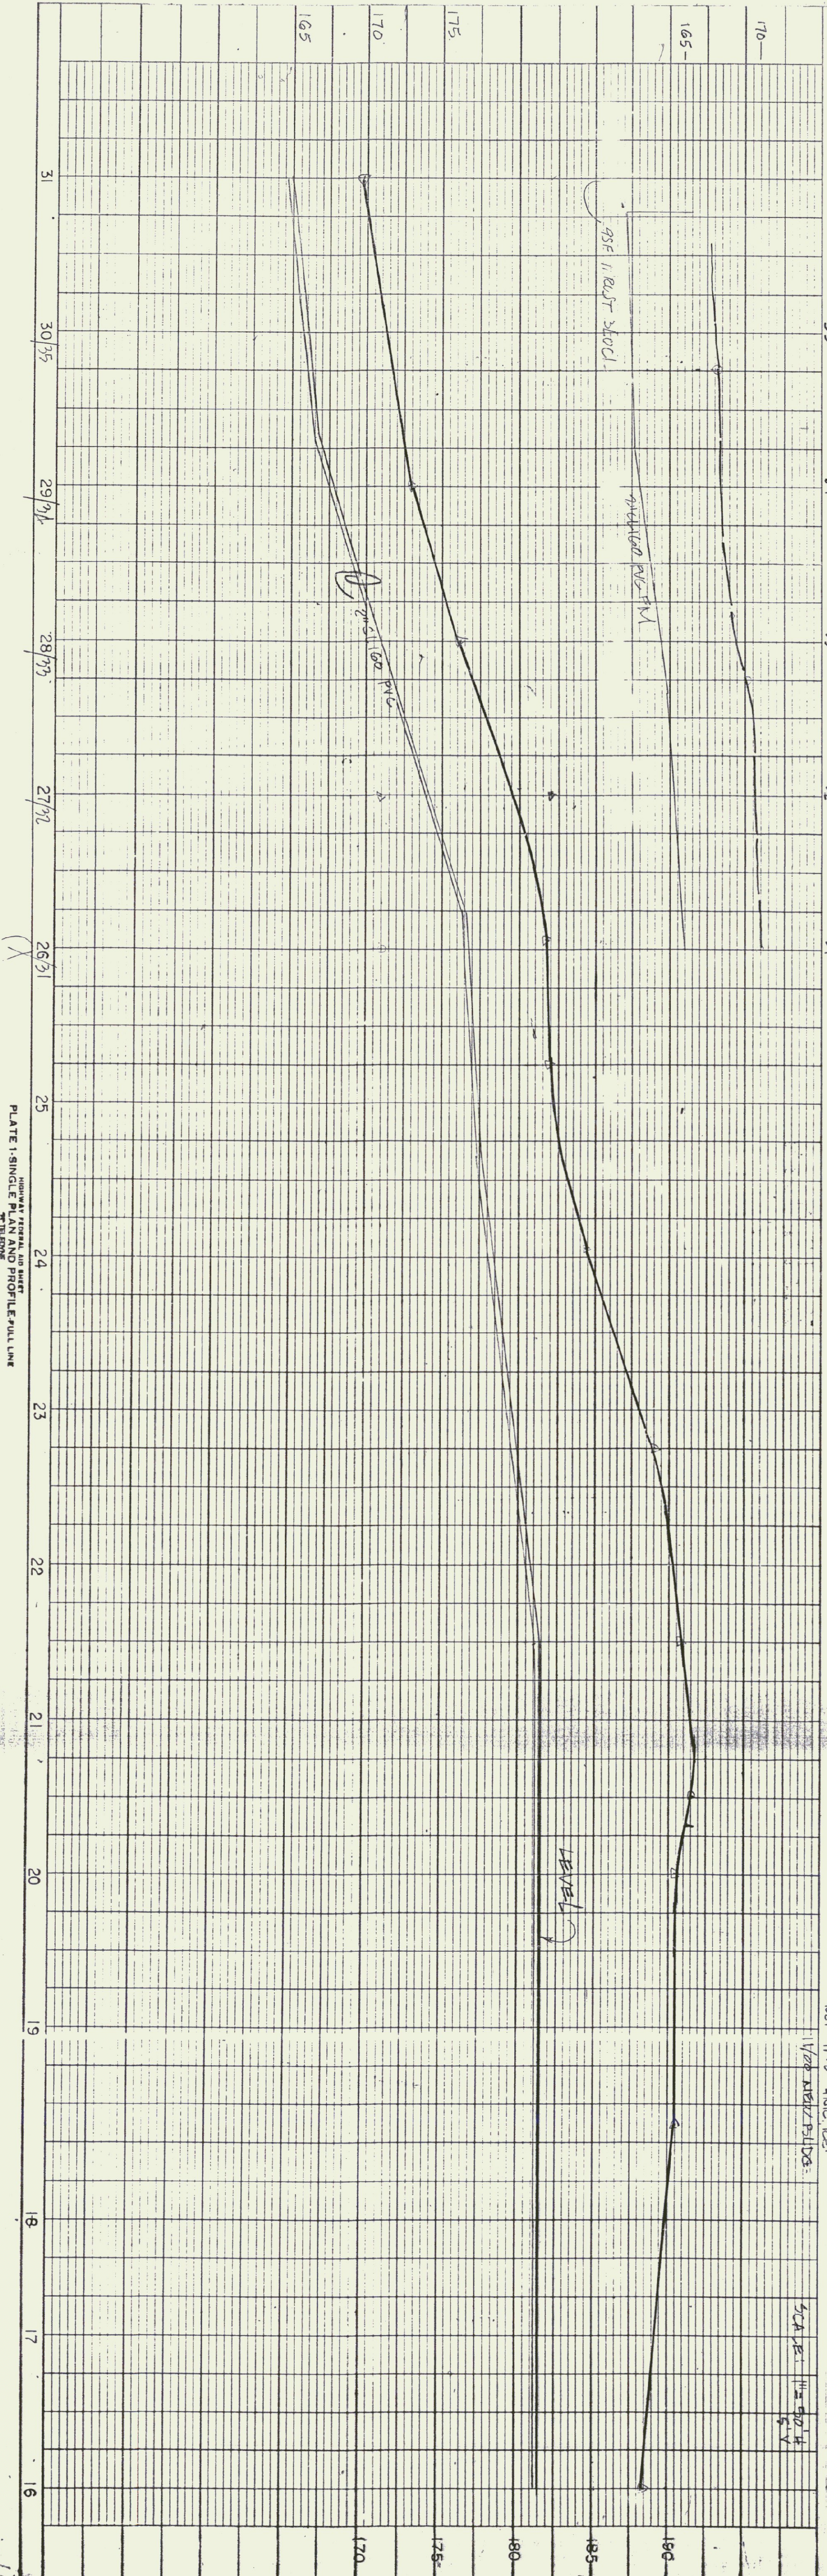


PLATE 1 SINGLE PLAN AND PROFILE FULL LINE