

LOCATION MAP  
N.T.S.

DESIGN SUMMARY:

- PROJECT DESCRIPTION:**  
NEW VERMONT AGENCY OF TRANSPORTATION DISTRICT #5 MAINTENANCE FACILITY.
- CONTACTS:**  
**OWNER:** - STATE OF VERMONT  
VT. DEPT. OF BUILDINGS & GENERAL SERVICES  
2 GOVERNOR AIKEN AVENUE - DRAWER 33  
MONTPELIER, VERMONT 05633-5861  
CONTACT: MERLE MILLER - PROJECT MANAGER  
(802) 828-5695  
**USER:** - AGENCY OF TRANSPORTATION, DISTRICT #5  
P.O. BOX 188  
ESSEX JUNCTION, VT 05453  
CONTACT: RICHARD HOSKING - DISTRICT  
TRANSPORTATION ADMINISTRATOR  
(802) 655-1580

**PROJECT ARCHITECT:** - DORE & WHITTIER  
1795 WILSTON ROAD  
SOUTH BURLINGTON, VERMONT 05403  
CONTACT: ALAN BROWN  
(802) 863-1428

**PROJECT ENGINEERS:** - CHAMPLAIN CONSULTING ENGINEERS (CIVIL)  
85 PRIM ROAD, P.O. BOX 453  
COLCHESTER, VERMONT 05446  
CONTACT: PAUL DUCHESNEAU  
(802) 863-8060

ENGINEERING VENTURES, INC. (STRUCTURAL)  
7 KILBURN STREET  
BURLINGTON, VT 05401  
CONTACT: KEVIN WORDEN  
(802) 863-6225

KIRICK ENGINEERING ASSOCIATES (ELECTRICAL)  
75 HEGEMAN AVE.  
COLCHESTER, VT 05446  
CONTACT: MICHAEL KIRICK  
(802) 655-5731

TEIGH SOUTHWORTH (MECHANICAL)  
VT. DEPT. OF BUILDINGS & GENERAL SERVICES  
2 GOVERNOR AIKEN AVENUE - DRAWER 33  
MONTPELIER, VERMONT 05633-5861  
(802) 828-5695

GENERAL NOTES:

- This plan is for topographic purposes only and is not to be construed as a property boundary survey. Property lines shown are for reference only.
- Prior to commencing site work, the General Contractor shall verify existing field conditions. The Project Engineer shall be notified immediately where discrepancies exist between the project drawings and actual field conditions.
- All existing utility information provided without the help of DIG SAFE.
- The General Contractor shall contact DIG SAFE at (1-888-344-7233) seventy-two hours prior to any excavation to accurately establish the location of all underground utilities located on the project site.
- Where dimensions on the project drawings are unclear, contact the Project Engineer immediately for clarification.
- It is the General Contractor's responsibility to ensure that the Project drawings reflect the latest revisions.

JOB SITE SAFETY NOTES:


- PROVIDE ADEQUATE SAFETY FOR ALL WORKERS AND THE GENERAL PUBLIC ON AND NEAR THE JOB SITE AT ALL TIMES.
- FOLLOW THE SAFETY PROCEDURES SET FORTH BY THE VERMONT OCCUPATIONAL SAFETY AND HEALTH ADMINISTRATION (VOSH) AT A MINIMUM, AT ALL TIMES.
- ALL EXCAVATION AND HOLES SHALL BE FILLED, COVERED OR BARRICADED AT THE END OF EACH WORKING DAY.
- AT THE END OF EACH WORKDAY, ALL UNFINISHED WORK SHALL BE IDENTIFIED IN SUCH A MANNER SO AS TO WARN UNAUTHORIZED PERSONNEL FROM ENTERING OR USING THE UNFINISHED AREA.

LEGEND


- - - - - EXISTING CONTOUR
- — — — — PROPERTY LINE
- IRON PIN
- CONCRETE MONUMENT
- FM — FORCE MAIN
- OE — OVERHEAD ELECTRIC
- SHUT-OFF
- POWER POLE
- TP-# TEST PIT
- SOL BORING
- EXISTING DEODOROUS TREE
- EXISTING CONIFEROUS TREE
- EXISTING BRUSH
- — — — — TREE LINE
- — — — — FENCE
- — — — — DRAINAGE SWALE
- — — — — WETLAND DELINEATION
- WETLANDS
- AS-BUILT POINT AS OF 11/05 (ELEVATION, DESCRIPTION)

TP #	DEPTH	SOIL DESCRIPTION
TP #1	0-7"	LOOSE SILTY LOAM
	7-19"	LOOSE TAN/GREY SILT FINE SAND
	19-36"	MEDIUM STIFF GREY SILTY CLAY
	36-133"	STIFF GREY SILTY CLAY SEEPS @ 71" MOTTLING @ 12" NO LEDGE
TP #2	0-8"	LOOSE SILTY LOAM
	8-13"	LOOSE GREY FINE TO MEDIUM SAND
	13-17"	LOOSE BROWN FINE SAND & SILT
	17-39"	MEDIUM STIFF GREY SILTY CLAY STIFF SILTY CLAY SEEPS @ 100" MOTTLING @ 14" NO LEDGE
TP #3	0-8"	LOOSE SILTY LOAM
	8-17"	LOOSE BROWN/GREY FINE SAND & SILT
	17-38"	MEDIUM STIFF GREY SILTY CLAY
	38-123"	STIFF BROWN/GREY SILTY CLAY SEEPS @ 38" MOTTLING @ 8" NO LEDGE
TP #4	0-6"	SILTY LOAM
	6-12"	LOOSE GREY/BROWN SILTY CLAY
	12-24"	MEDIUM STIFF GREY SILTY CLAY
	24-30"	LOOSE GREY FINE SAND
	30-47"	MEDIUM STIFF GREY SILTY CLAY
	47-135"	STIFF BROWN/BROWN SILTY CLAY SEEPS @ 30" MOTTLING @ 8" NO LEDGE
TP #5	0-8"	SILTY LOAM
	8-16"	LOOSE GREY/BROWN SILTY CLAY
	16-31"	MEDIUM STIFF GREY/BROWN SILTY CLAY
	31-43"	STIFF GREY SILTY CLAY
TP #6	0-8"	SILTY LOAM
	8-14"	LOOSE BROWN FINE SAND & SILT
	14-44"	MEDIUM STIFF GREY SILTY CLAY
	44-131"	STIFF BROWN SILTY CLAY SEEPS @ 44" RUNNING WATER @ 102" MOTTLING @ 8" NO LEDGE
TP #7	0-6"	LOOSE DARK BROWN SILTY LOAM
	6-13"	LOOSE BROWN SILT, TRACE CLAY
	13-23"	LOOSE BROWN/GREY SILTY CLAY
	23-36"	MEDIUM STIFF GREY/BROWN SILTY CLAY
	36-38"	LOOSE GREY FINE SAND
	38-126"	STIFF GREY/BROWN SILTY CLAY SEEPS @ 33" RUNNING WATER @ 109" MOTTLING @ 7" NO LEDGE
TP #8	0-9"	LOOSE DARK BROWN SILTY LOAM
	9-12"	LOOSE BROWN FINE SAND AND SILT
	12-16"	LOOSE BROWN SILTY CLAY
	16-36"	MEDIUM STIFF GREY/BROWN SILTY CLAY
	36-40"	LOOSE GREY FINE SAND
	40-123"	STIFF GREY-BROWN SILTY CLAY SEEPS @ 40" RUNNING WATER @ 108" MOTTLING @ 8" NO LEDGE
TP #9	0-7"	LOOSE DARK BROWN SILTY LOAM
	7-15"	LOOSE BROWN FINE SAND AND SILT
	15-31"	MEDIUM STIFF GREY/BROWN SILTY CLAY
	31-35"	MEDIUM COMPACT FINE GREY SAND
	35-48"	MEDIUM STIFF GREY SILTY CLAY
	48-108"	STIFF GREY/BROWN SILTY CLAY SEEPS @ 30" RUNNING WATER @ 96" MOTTLING @ 8" NO LEDGE

EXISTING CONDITIONS  
SCALE 1" = 60'

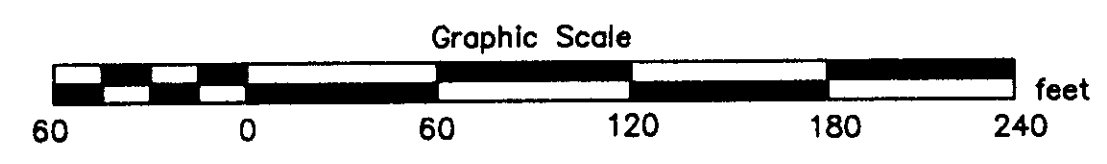

**Champlain Consulting Engineers**  
1795 WILSTON RD. STE. 5  
COLCHESTER, VERMONT 05446  
PHONE: (802) 865-8060  
FAX: (802) 864-1070

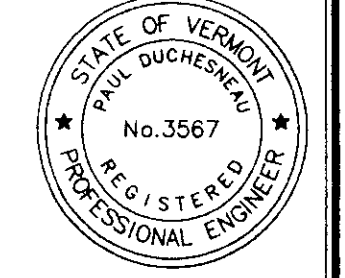

**D&W**  
DORE AND WHITTIER, INC.  
Architects • Project Managers  
140 BANCROFT STREET  
QUINCY, MASSACHUSETTS  
PHONE: (603) 942-4429  
FAX: (603) 942-9955



STATE OF VERMONT  
DEPARTMENT OF BUILDINGS  
AND GENERAL SERVICES  
AGENCY OF ADMINISTRATION  
MONTPELIER, VERMONT

AGENCY OF TRANSPORTATION  
N. FERRISBURGH MAINTENANCE FACILITY  
NORTH FERRISBURGH, VERMONT

REVISIONS	SCALE: 1" = 60'
DATE: 01/04/06	DRAWN BY: CCE
	APPR. BY: PD
	FERRISBURGH
	MAINTENANCE GARAGE
	EXISTING CONDITIONS
	C-1
	5 OF 43

1/04/06 12:31:00 2005 23100\_C-1\_2005.dwg Tue Jan 17 17:01:46 2006 CCE/MLC