


PLAN
SCALE 1/8"




END ELEVATION
SCALE 1/8"

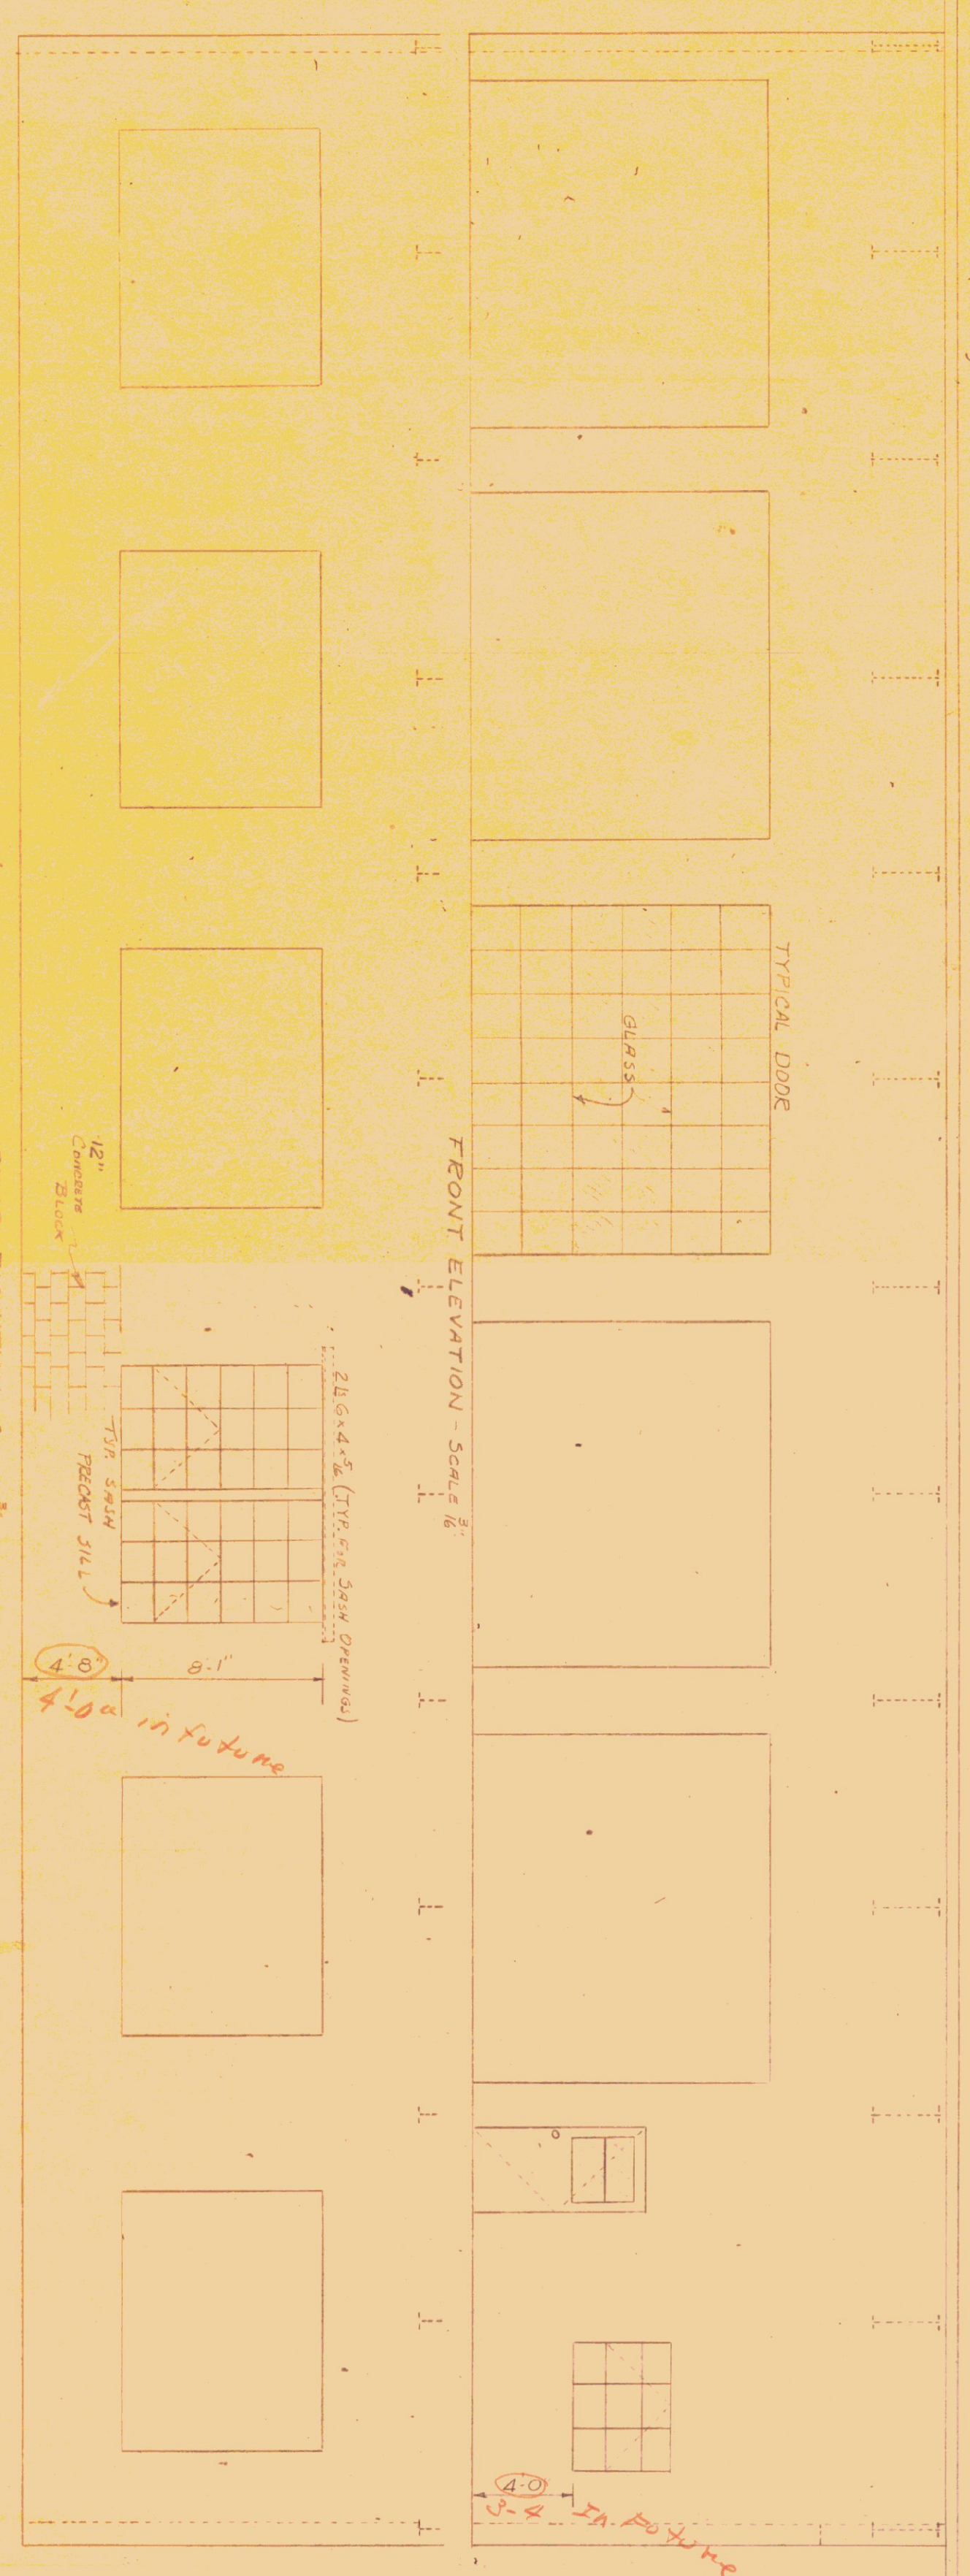

FRONT ELEVATION - SCALE 1/8"

REAR ELEVATION - SCALE 1/8"

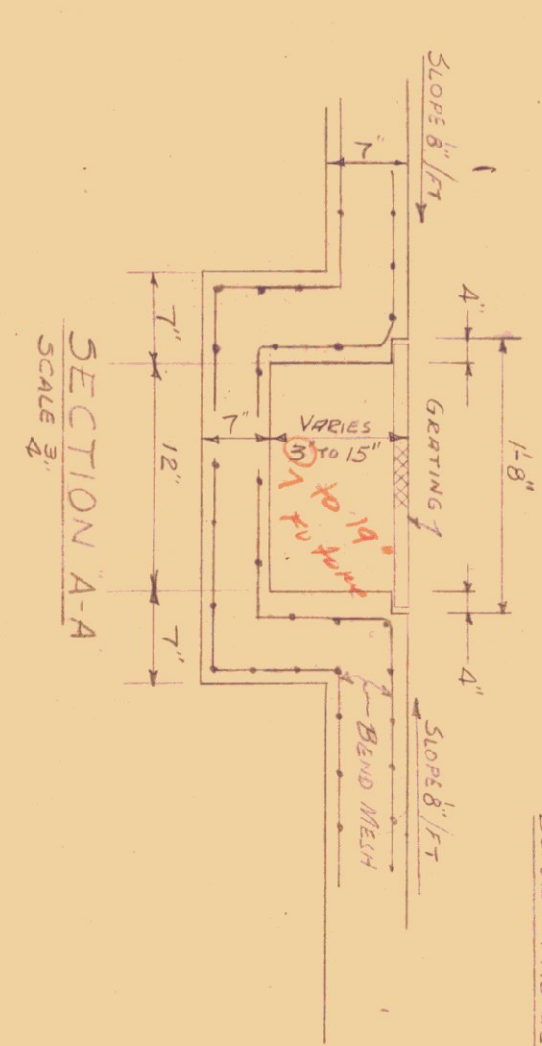

SECTION A-A
SCALE 3/8"

NOTE: DRAWINGS ARE TO BE SUBMITTED FOR APPROVAL BEFORE FABRICATION IS BEGUN

Record Set

STATE OF VERMONT
HIGHWAY DEPARTMENT
GARAGE FOR DISTRICT NO. 9
U.S. ROUTE 2
MIDDLESEX
DESIGN BY: RENASCO
OCTOBER 1958