


118-2" All 1 window B space




PLAN SCALE 1/8"

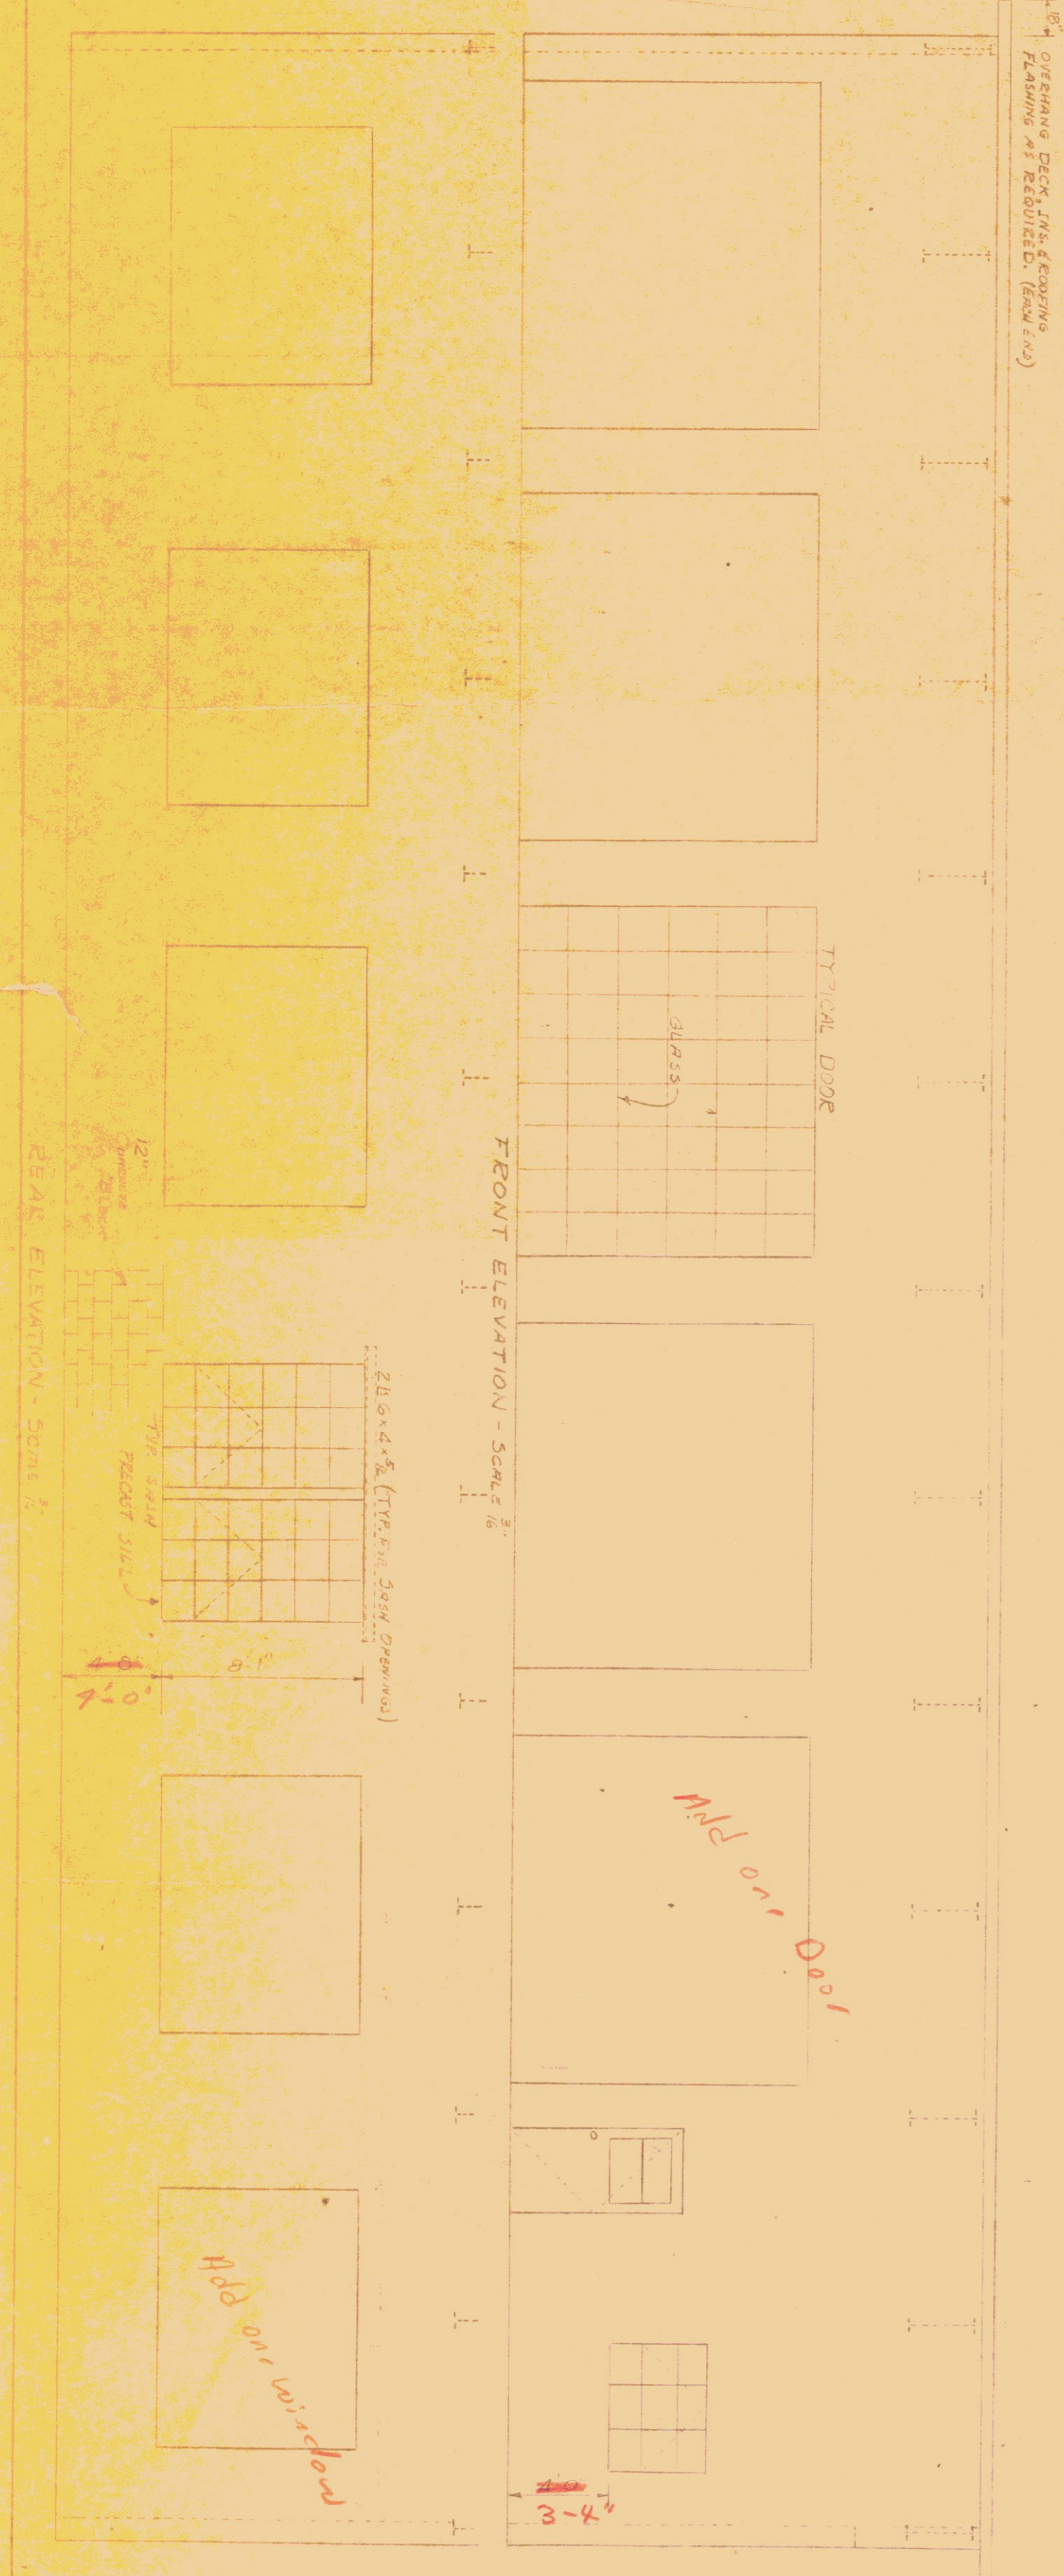


FRONT ELEVATION - SCALE 1/8"

REAR ELEVATION - SCALE 1/8"

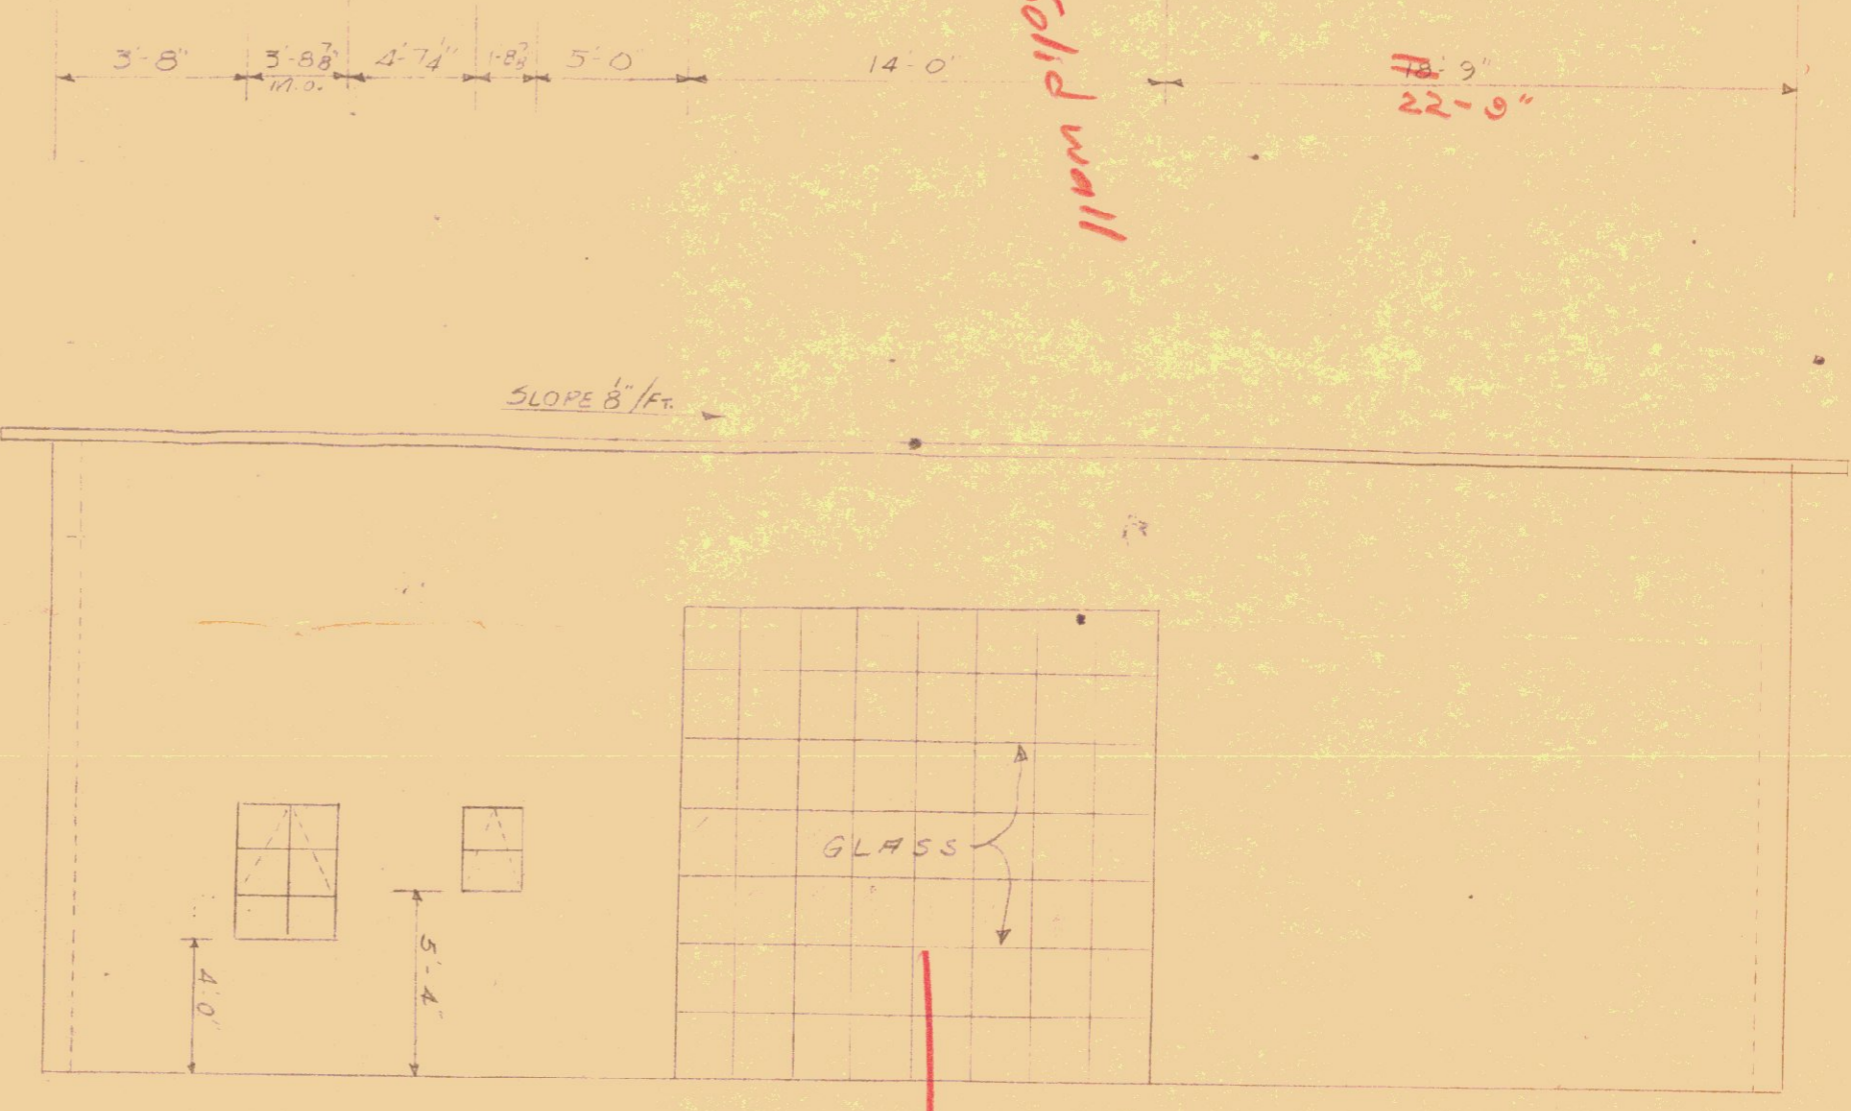

END ELEVATION - SCALE 1/8"

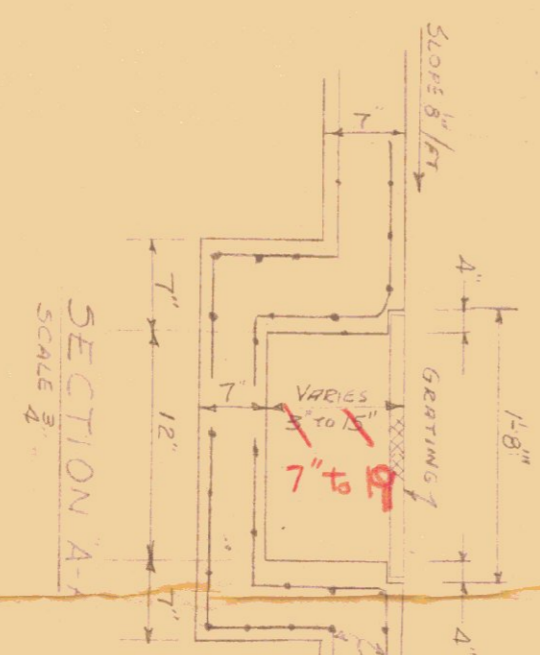

SECTION A-A SCALE 1/8"

NOTE: DRAWINGS ARE TO BE SUBMITTED FOR APPROVAL BEFORE FABRICATION IS BEGUN

STATE OF VERMONT
HIGHWAY DEPARTMENT
GARAGE FOR DISTRICT NO. 9
U.S. ROUTE 2
MIDDLESEX
DESIGN BY: FENANASSO
OCTOBER 1958