
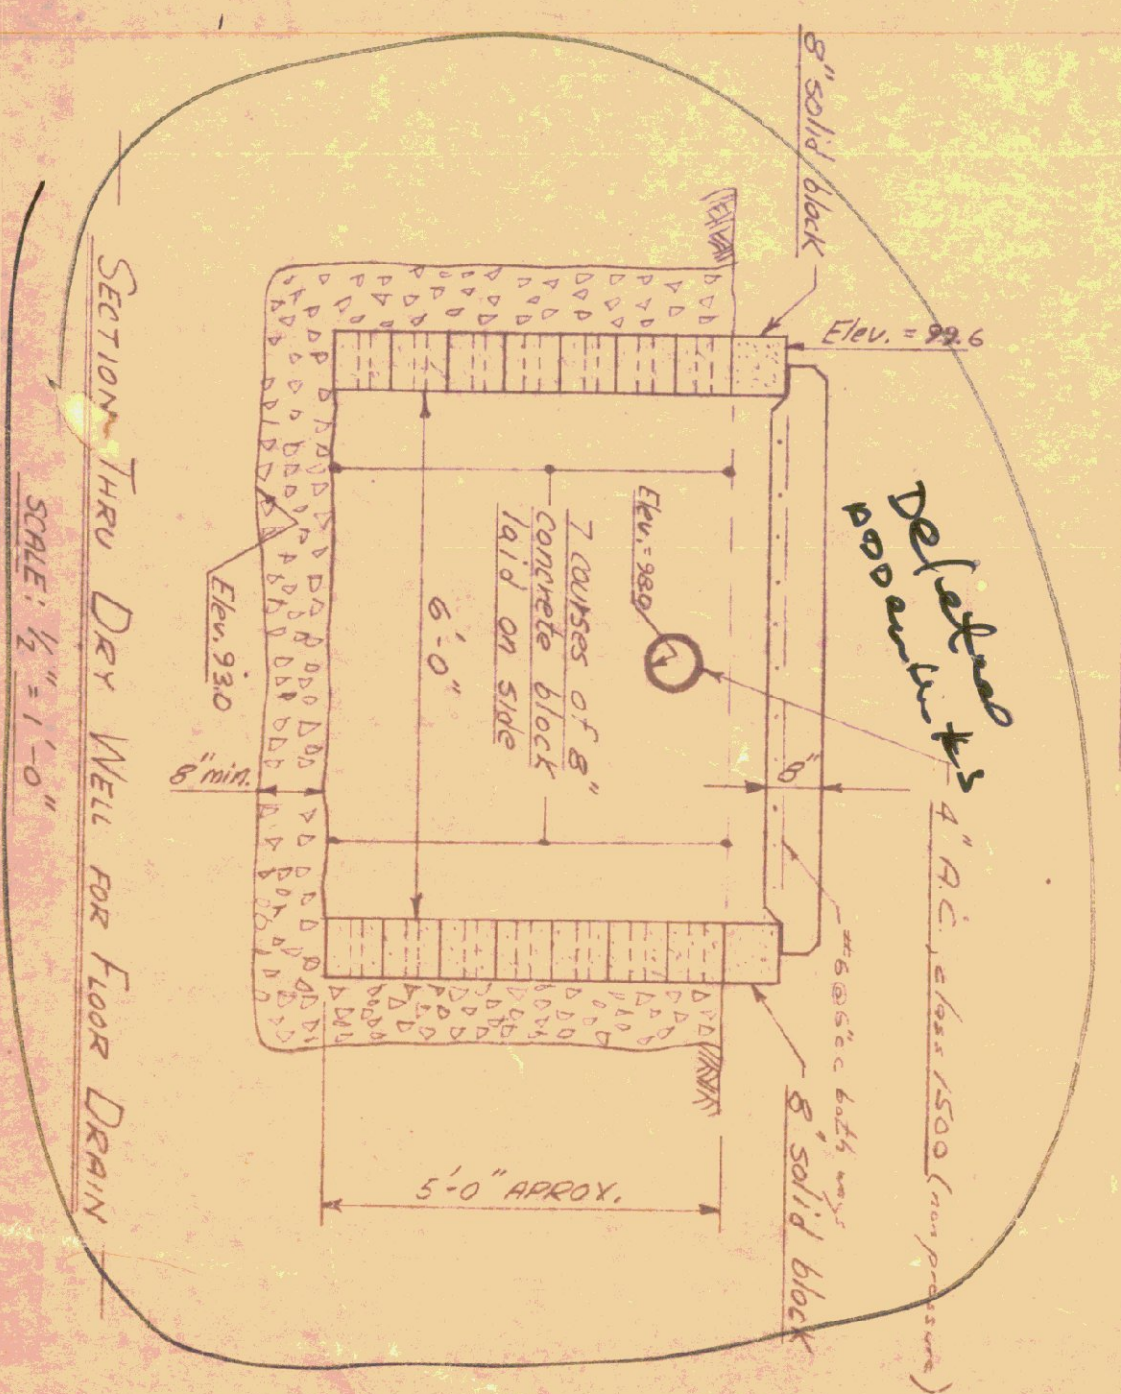
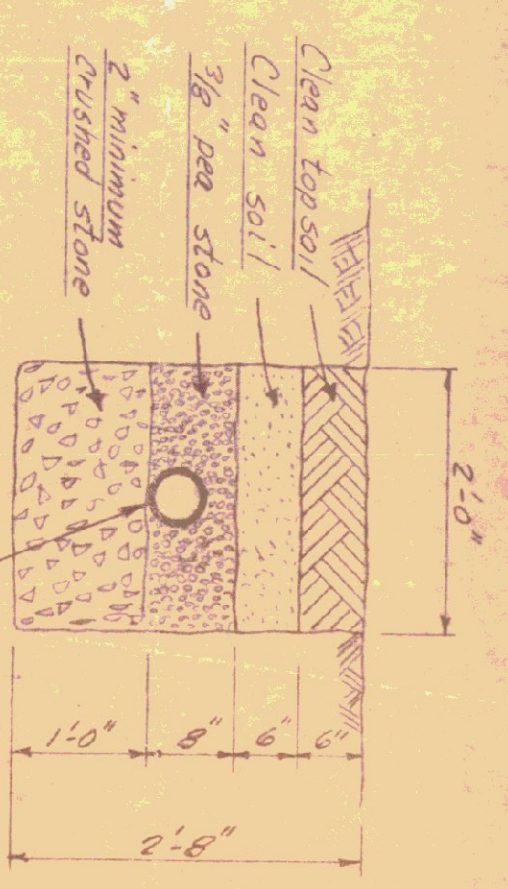


1-55

PLANFIELD NORTH MONTEPELLIER

SITE PLAN
SCALE: 1" = 20.0'

ASSUME B.M. 500.0'
BOT. OF R.P.

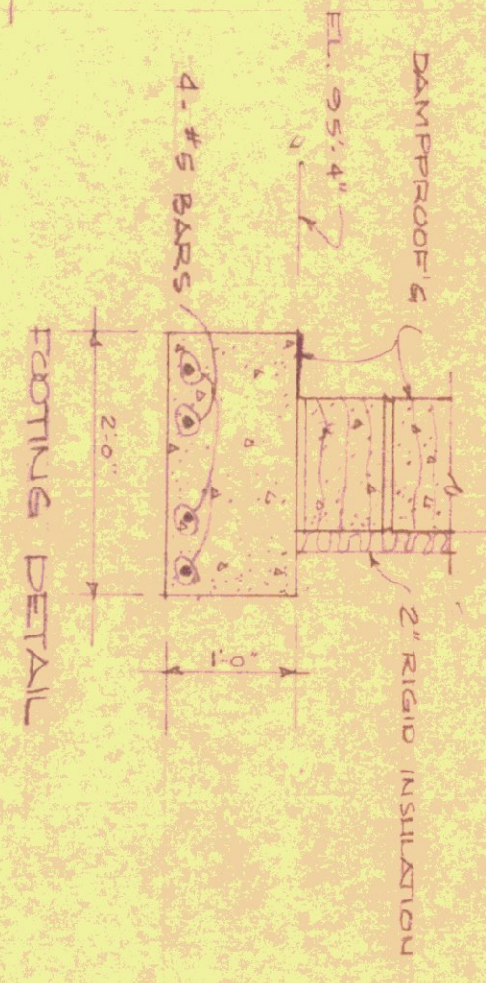

10.0
45.1
0.5, 1.8

field sketch

STANDARD GARAGE BUILDING FOR VERMONT DEPARTMENT OF HIGHWAYS NO. 1 NORTH MONTEPELLIER

DATE: MAY 27, 1966
DRAWN BY: 1-1
STATE BUILDINGS DIVISION
DEPT. OF ADMINISTRATION
VERMONT
MONTPELIER