

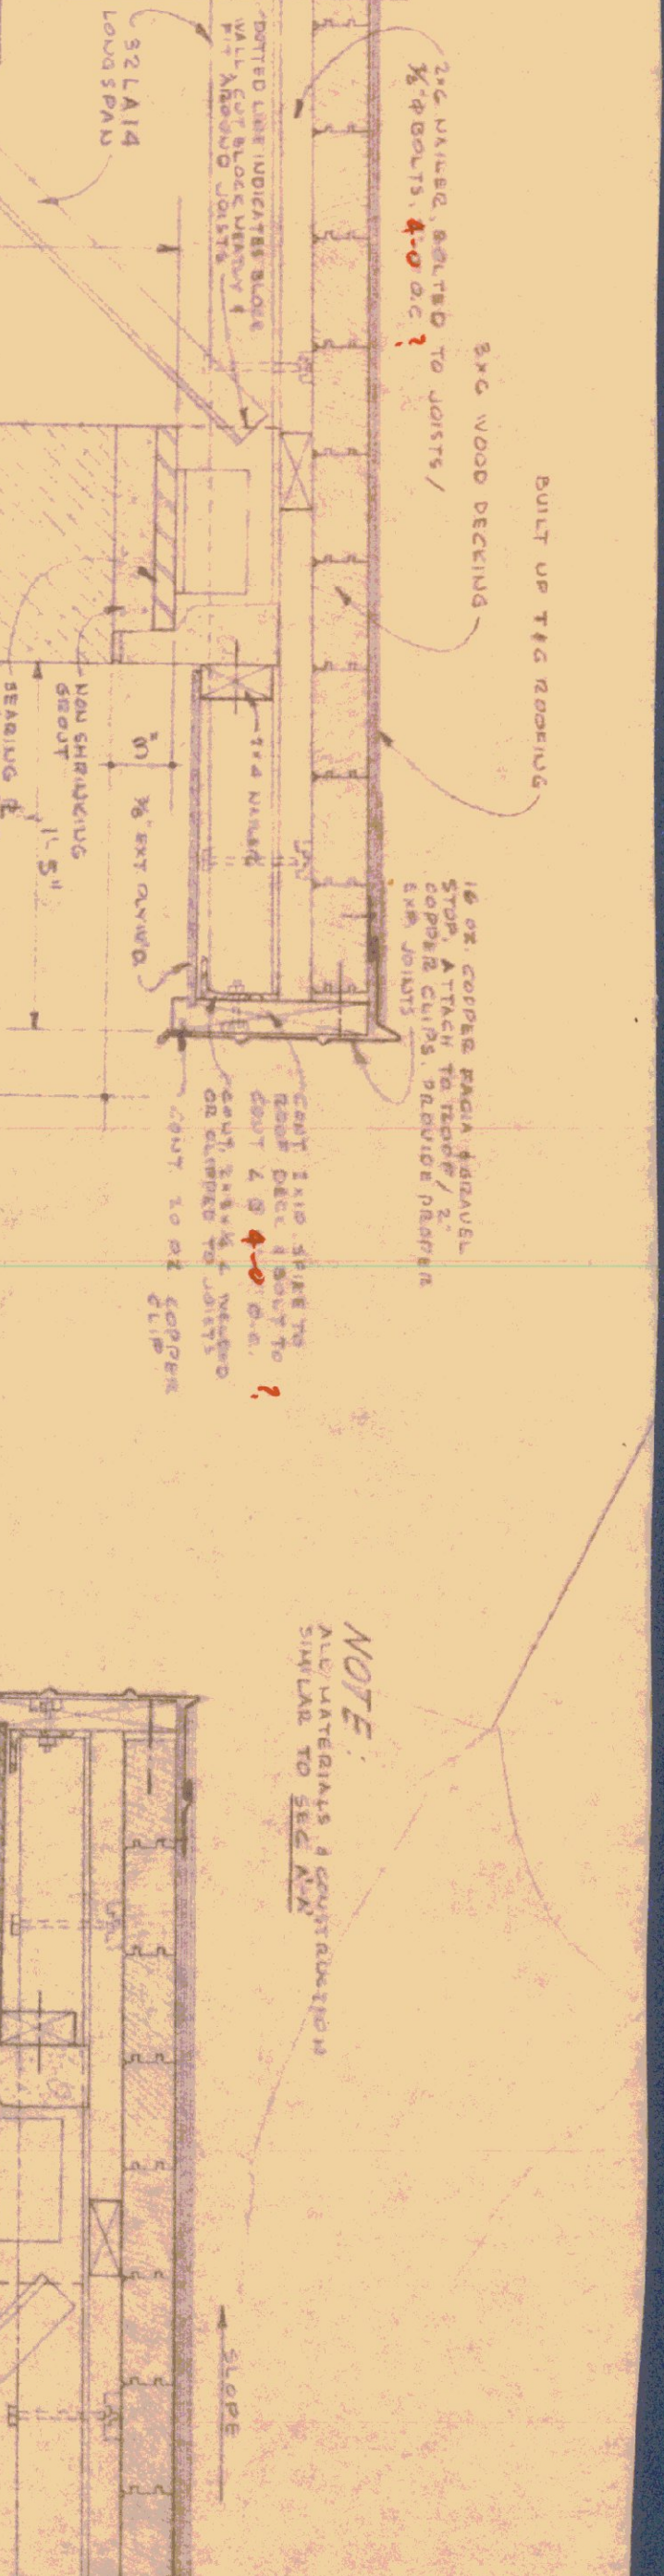


FRONT ELEVATION
SCALE 3/8" = 1'-0"


REAR ELEVATION

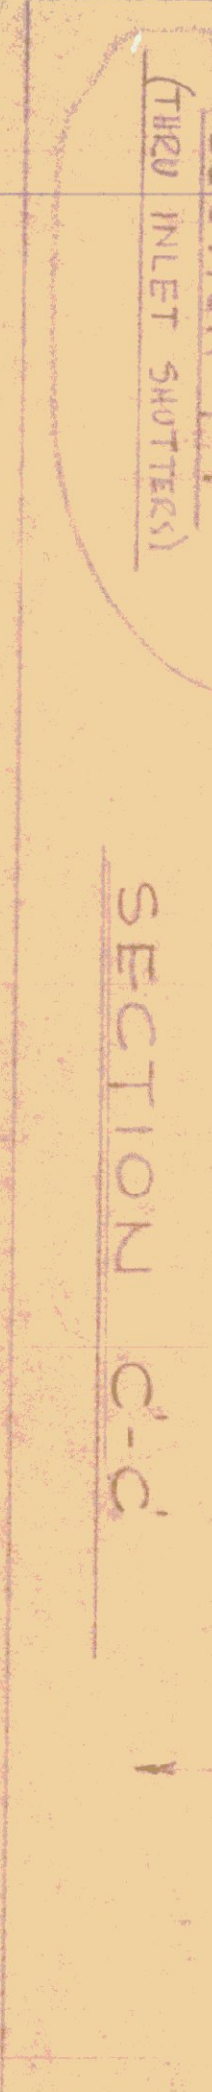



RIGHT END ELEVATION
LEFT END ELEVATION IS OPPOSITE HAND EXCEPT THAT THE TWO WINDOWS ARE OMITTED
SCALE 3/8" = 1'-0"

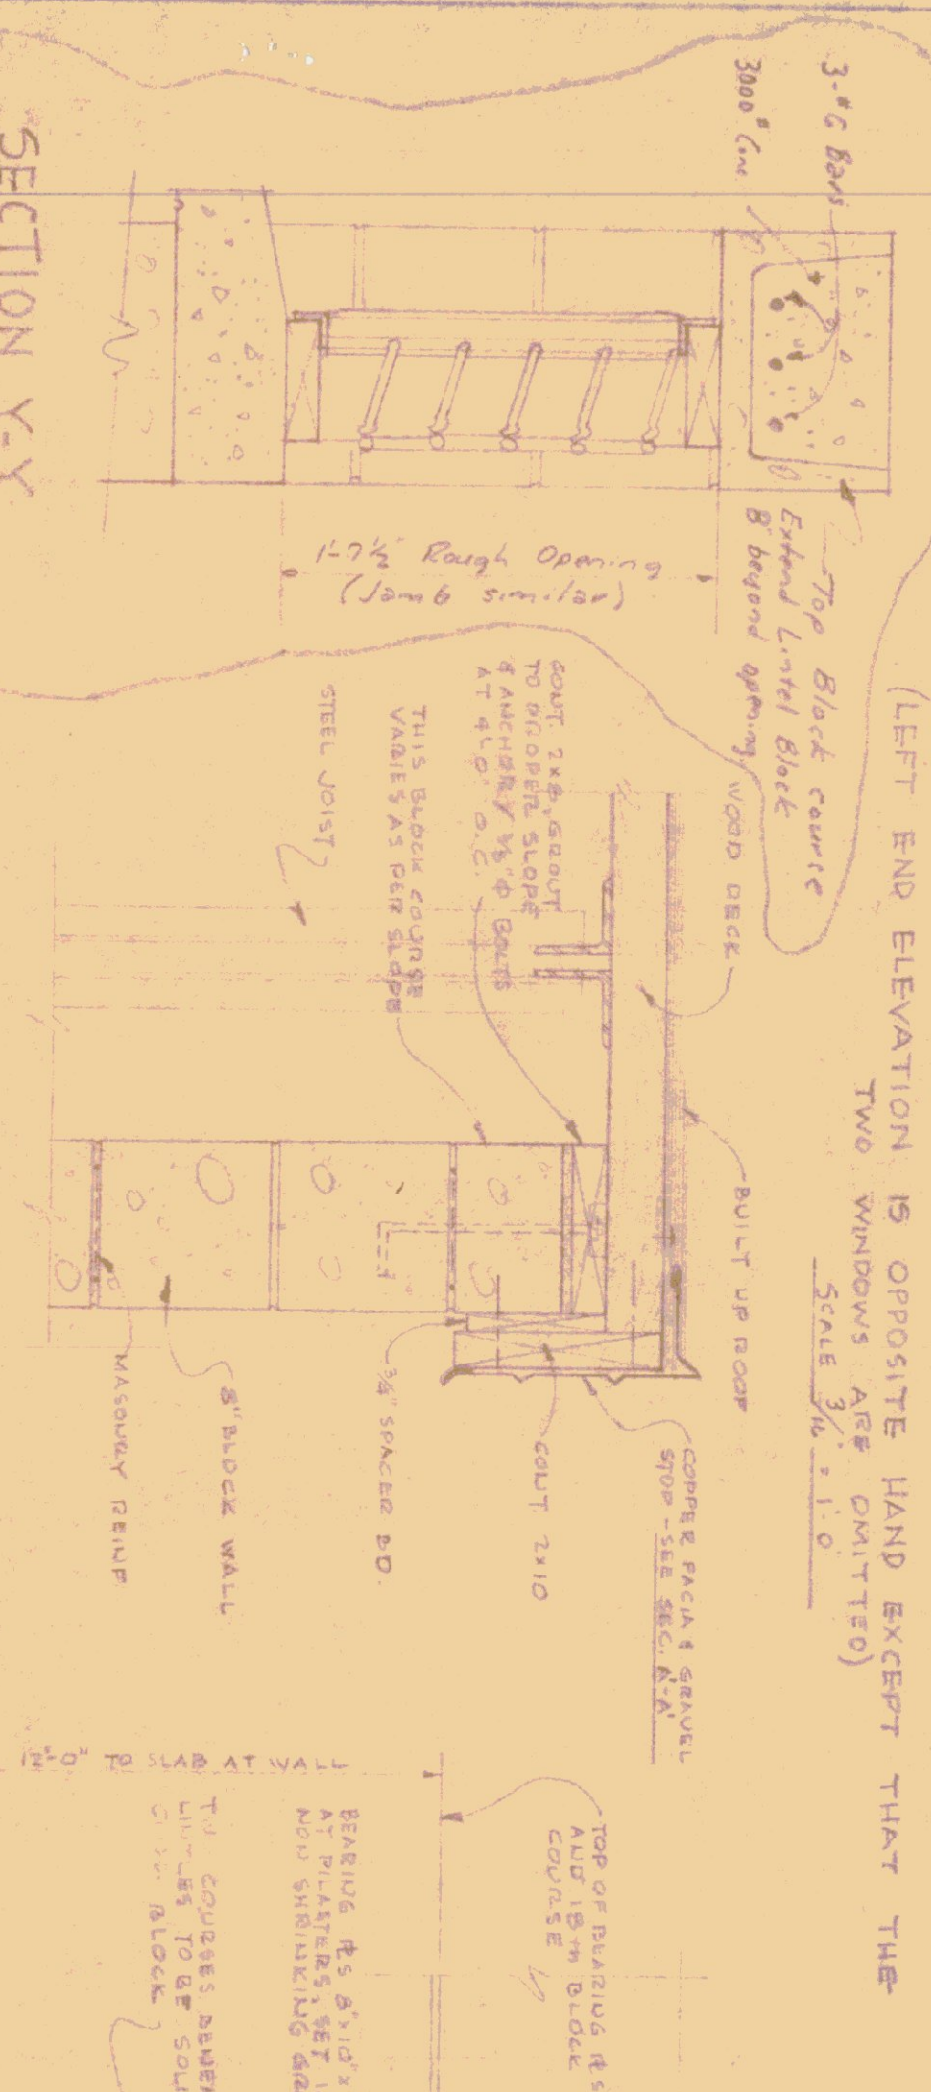

PLAN SECTION
THRU INLET


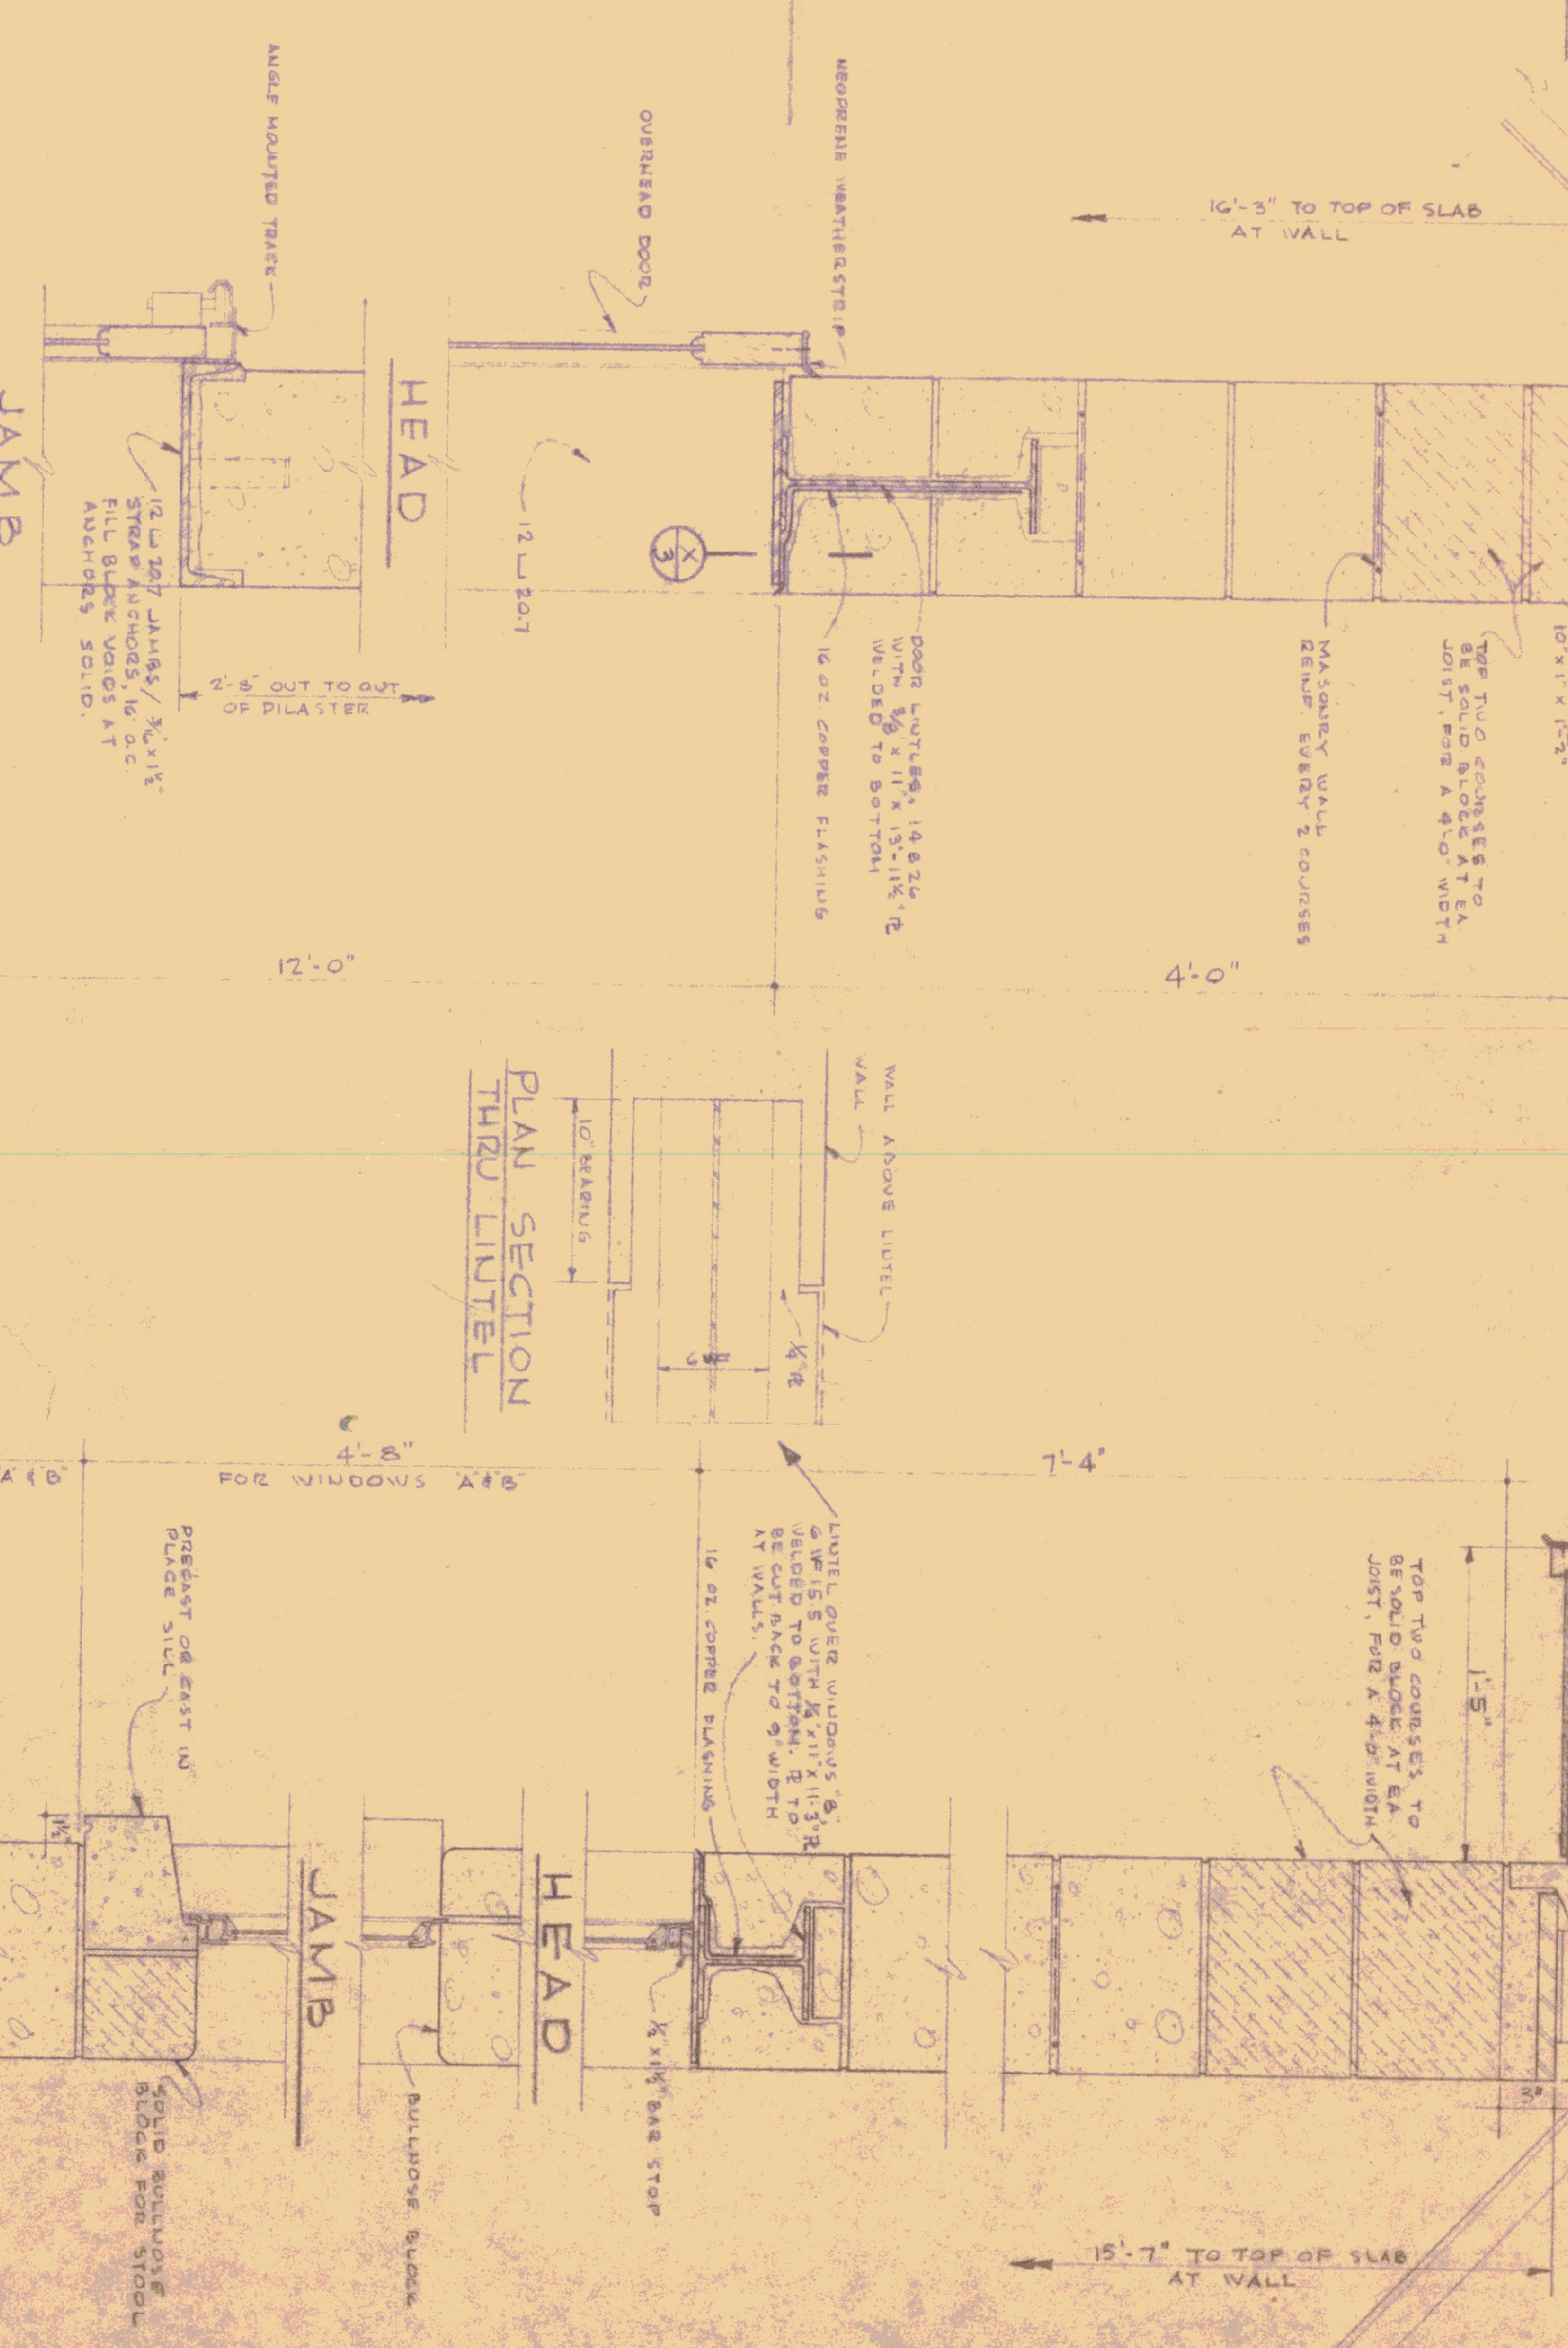


SECTION D
LUTEL AT WINDOWS A, C, & D

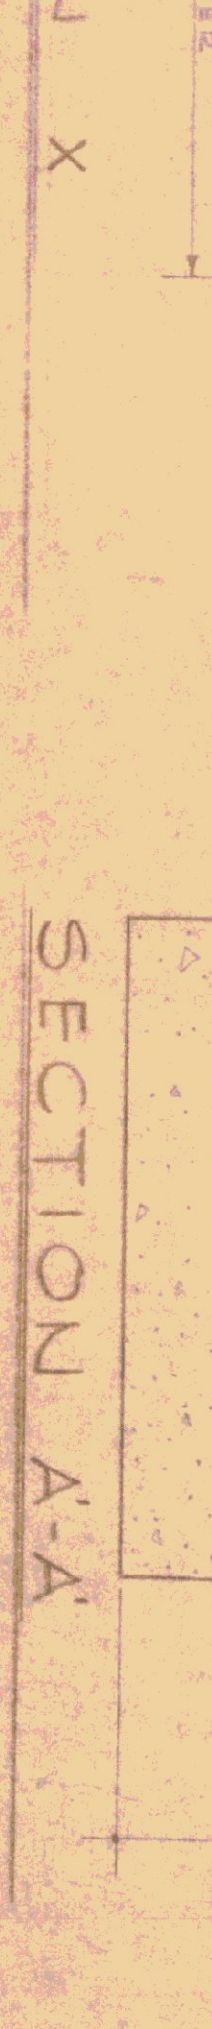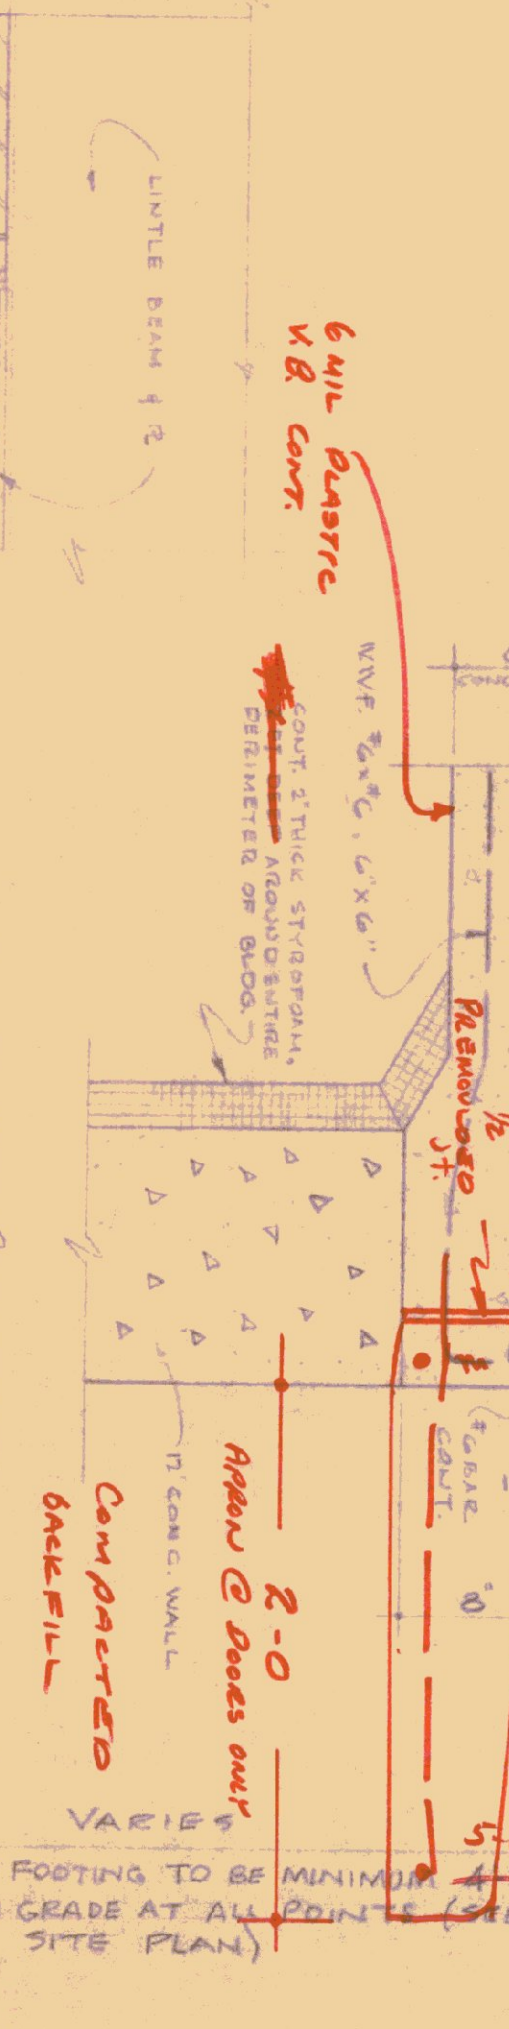

NOTE:
ALL MATERIALS & CONSTRUCTION
SIMILAR TO SEE AX

SECTION B-B

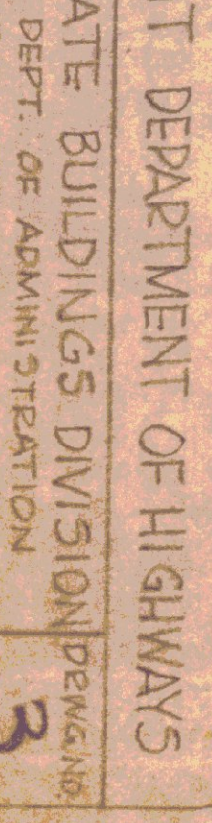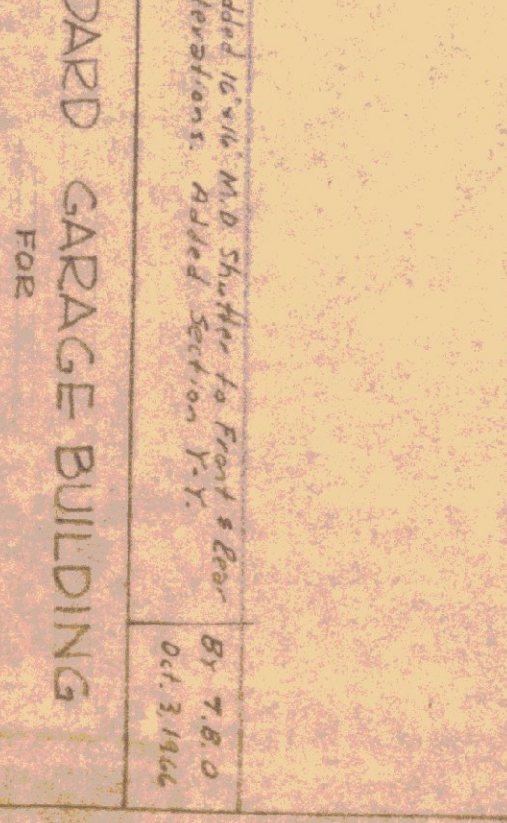

STANDARD GARAGE BUILDING
FOR
VERMONT DEPARTMENT OF HIGHWAYS

DATE: Aug 1, 1947
DRAWN BY: MONTPELLIER, VERMONT
PROJECT: 42-67 HIGHWAY