


State of Vermont
 Department of State Buildings
AGENCY OF TRANSPORTATION
WAITSFIELD MAINTENANCE FACILITY

Waitsfield, Vermont

AS BUILT

AGENCY OF ADMINISTRATION
 DEPT. OF BUILDINGS & GEN. SERVICES
 2 GOVERNOR AIKEN AVENUE
 MONTPELIER, VERMONT 05633-5801
 THOMAS W. TORTI, COMMISSIONER

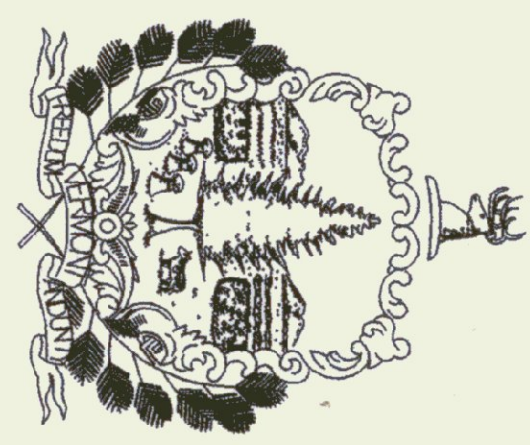


Howard Dean, M.D.
 Governor

July, 1999

INDEX OF SHEETS

SD-1	SITE PLAN
D-1	DETAILS
D-2	EROSION CONTROL & DRAINAGE DETAILS
A-1	PLANS & SECTIONS
S-1	FOUNDATION PLAN & ELEVATION
F-1	FUEL TANK
SS-1	40'x64' SALT/SAND SHED
SS-2	40'x84' SALT/SAND SHED
CSS-1	24'x48' COLD STORAGE SHED
P-1	PLUMBING PLAN
M-1	MECHANICAL PLAN
E-1	ELECTRICAL PLAN

AGENCY OF TRANSPORTATION
 133 STATE STREET
 MONTPELIER, VERMONT 05602
 GLENN GERSHANECK, SECRETARY

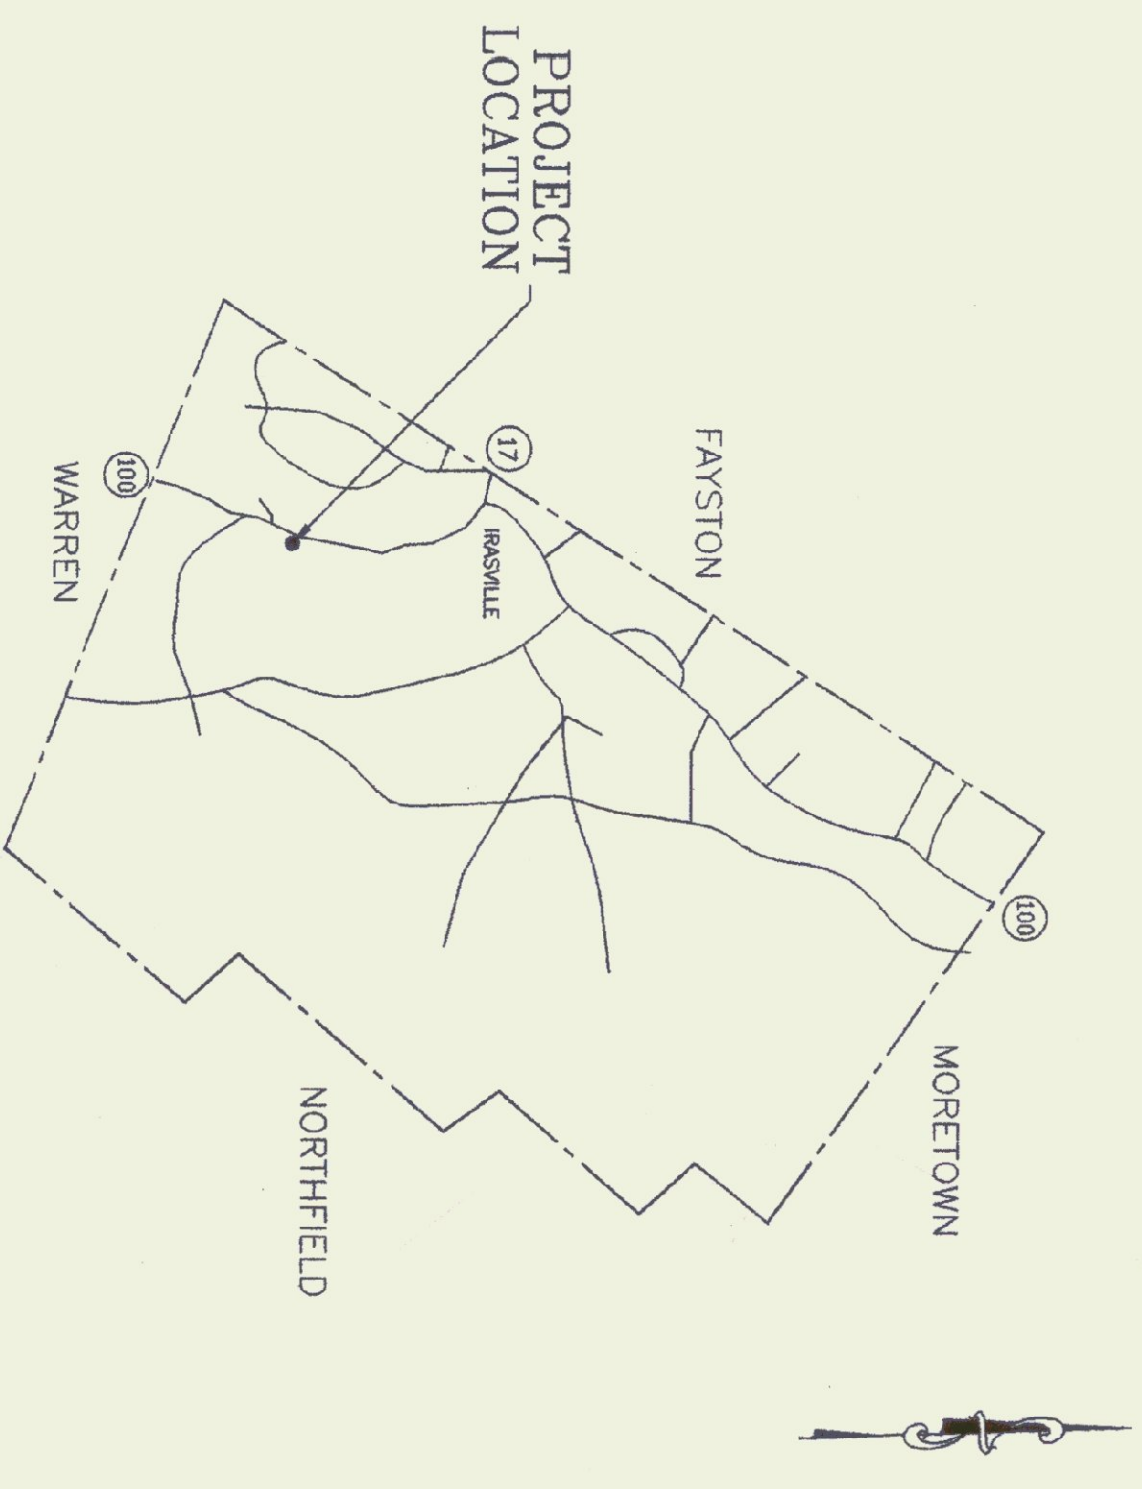

PROJECT LOCATION
As-Built