


7.40

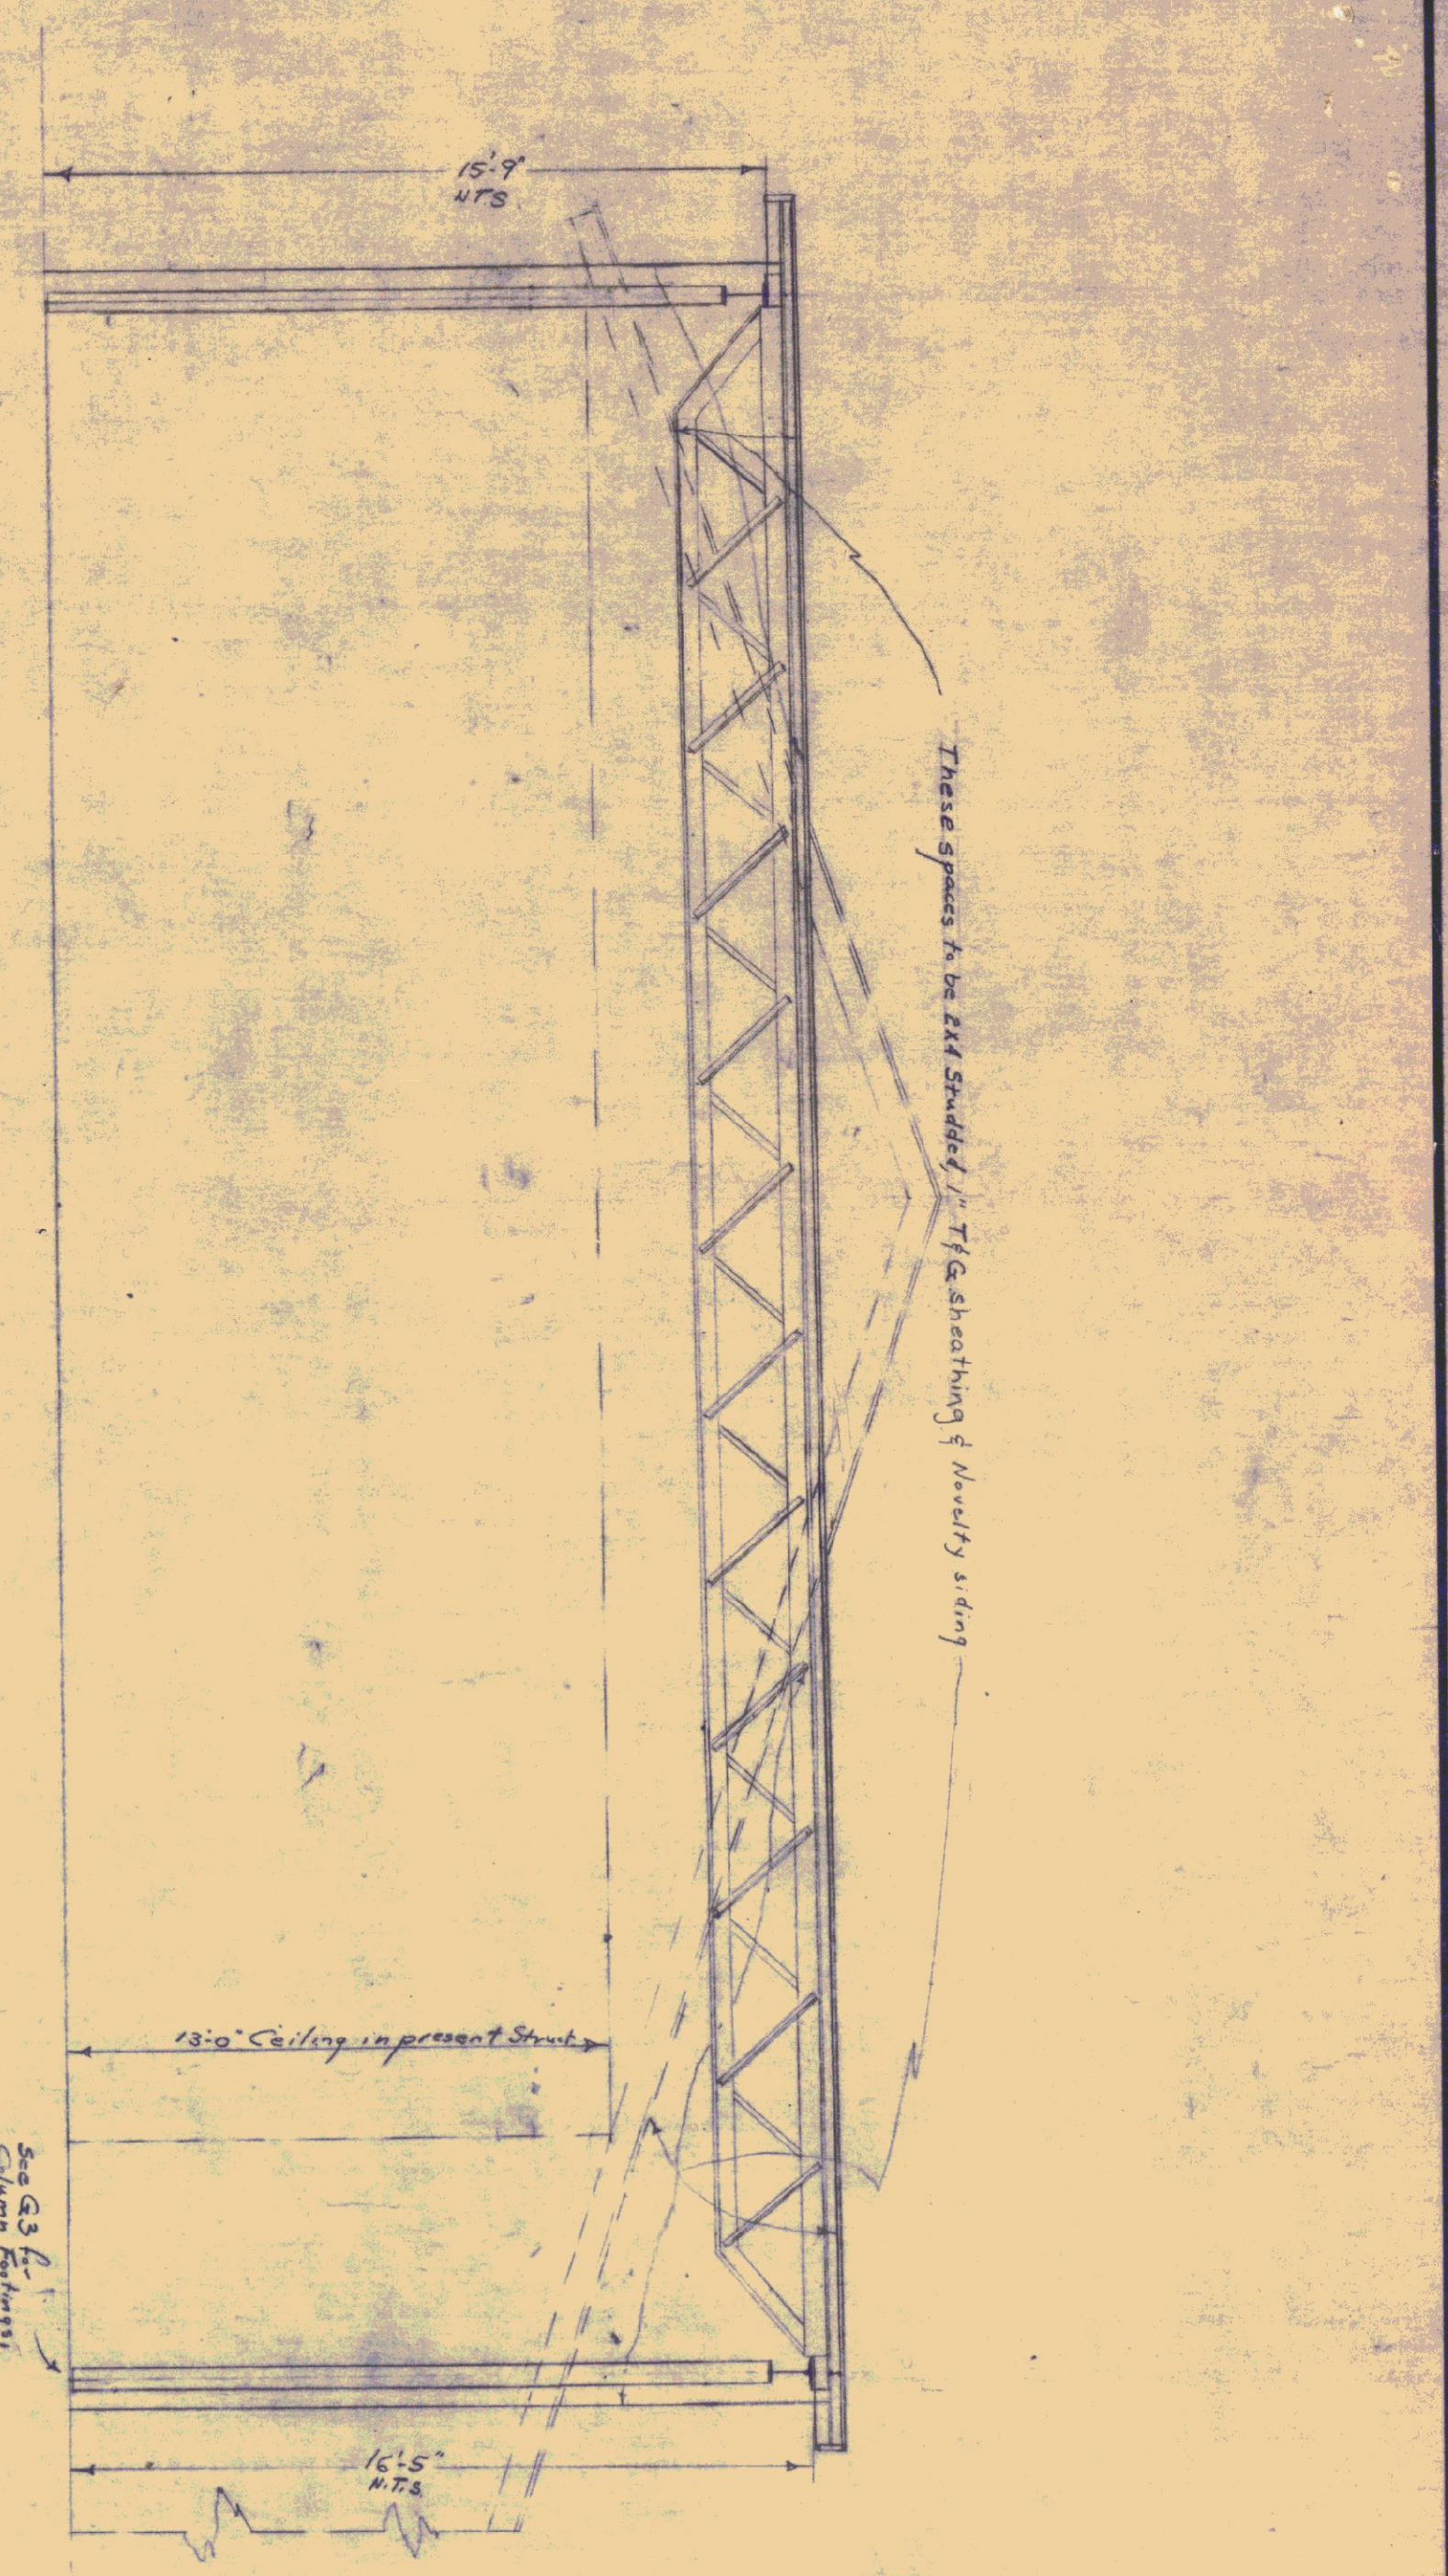

NOTE: ADEQUATE COPPER FLASHING TO BE PROVIDED WHERE BUILDINGS JOIN.

ELEVATION OF GARAGE AT JUNCTION WITH PRESENT STRUCTURE

SECT. A-A

Scale 1/8" = 1'-0"




SITE PLAN

Scale 1" = 30'

Surveyed Oct 21, 1960

Design taken from Address Garage

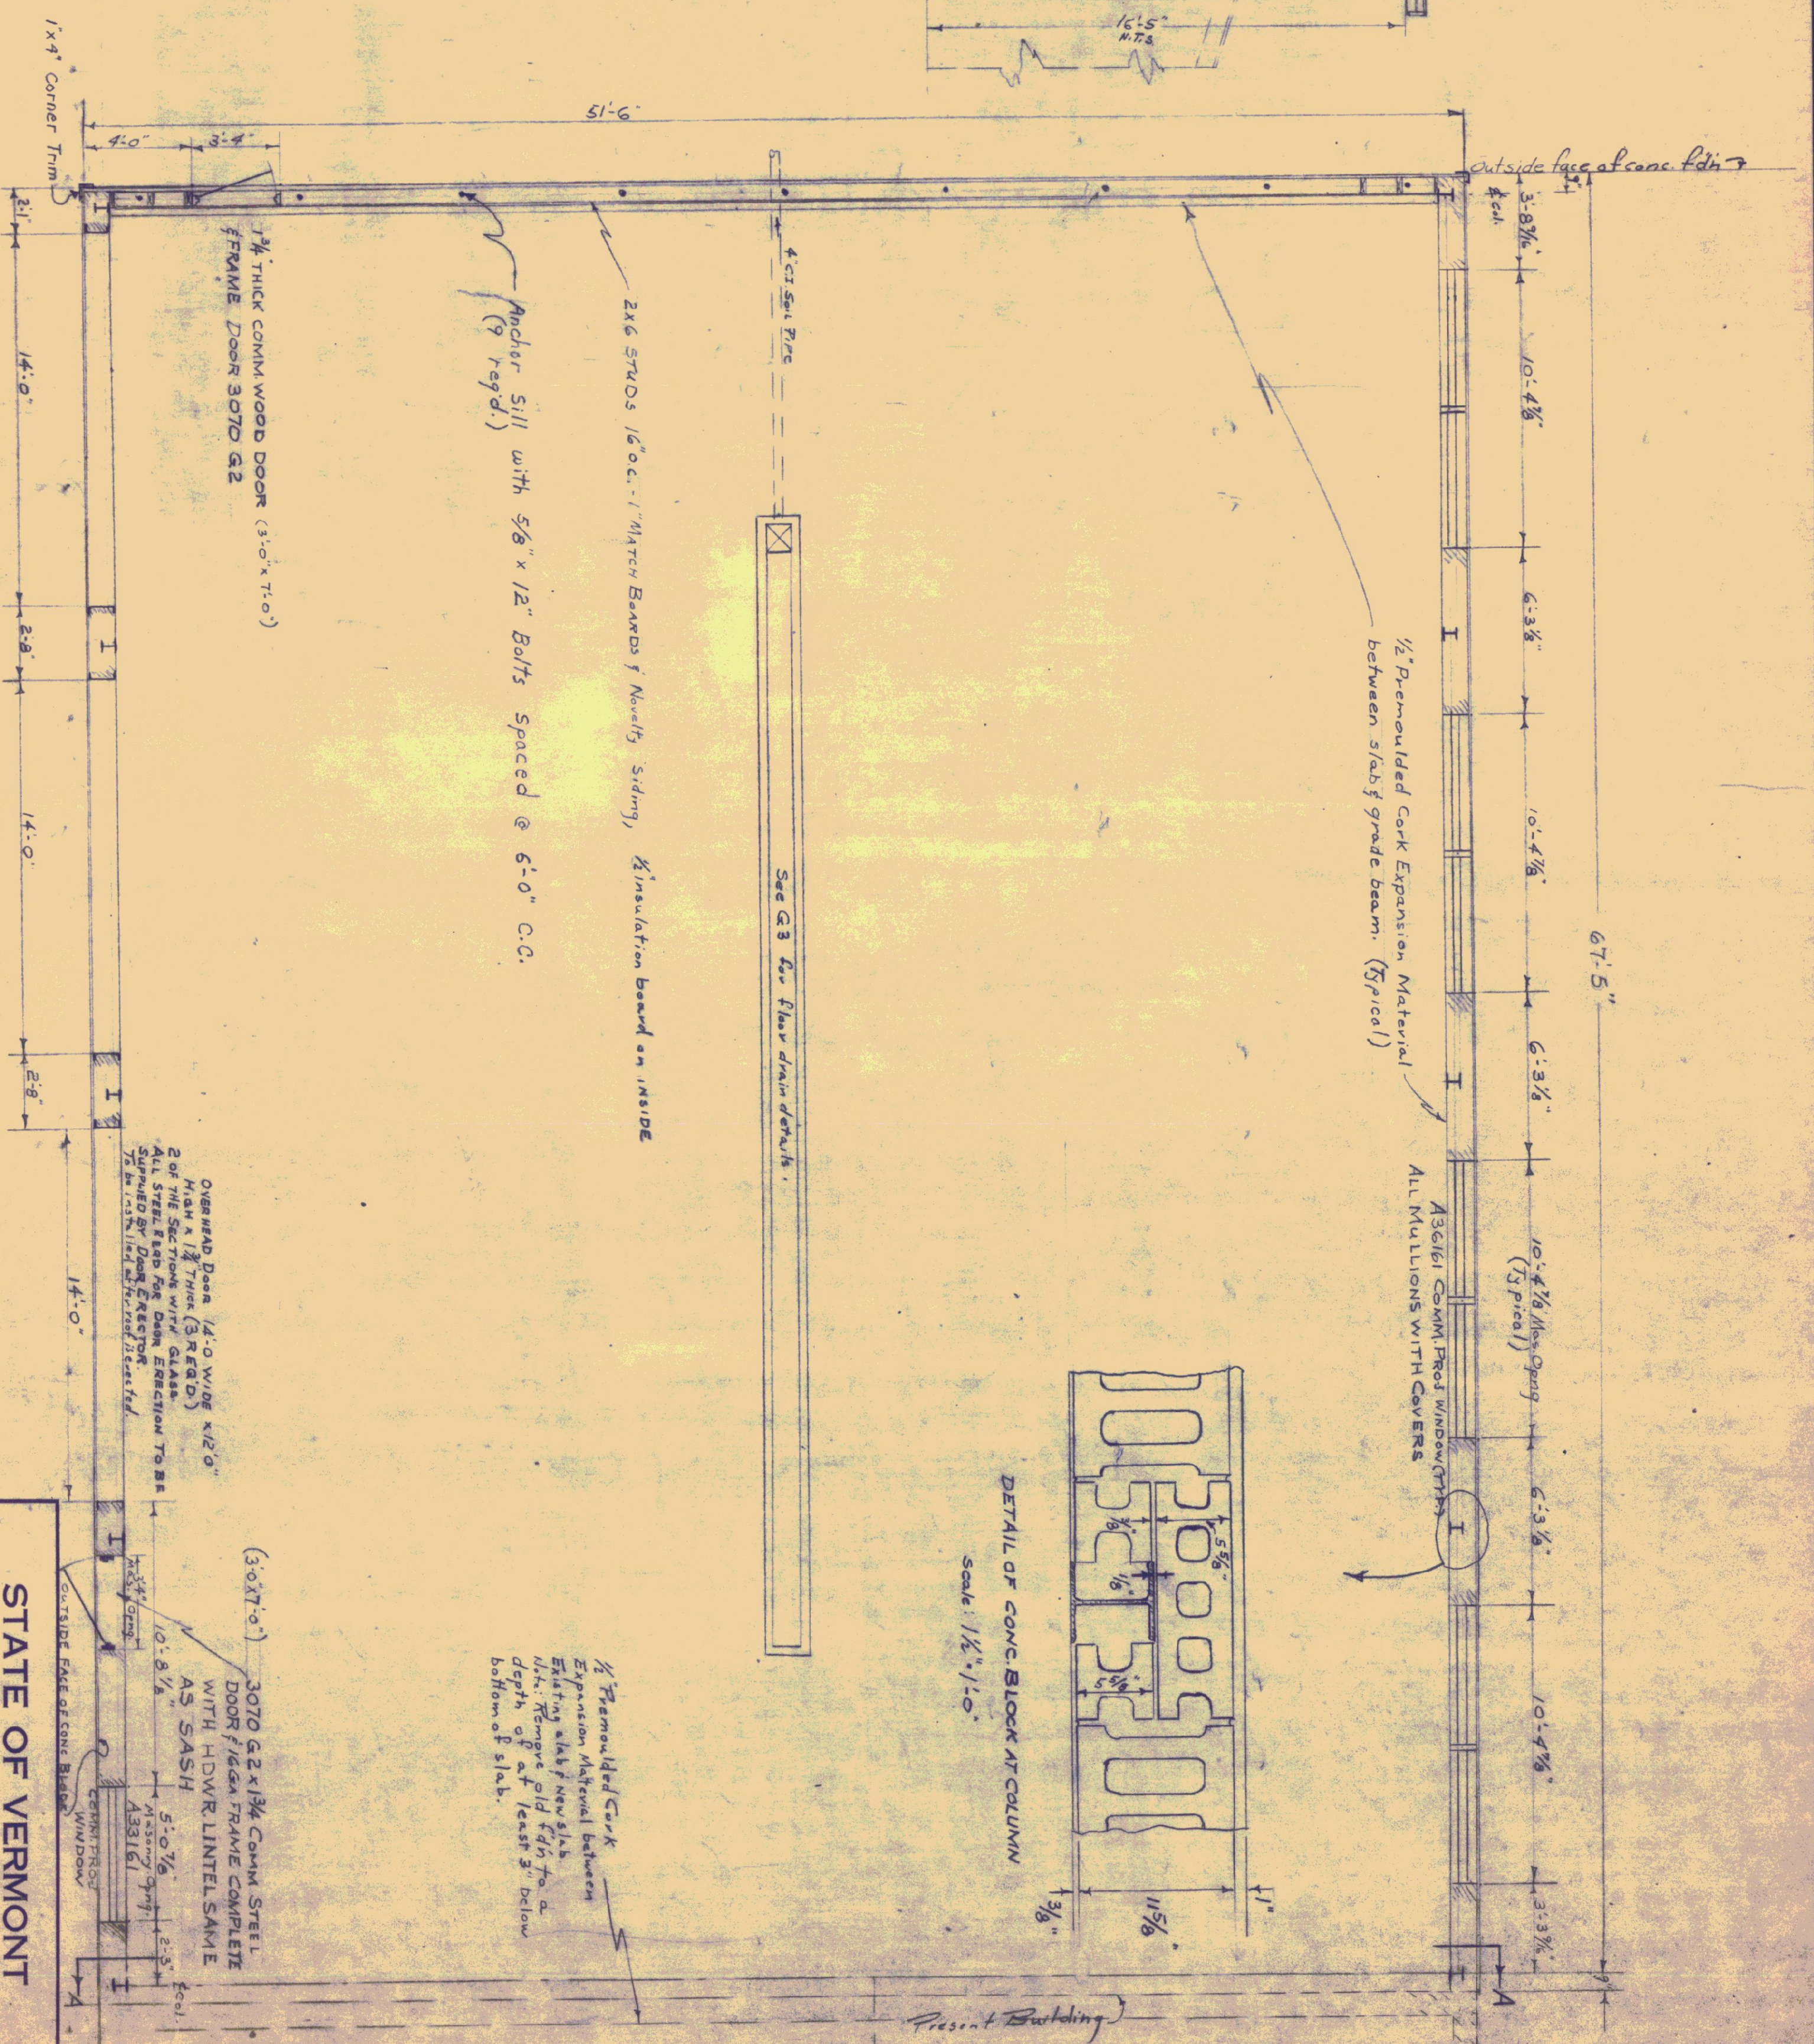

Approved Oct 3, 1960

Approved R. L. Conrad District Engineer

Approved C. T. Pielke Civil Engineer

Corrected Oct 5, 1960

Approved E. M. Brown Bridge Engineer

Note: Area within 6'-0" of building to have 2" bit concrete pavement.

Scale 1/8" = 1'

PLAN

LIST OF PLANS

- G-1 PLAN & ELEV.
- G-2 ELEVATIONS
- G-3 FOUNDATION
- G-4 FRAMING PLAN
- G-5 REIN. STEEL SCHEDULE

Height dropped 2' since 10/14/60. Elevation not to scale.

Overall Dimension shown on the north wall changed from 6'-9" to 6'-5" 9/29/60.

STATE OF VERMONT  
DEPARTMENT OF HIGHWAYS

TOWN OF BRADFORD  
ROAD NO. BRIDGE NO.  
DISTRICT # 7 GARAGE

PLAN & ELEVATION  
SCALE AS NOTED  
SURVEYED BY  
DRAWN BY STONE CHECKED BY E. W. C.  
PROJECT NO. 4 F.M.B. 10/29/60  
SHEET G-1 OF 5

W