


AGENCY OF TRANSPORTATION  
STATE OF VERMONT

FIVE BAY MAINTENANCE GARAGE  
ENOSBURG FALLS, VERMONT

MAY 20, 1991

AGENCY OF ADMINISTRATION  
DEPARTMENT OF STATE BUILDINGS  
2 GOVERNOR AIKEN AVENUE  
MONTPELIER, VERMONT 05602  
JOHN J. ZAMPIERI, COMMISSIONER

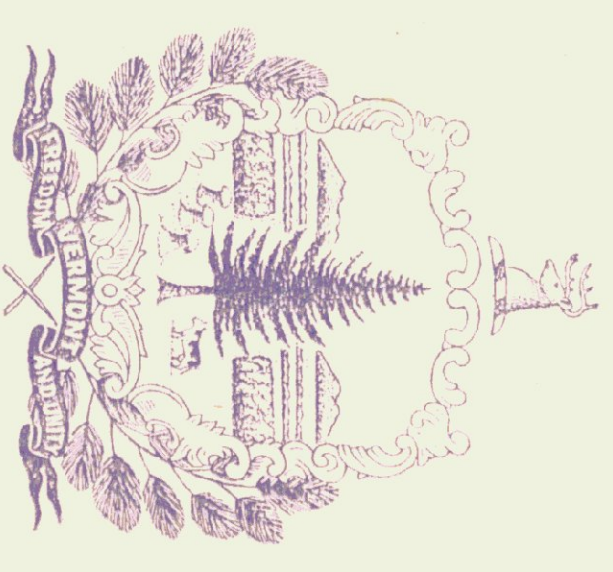

AGENCY OF TRANSPORTATION  
133 STATE STREET  
MONTPELIER, VERMONT 05602  
PATRICK J. GARAHAN, SECRETARY



*John J. Zamperini*

GOVERNOR RICHARD A. SNELLING

*Richard A. Snelling*

INDEX OF DRAWINGS

- SD-1 SITE PLAN
- SD-2 LANDSCAPING PLAN
- SD-3 FUEL TANK
- SD-4 ENTRANCE ROAD - SECTIONS & PROFILE
- A-1 FIRST FLOOR PLAN
- A-2 MEZZANINE LEVEL & ROOF PLAN  
DOOR & WINDOW SCHEDULES
- A-3 GARAGE ELEVATIONS
- A-4 INTERIOR ELEVATIONS & SECTIONS
- A-5 WALL PLANS & SECTIONS
- A-6 WALL SECTIONS & DETAILS
- A-7 DOOR, WINDOW & STAIR DETAILS
- A-8 STORAGE SHED
- A-9 SAND & SALT SHED
- S-1 FOUNDATION PLANS & SECTIONS
- S-2 SLAB PLAN & TRENCH DETAILS
- S-3 STRUCTURAL STEEL FRAMING  
@ ROOF & STEEL SECTIONS
- P-1 PLUMBING PLAN
- P-2 TYPICAL WATER & SEWER DETAILS
- P-3 WATER LINE PLAN & PROFILE
- P-4 SEWER LINE PLAN & PROFILE
- H-1 HEATING PLAN
- E-1 FIRST FLOOR LIGHTING PLAN
- E-2 FIRST FLOOR LIGHTING PLAN
- E-3 SITE PLAN, SCHEDULE & DETAILS

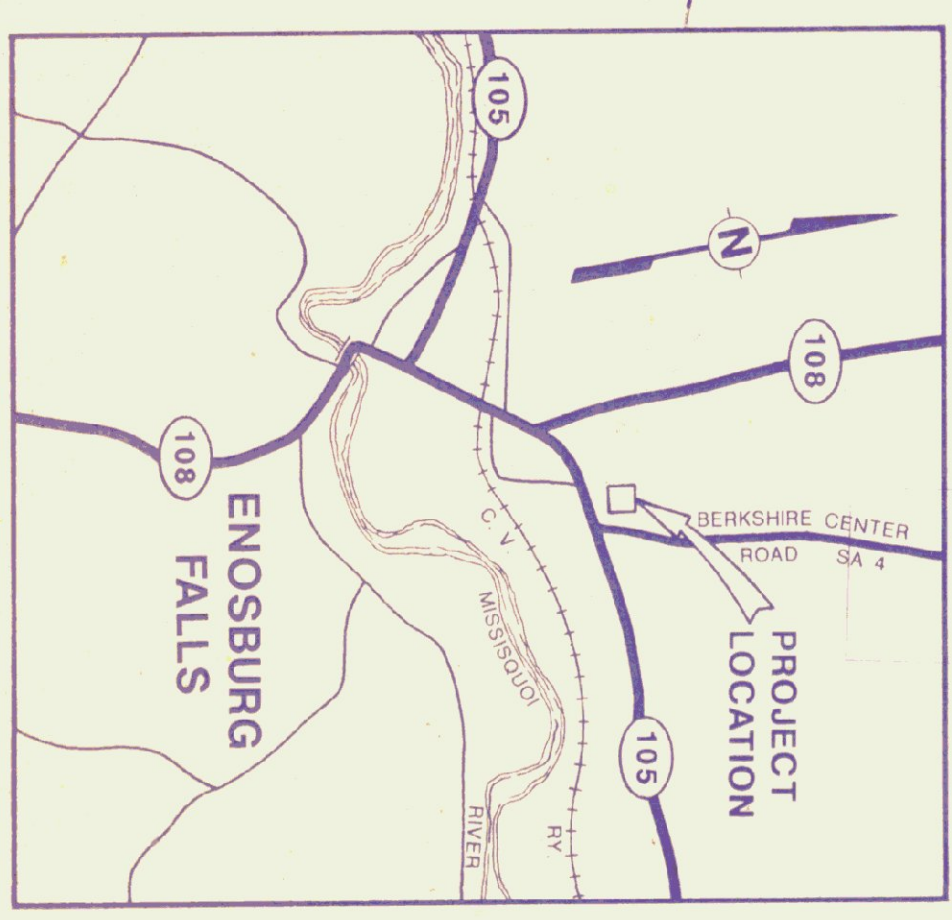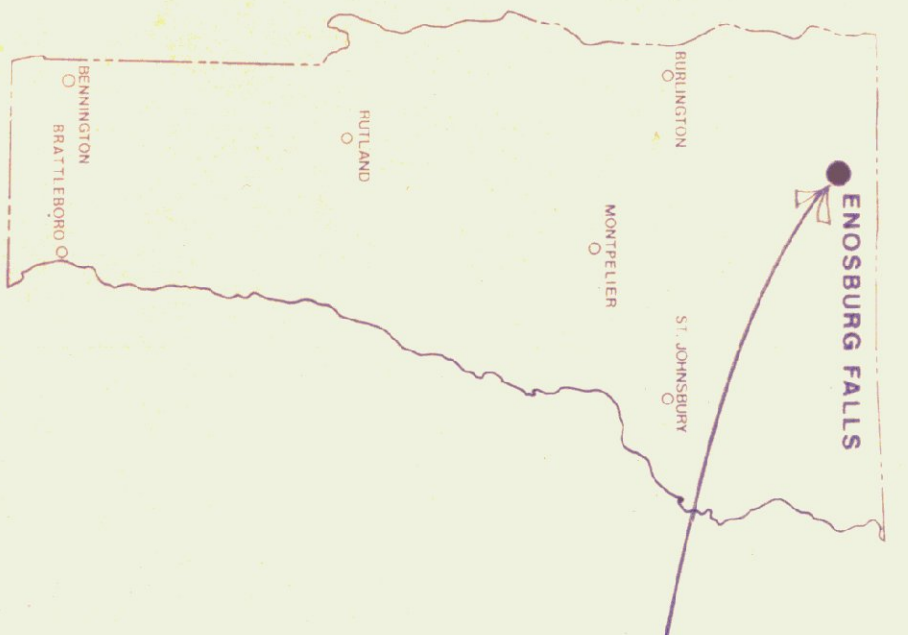

LOCATION MAP

*AS BUILT*

*Frank's*