




REVISIONS AS BUILT
--------------------

SCALE: AS NOTED
DATE: OCT 1997
DRAWN BY: G. D. NORWOOD
APPR BY: J.E.G.H.


BRIGHTON
WOOD FURNACE
FLOOR PLAN

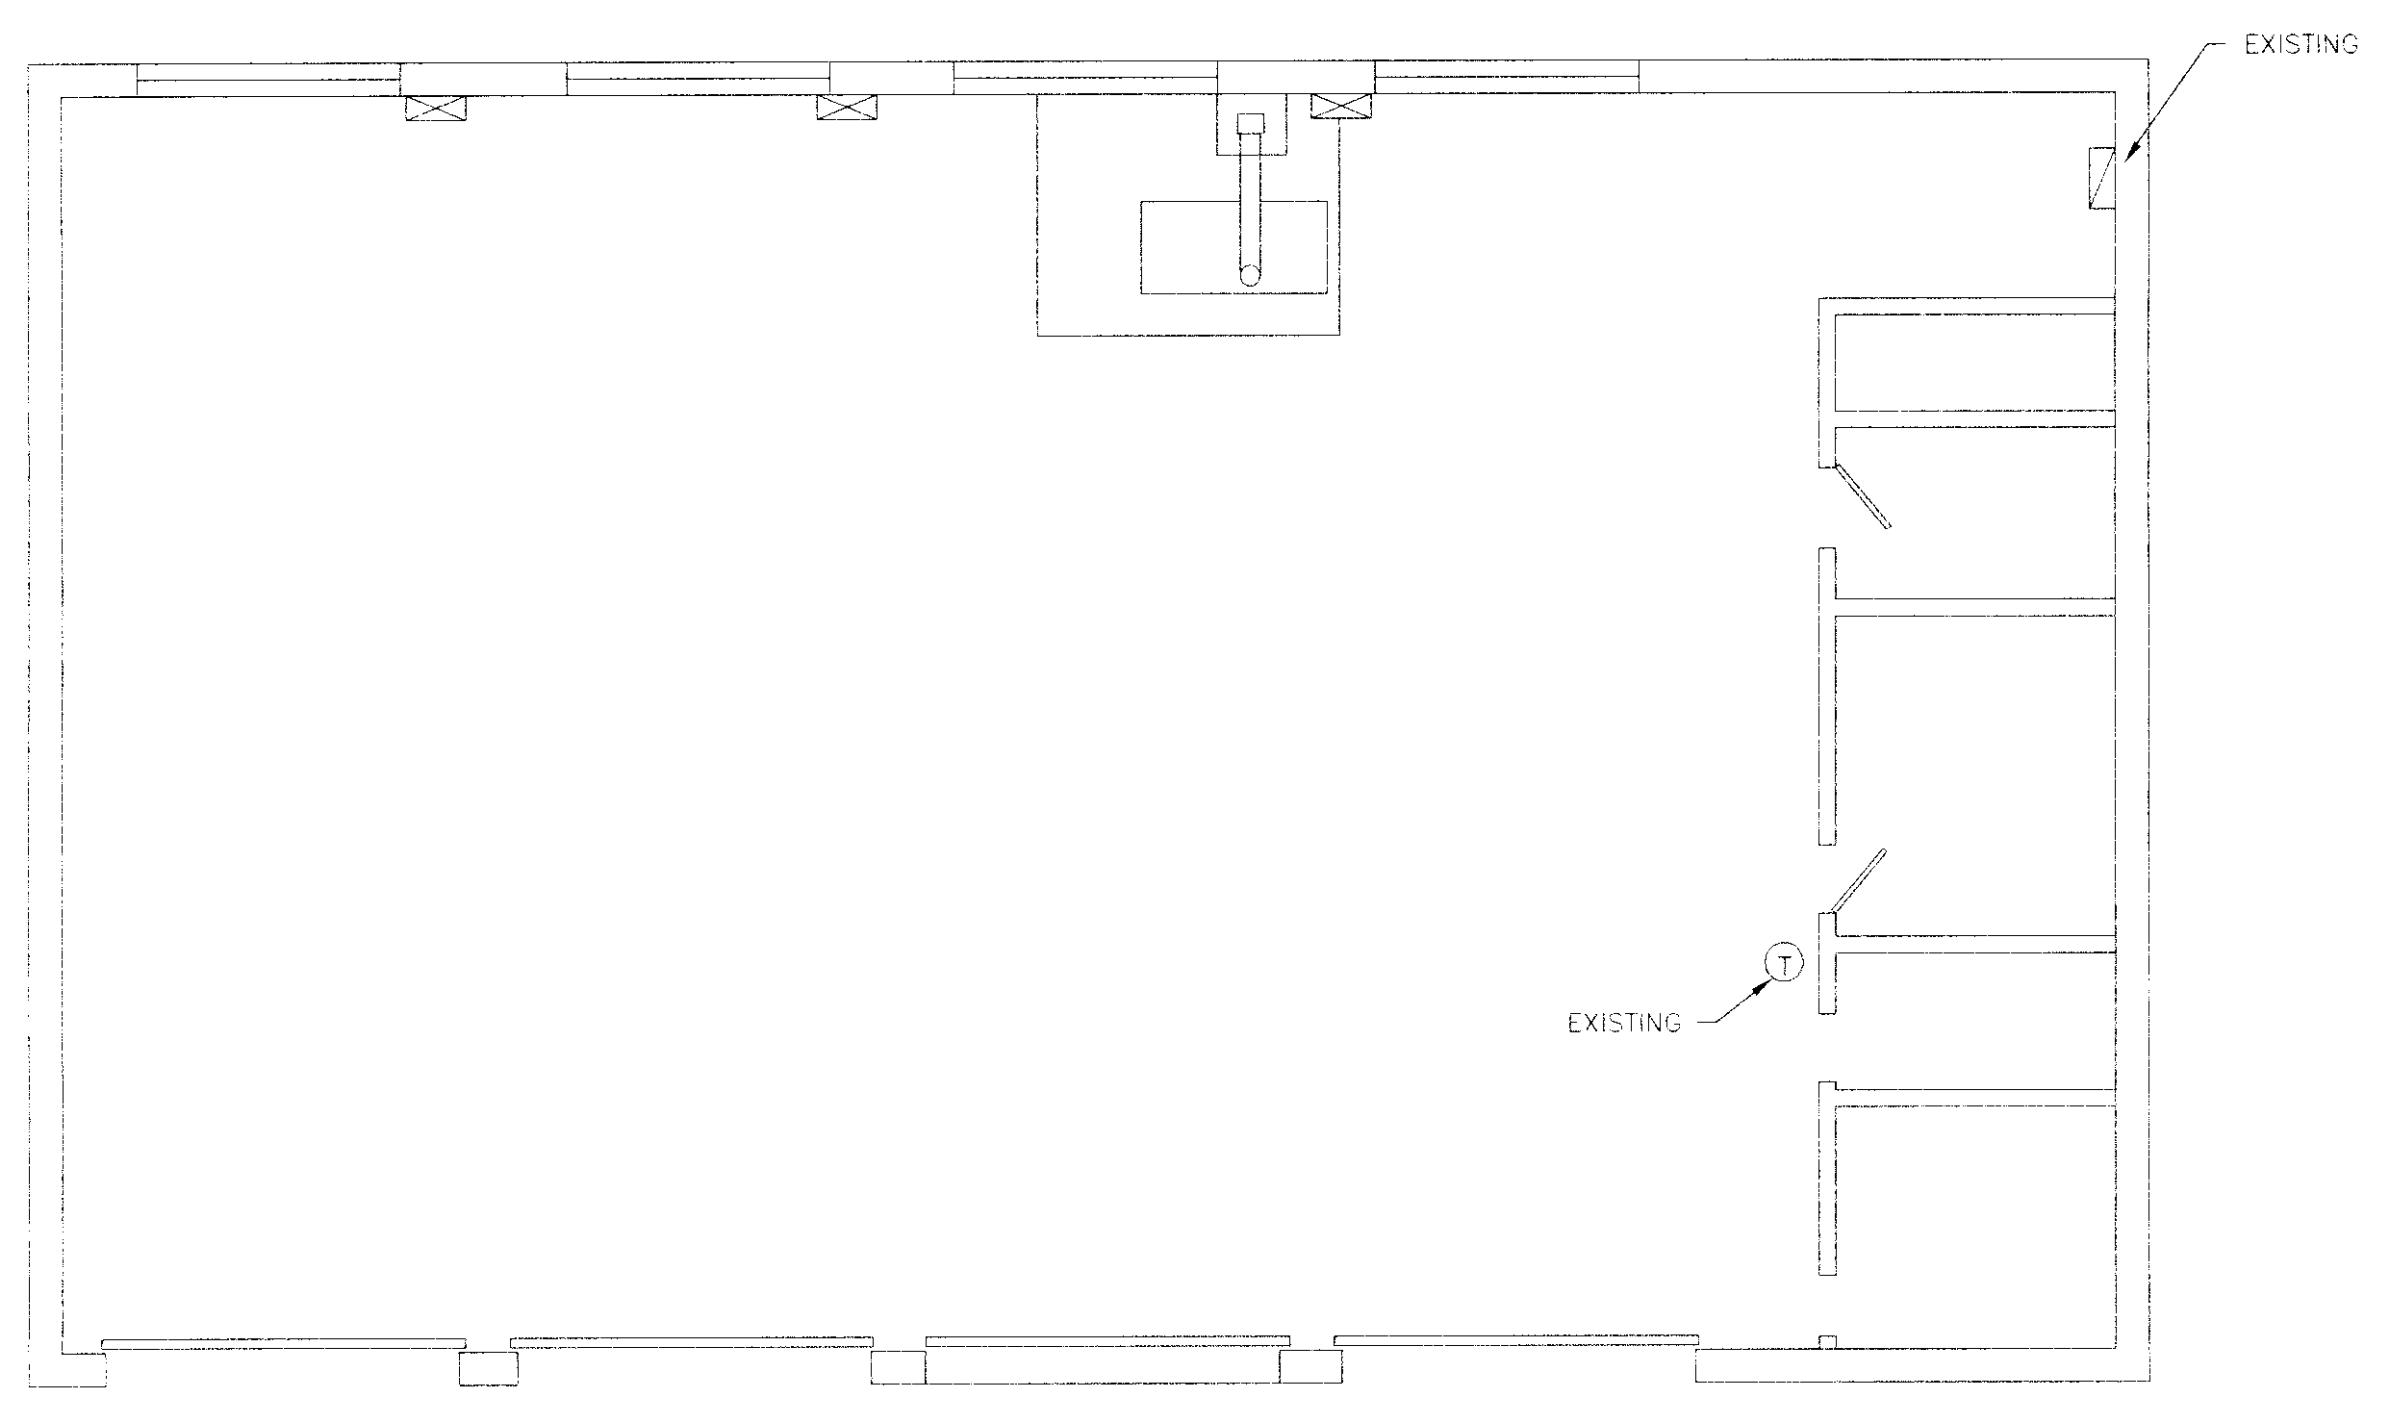



FLOOR PLAN  
 1/8" = 1'-0"

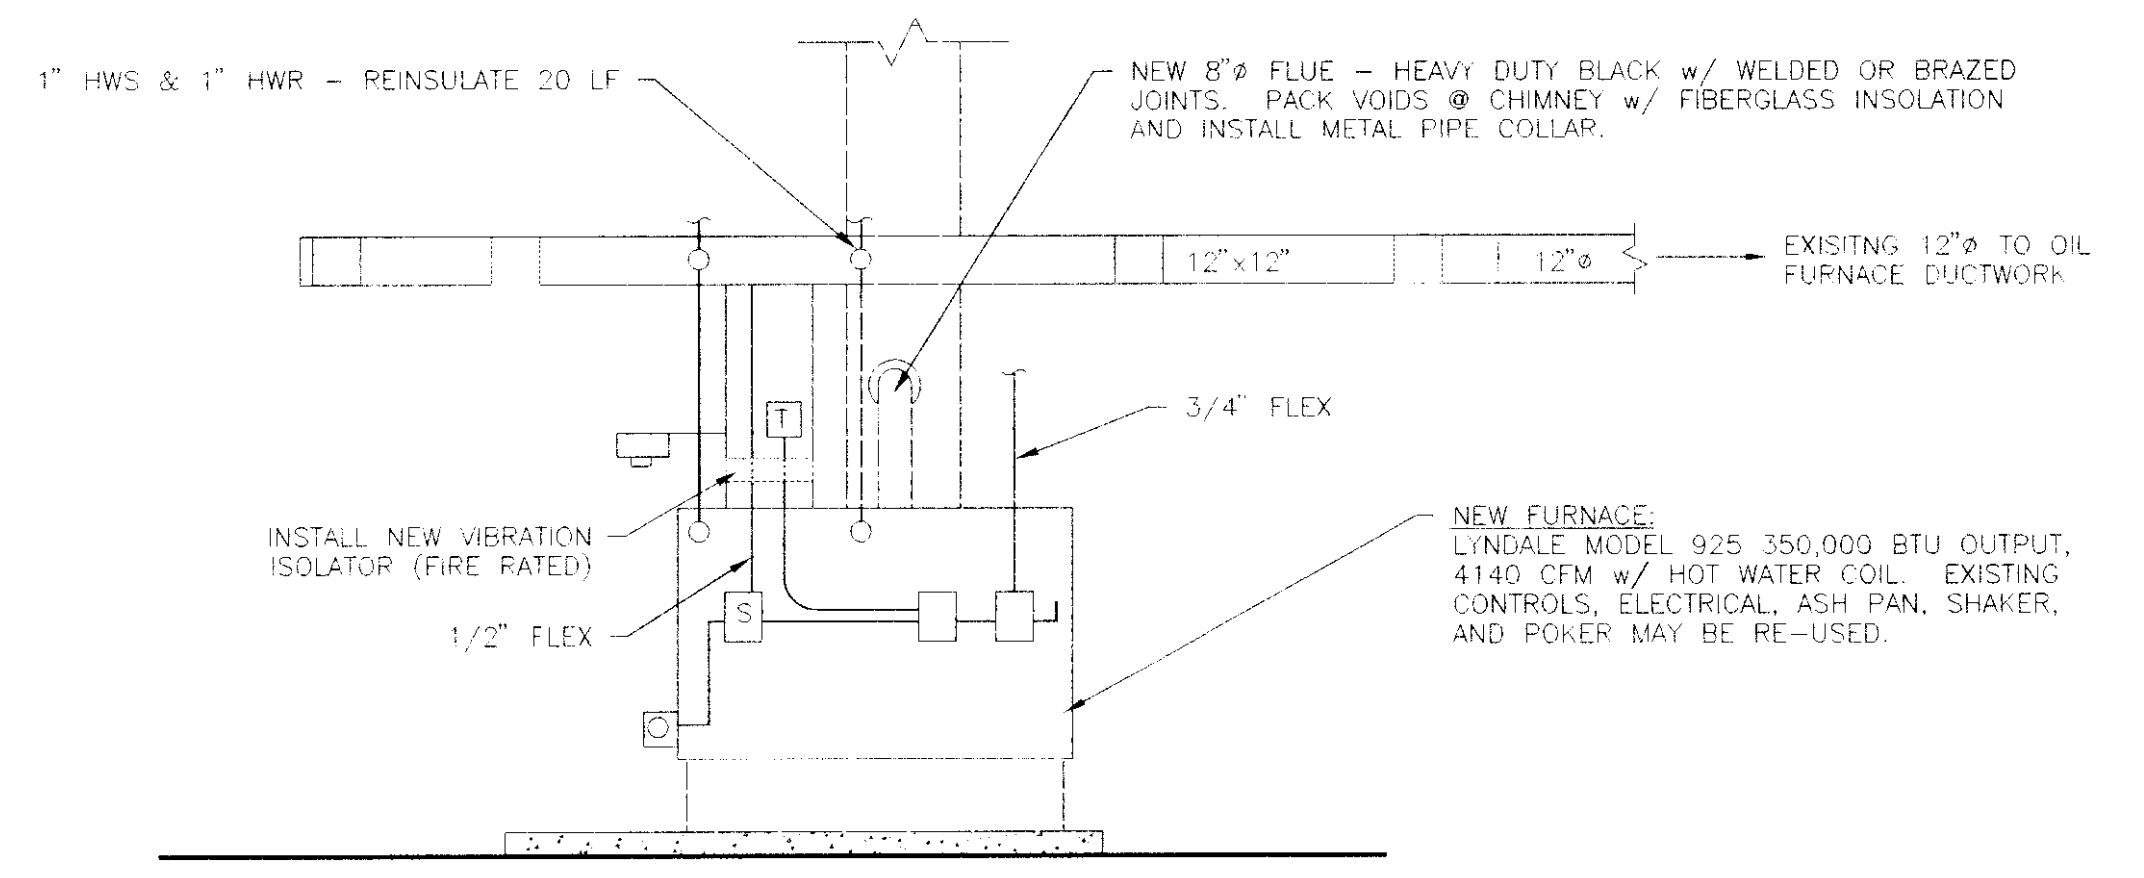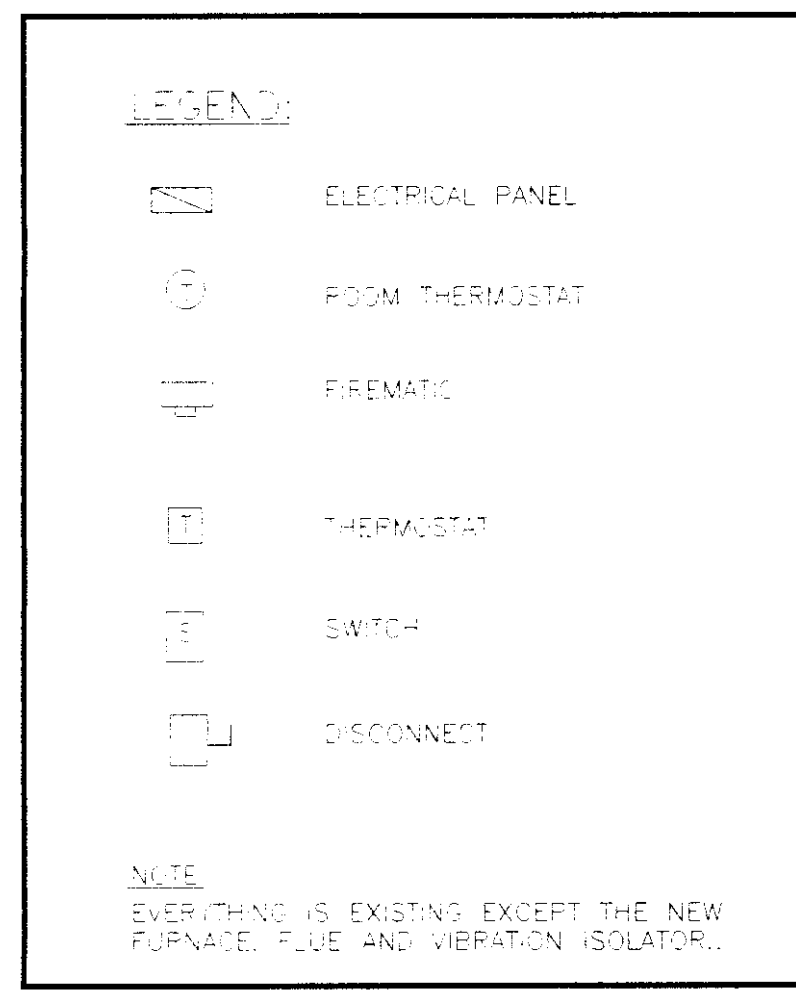

FURNACE ELEVATION  
 1/4" = 1'-0"

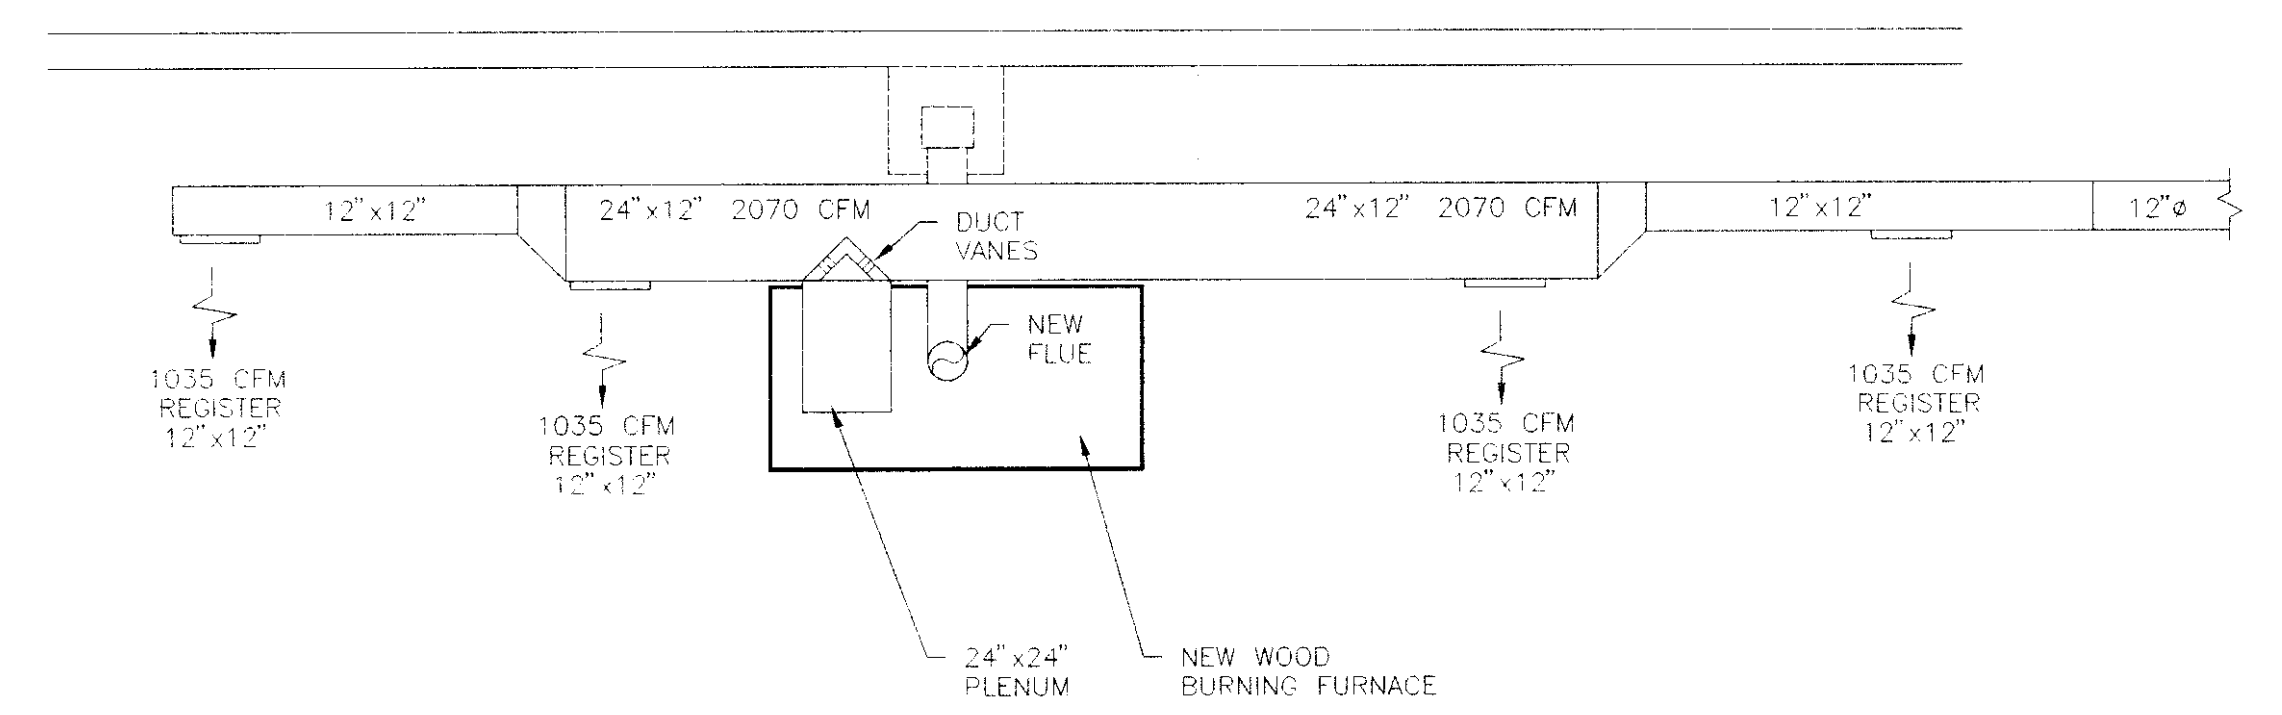

FURNACE PLAN  
 1/4" = 1'-0"

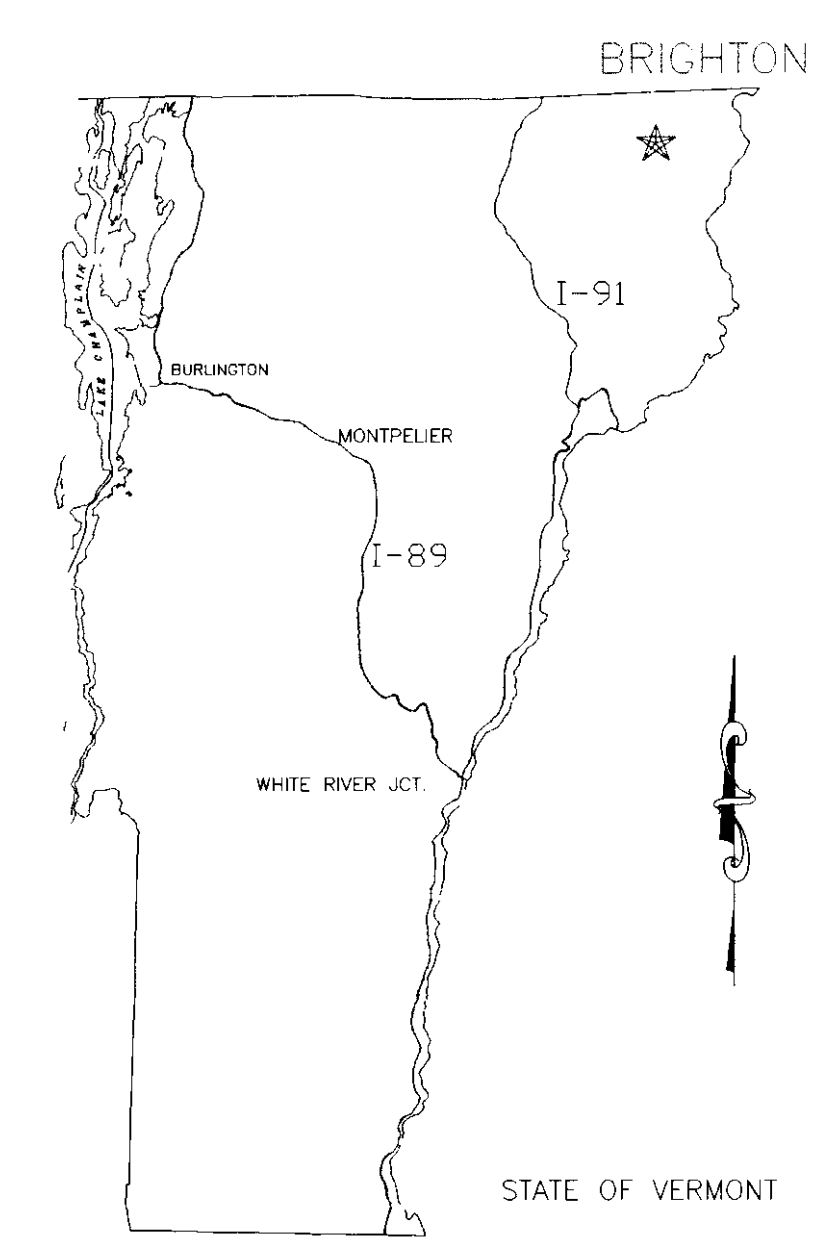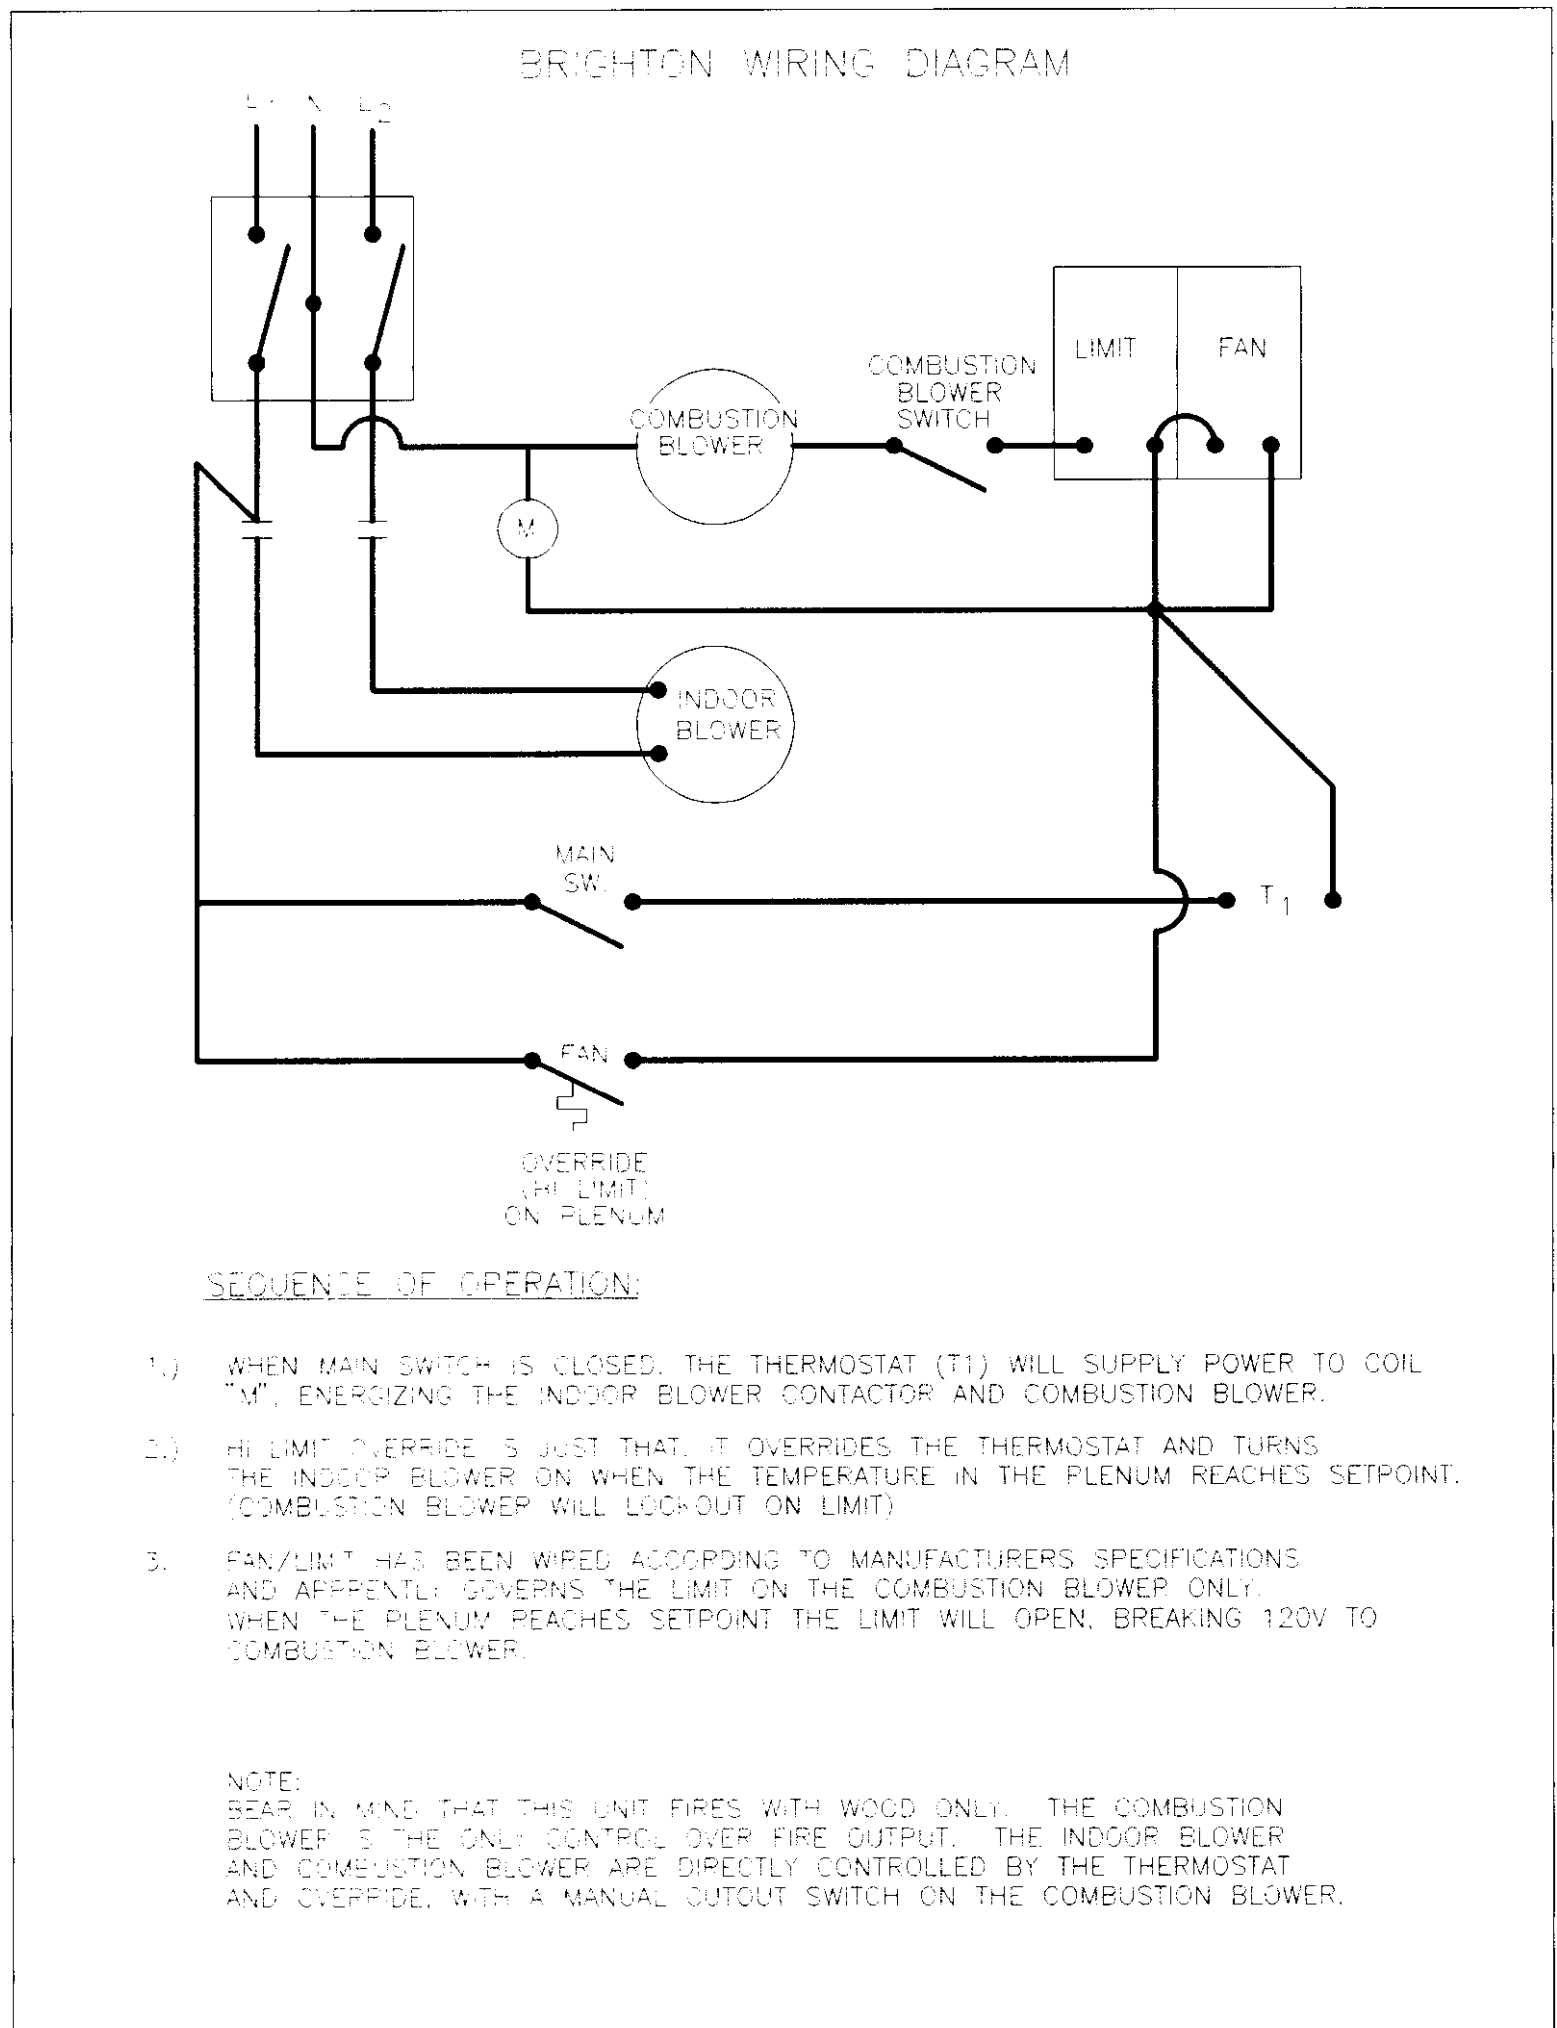

STATE LOCATION  
 N.T.S.