


NOTE: IN THE EVENT THAT ALT #1 (PAST THE VESTIBULE) IS ACCEPTED THEN THE SPACE SHD MUST CONTAIN FABRICA, GRAVEL STOP & ROOFING INCL. REPAIR ROOM FOR THIS AREA

SCUPPER DET 2/A/B
4 REQ. SEE DET 2/A/B
REMOVE EXISTING SCOPPER DOWN TO WD DECK. ADD 2" APPLIED FT. HALLETS. 2" x 2" TYP. 1/2" WD BRCK. # ROOFING MEMBR. & LIGHT INT. CONC. ROOF FANWAYS / 24" x 24" DIA.

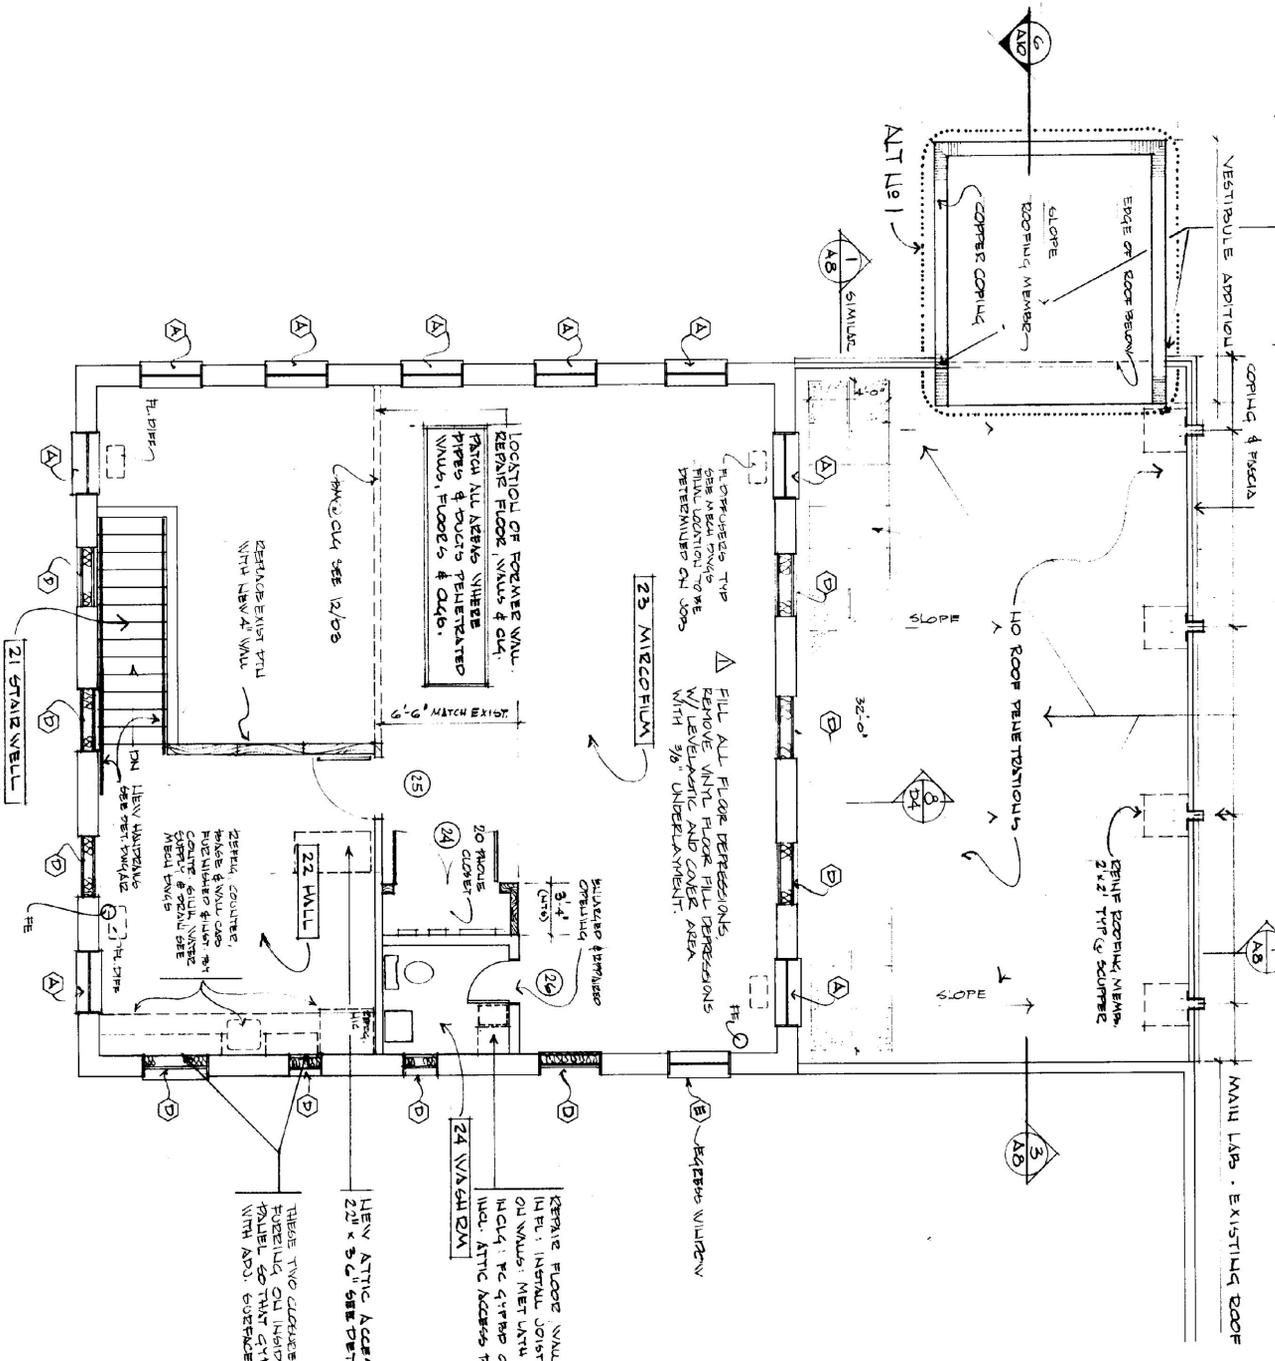


SECOND FLOOR PLAN

SCALE = 1/4"=10'




NOTES:
1. REFER TO A4 FOR GENERAL NOTES
SCHEDULES: SEE DWG A12
A = WINDOW TYPE
B = WINDOW CLOSURE
2. SEE APPL. LETTERS DWG A7 & R1

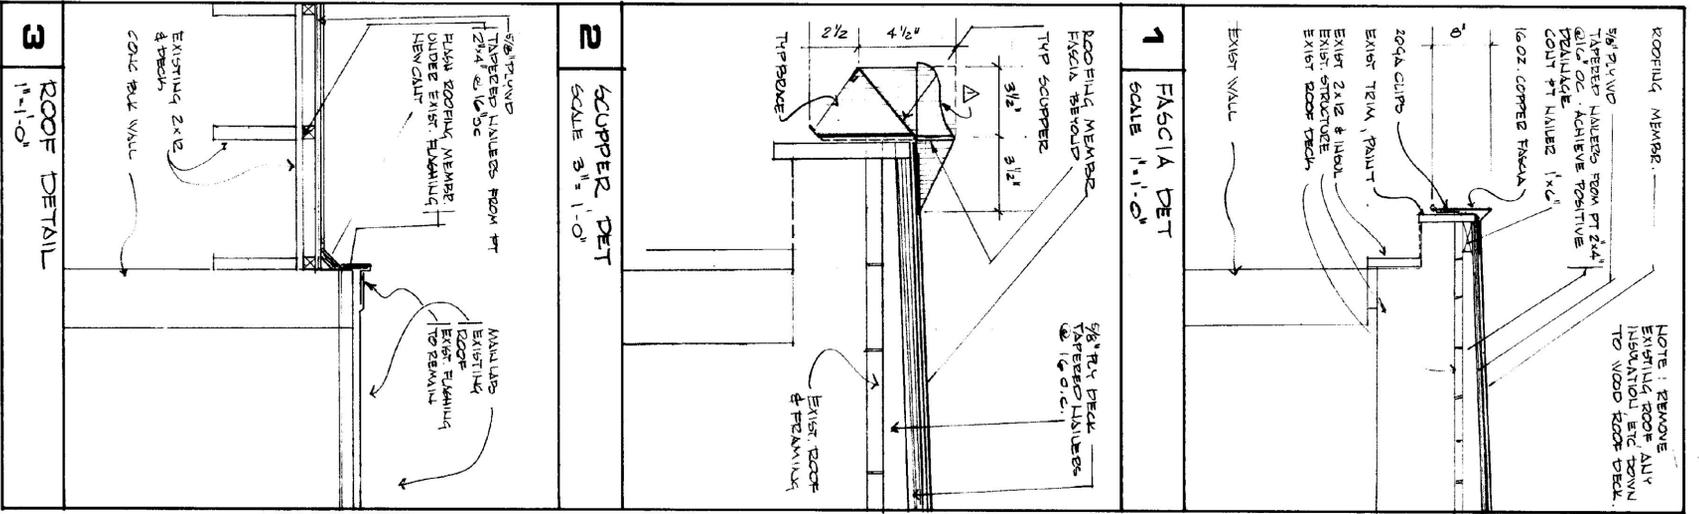

State of Vermont
Department of State Buildings
John Zampieri, Commissioner

Materials & Research
Laboratory
Berlin, Vt.
PHASE II

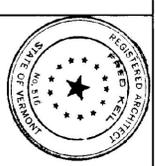

Janson Design, Inc.
REG. ARCHITECT
P.O. BOX 55 - BRIDGE
(802) 244-4800

SECOND FLOOR PLAN
DATE: APRIL 20 1990
DWG. NO. A 8

REVISIONS: Δ - AS BUILT REV. DEC. 1991
5. A. Q. D. REV.
1. CH. ALT #2 TO ALT #1
2. CH. WIND & BASE
3. REMOVE CL. CEMENT