



BASEMENT FLOOR PLAN - DEMOLITION  
1/4" = 1'-0"

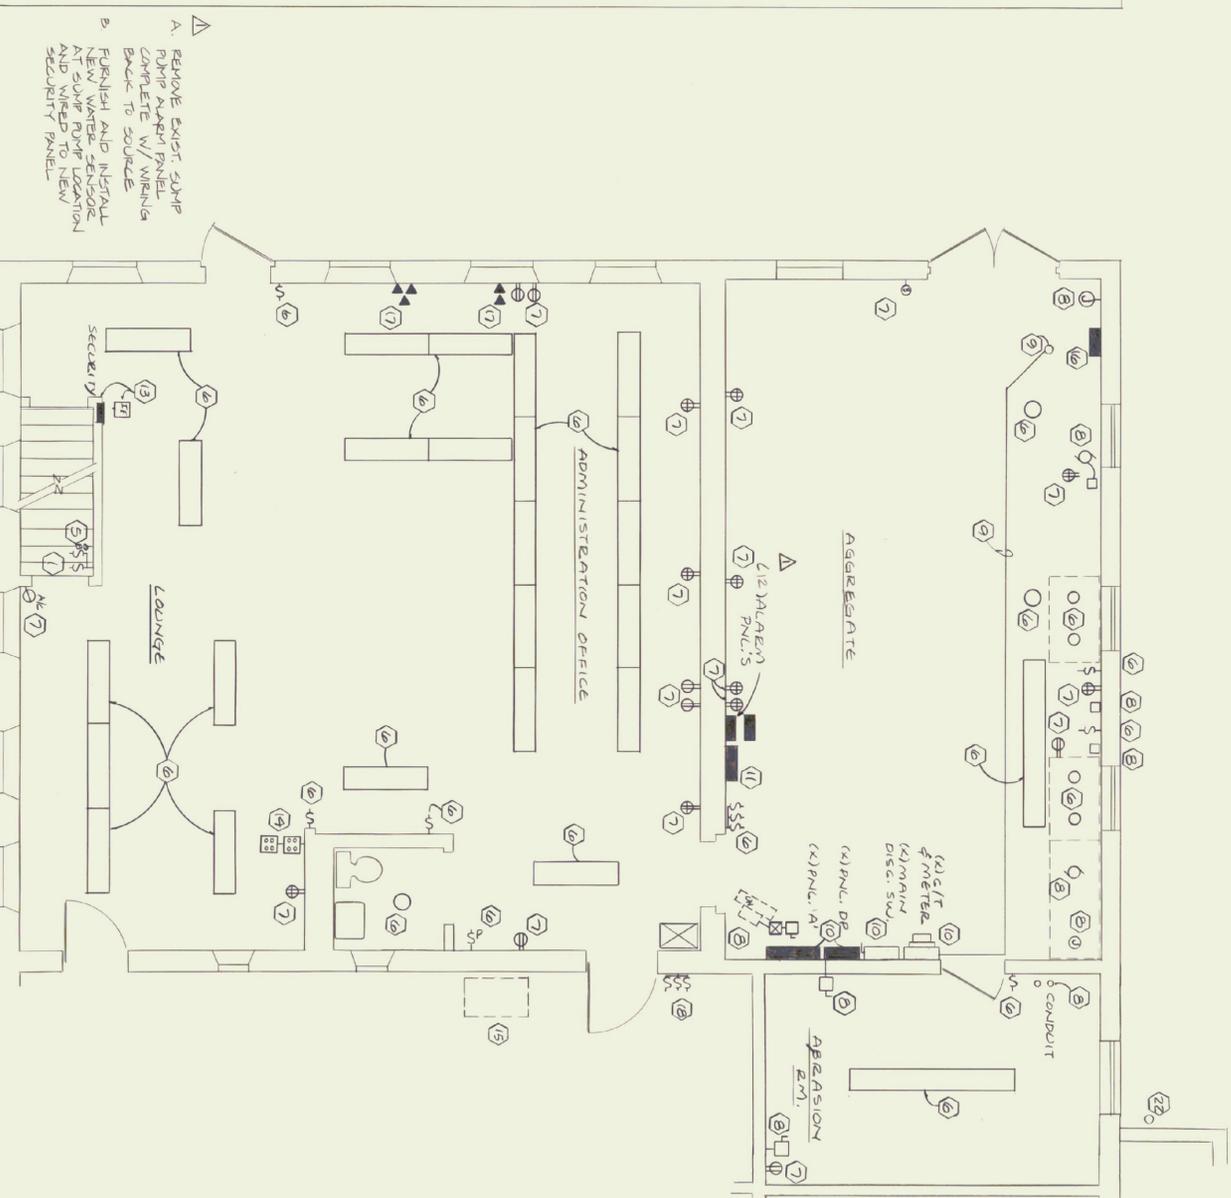

FIRST FLOOR PLAN - DEMOLITION  
1/4" = 1'-0"

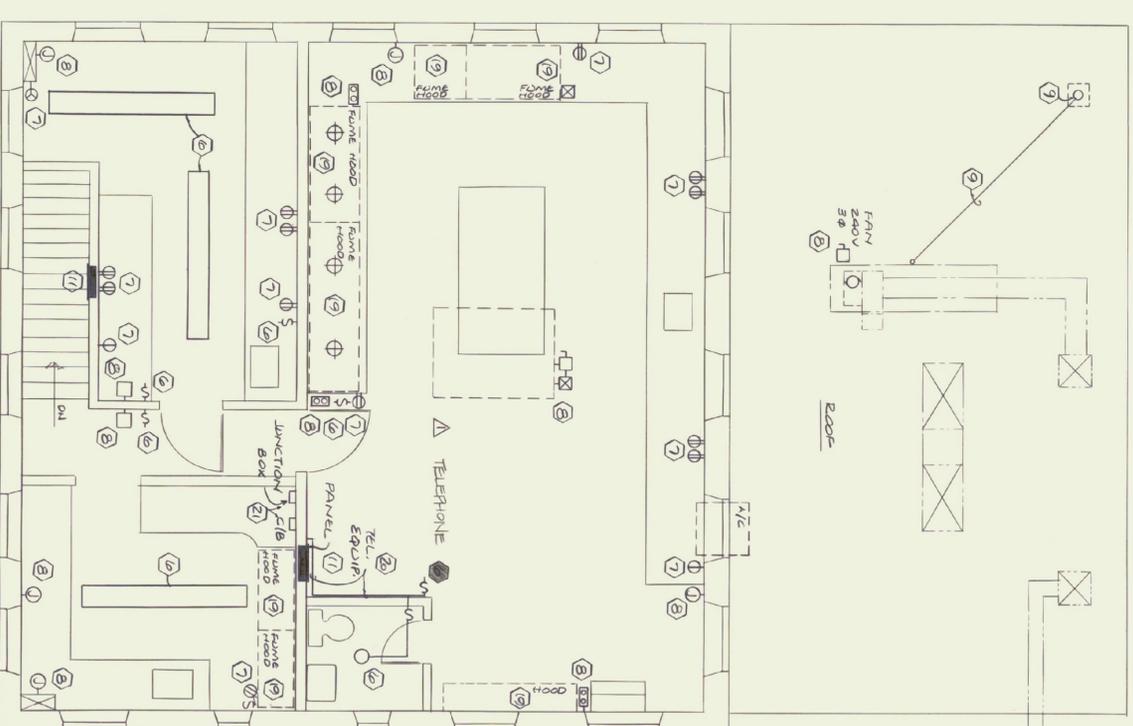

SECOND FLOOR PLAN - DEMOLITION  
1/4" = 1'-0"

NOTES - DEMOLITION

1. EXISTING LIGHT FIXTURES TO BE REMOVED COMPLETE WITH CONDUIT, AND WIRE TO NEW PANEL, INCLUDING TO CONTROL SWITCH.
2. REMOVE EXISTING SUMP PUMP, CONTROL AND FLOAT'S COMPLETE WITH RECEPTACLE TO NEW PANEL. FURNISH AND INSTALL NEW DUPLEX AND WIRE BACK TO SOURCE.
3. REMOVE EXISTING DISCONNECT SWITCHES COMPLETE WITH CONDUIT AND WIRE BACK TO SOURCE.
4. REMOVE EXISTING TELEPHONE CONDUIT AND CABLE COMPLETE BACK TO SOURCE.
5. REMOVE EXISTING BOTTLE WIRING AND EMERGENCY OIL BURNER SWITCH COMPLETE BACK TO SOURCE.
6. REMOVE EXISTING LIGHTING FIXTURES AND SWITCHING COMPLETE WITH CONDUIT AND WIRING BACK TO SOURCE.
7. REMOVE DUPLEX AND SINGLE RECEPTACLES COMPLETE WITH BOXES, CONDUIT AND WIRING BACK TO SOURCE.
8. REMOVE EXISTING POWER WIRING TO MECHANICAL EQUIPMENT COMPLETE WITH CONDUIT AND WIRING BACK TO SOURCE.

9. REMOVE EXISTING ELECTRICAL SERVICE COMPLETE WITH CONDUIT AND WIRE AFTER NEW SERVICE IS INSTALLED AND UNDER OPERATIONAL.
10. REMOVE EXISTING WIRING FROM ROOM AND OFF WIRE OVERHEADS.
11. REMOVE EXISTING WIRING, WIRING EQUIPMENT, MAIN RECONNECT, AND WIRE BACK TO SOURCE. EXISTING EQUIPMENT TO REMAIN OPERATIONAL UNTIL NEW SERVICE AND DISTRIBUTION EQUIPMENT IS INSTALLED.
12. REMOVE EXISTING SECURITY PANELS COMPLETE WITH CONDUIT AND WIRING BACK TO SOURCE INCLUDING SHARED CIRCUIT WIRING.
13. REMOVE EXISTING SECURITY PANELS COMPLETE, FURNISH AND INSTALL NEW REMANUAL STRIP PANEL FOR EXISTING ALARM SERVICE WIRING TO EXISTING TELEPHONE LINE TO BE RE-ROUTED TO NEW EQUIPMENT.
14. REMOVE EXISTING SECURITY KEY PAD AND ALARM SENSOR COMPLETE WITH WIRING BACK TO SOURCE.
15. REMOVE EXISTING PLUMBING SERVICE COMPLETE WITH CONDUIT AND WIRING BACK TO SOURCE INCLUDING ALL SHARED SERVICE WIRING.

15. DISCONNECT EXISTING POWER WIRING TO EXISTING A/C CONDENSING WIRING AND REMOVED COMPLETE WITH ALL NECESSARY CONDUIT.
16. REMOVE EXISTING TELEPHONE CABINET AND WIRING.
17. REMOVE EXISTING TELEPHONE OUTLETS AND WIRING.
18. REMOVE EXISTING LIGHT SWITCHES COMPLETE AND INSTALL NEW SWITCHES, BOXES, RECEPTACLES AND WIRING AT NEW LOCATION AND REWIRE AS REQUIRED TO EXISTING LIGHT SWITCHES.
19. REMOVE EXISTING POWER WIRING TO ALL HOODS COMPLETE WITH CONDUIT AND WIRING BACK TO SOURCE.
20. TELEPHONE EQUIPMENT TO REMAIN AS IS. PROVIDE NEW POWER AS SHOWN.
21. REMOVE EXISTING JUNCTION BOX, CIRCUIT BREAKER, CONDUIT AND WIRING BACK TO SOURCE.
22. EXISTING BRPPLY 4" PVC TO REMAIN AND SHALL BE EXTENDED INTO SERVICE BOX AND NEW CONDUIT TO INDICATE SHOP FOR NEW ELECTRIC SERVICE.
23. EXISTING A/C UNIT ON ROOF TO REMAIN EXCEPT TO BE REMOVED TO NEW CIRCUIT DUE TO PANEL CHANGES.

REVISIONS:

Δ - AS BUILT REV. DEC. 1991



**Wolbach Engineering, Inc.**  
Consulting Engineers  
20 Lombard Ave. Ste. 103 S. Burlington, VT 05403  
(802) 658-4044

State of Vermont  
Department of State Buildings  
John Zampieri, Commissioner

Materials & Research  
Laboratory  
PHASE II  
Berlin, VT

Jonson Design, Inc.  
FRED KELL, ARCHITECT  
P.O. BOX 55 - BOLTON ROAD, WATERBURY, VT 05678  
(802) 244-5800

DEMOLITION  
ELECTRICAL

DATE: 4-26-90  
DWG. NO. E-3