


ROOM	SYMBOL	EQUIPMENT SCHEDULE	REMARKS
ROOM	SYMBOL	LABEL	NAME
#10 - AGGREGATE LAB	34		OVEN
	35		OVEN
	36		GRINDER
	37		GILSON BRANER
#11 - FOG ROOM	38		BALANCE
	39		BALANCE
	40		RO-TAP
#12 - STRUCTURAL LAB	41		BATH
	42		BALANCE
	43		WEAR TESTER
	44		WEAR TESTER
	209		CONCRETE SAW
	210		DUST HOOD
	211		DUST HOOD
	300		AIR COND.
			INSTALLED BY CENTER.

ROOM	SYMBOL	BUILT-IN SCHEDULE	REMARKS
ROOM	SYMBOL	LABEL	NAME
#10 - AGGREGATE LAB	B1		COUNTER
	B2		COUNTER
	B3		COUNTER
	B4		COUNTER
	B5		COUNTER
	B6		COUNTER
	B7		SHELVING
#11 - FOG ROOM			

ROOM	SYMBOL	FURNITURE SCHEDULE	REMARKS
ROOM	SYMBOL	LABEL	NAME
#10 - AGGREGATE LAB	F102		DESK (LAWN)
#12 - STRUCTURAL LAB	F103		TABLE

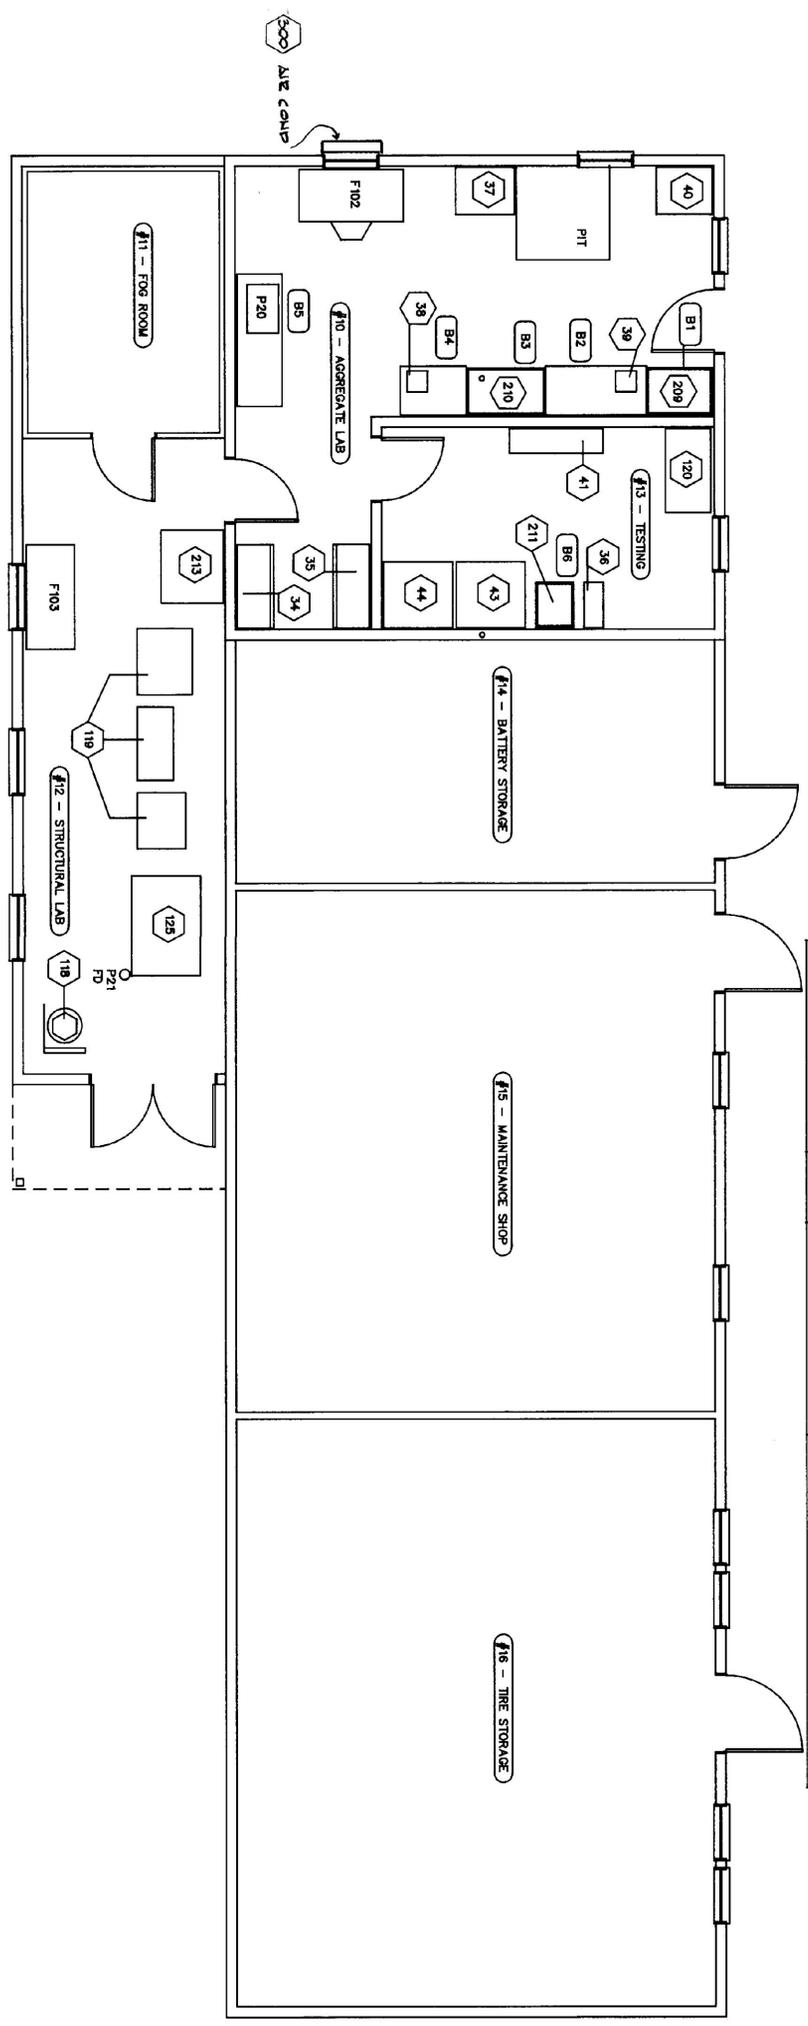

STRUCTURAL & AGGREGATE LAB
FLOOR PLAN
SCALE: 1/4" = 1'-0"

State of Vermont Department of State Buildings John Zampieri, Commissioner	State Highway Laboratory Berlin, VT Project No. 247		Jonson Design, Inc. <small>100 N. BURLINGTON AVENUE BURLINGTON, VERMONT 05401 (802) 244-9600</small>	DATE: OCT 16 89	DWG. NO. L1
EQUIPMENT LAYOUT REV. NOV 6 1989					