



PLUMBING PLAN
SCALE - 1/2"=1'-0"

PLUMBING SCHEDULE


- ⊗ BALL VALVE
- ⊕ CONNECT TO EXISTING
- PIPE DOWN
- PIPE UP
- COLD WATER
- HOT WATER
- WASTE
- - - VENT

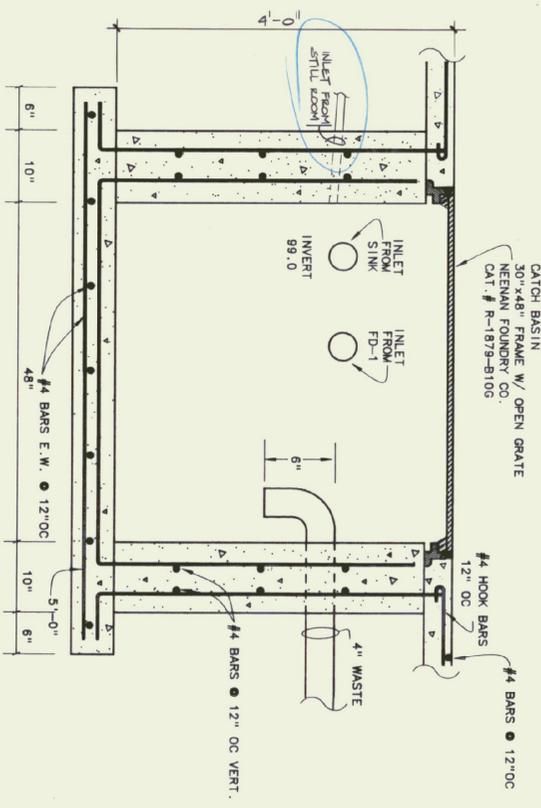

CATCH BASIN
SCALE - 1"=1'-0"

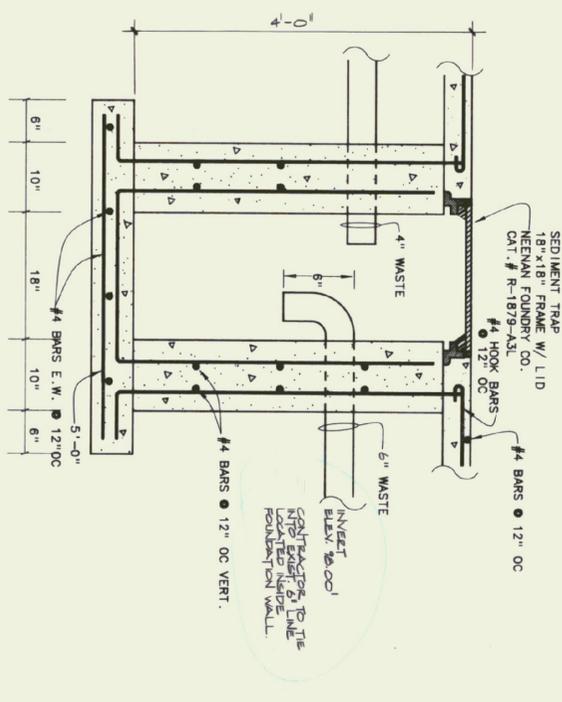

SEDIMENT TRAP
SCALE - 1"=1'-0"

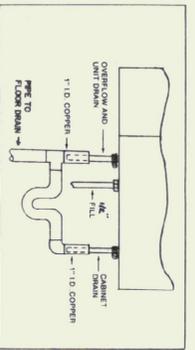

HUMIDIFIER WATER SUPPLY & DRAIN
NO SCALE

ITEM	DESCRIPTION
AC	AIR CONDITION CONDENSING UNIT, MCOQUAY MODEL AD039H, 208 VOLT, 3 PHASE R-22 REFRIG., 3700 NOML. COOLING WATTS, @ 95 DEGREES F OA, 80 DEGREES F DB, 67 DEGREES F WB
FC	FAN COIL, MCOQUAY MODEL, SC8 121 B. BELT DRIVE, 1/2 HP @ 120 VAC, 1200 CFM, HO-CAPACITY DX COIL, 40,000 BTU TOTAL, @ 80 DEGREES F DB/67 DEGREES F WB, 45 DEGREES F SUCTION TEMP., 1 ROW HEATING COIL, 56,000 BTU TOTAL HEATING @ 2 PSIG STEAM, 80 DEGREES F EAT.
HUMIDIFIER	ELECTRONIC STEAM HUMIDIFIER, 30 LBS/HR., HERMIDRIFER MODEL MIST-30, 208 VOLT, 3 PHASE EST -11118 DUCT DISTRIBUTION MANIFOLD, STEAM SUPPLY HOSE, HUMIDISTAT, DUCT HI LIMIT, DUCT AIR PROVING SWITCH
HRU	HEAT RECOVERY EXHAUST AND MAKE-UP AIR UNIT, EXHAUST 1000 CFM @ 25 ESP, SUPPLY 1200 CFM @ 2 ESP, (2) 1/2 HP, 115 VAC, HEAT EXCHANGER 200 B-1, WEATHER-PROOF CASING FOR OUTDOOR INSTALLATION (INCLUDES INTAKE AND EXHAUST HOODS WITH BIRD SCREENS AND WEATHER-PROOF ROOF PANELS WITH RAIN GUTTERS), BOTTOM SLIPPLY AND/OR RETURN DUCT CONNECTIONS, 12" INSULATED ROOF CURBS WITH INTEGRAL CANT, FACE AND BYPASS FROST CONTROL SYSTEM, ALUMINUM INTERIOR WALLS
HOOD	EXHAUST HOOD, 304 STAINLESS STEEL, 48" WIDE X 30" DEEP X 18" HIGH, 18" X18" OUTLET, UNITE MCGILL OR EQUAL, FIELD MEASURE OUTLET LOCATION AND TRANSITION TO AVOID INTERFERENCE WITH EXISTING DUCT.
SR-1	SUPPLY REGISTER, METAL ARE SERIES 5.000, MODEL MA1, SA, 12" X 12" WOOD, ALUMINUM W/WHITE FINISH, EXPOSED INSTALLATION 10'-0" ABOVE FLOOR TO FACE

ITEM	DESCRIPTION
S-1	AMERICAN STANDARD ENAMELED CAST IRON SERVICE SINK, CAT# 7892, Q48 WITH 4/076-07 RIM GUARD AND WALL HANGER, CAT# 8340, 242 ON FIXTURE, TRAP CAT# 7798, 178 WITH STRAINER.
HB-1	RELOCATE EXISTING HOSE BIB CONTROL ASSEMBLY TO ABOVE SINK
FD-1	FLOOR DRAIN, NEEENA FOUNDRY, 9" X 9", R 4931-8

PLUMBING FIXTURE SCHEDULE



Pearson & Associates
MECHANICAL & ELECTRICAL ENGINEERS
P. O. BOX 610 STONE, VERMONT 05672
(802) 253-9607

STATE OF VERMONT
DEPARTMENT OF STATE BUILDINGS
AGENCY OF ADMINISTRATION
MONTPELLIER VERMONT

AGENCY OF TRANSPORTATION
CONCRETE TEST LABORATORY
BARRÉ-MONTPELLIER ROAD
BERLIN, VERMONT

PLUMBING PLAN & SCHEDULES

DATE: 06/09/92
DRAWN BY: B.W.M.
SCALE: 1/2"=1'-0"
APPROVED BY: [Signature]
REVISIONS: CAD FILE: P-CHL-02
SHEET: 2 OF 3
DWG NO. P-1

10/12