


PLAN

SCALE: 1" = 10'-0"

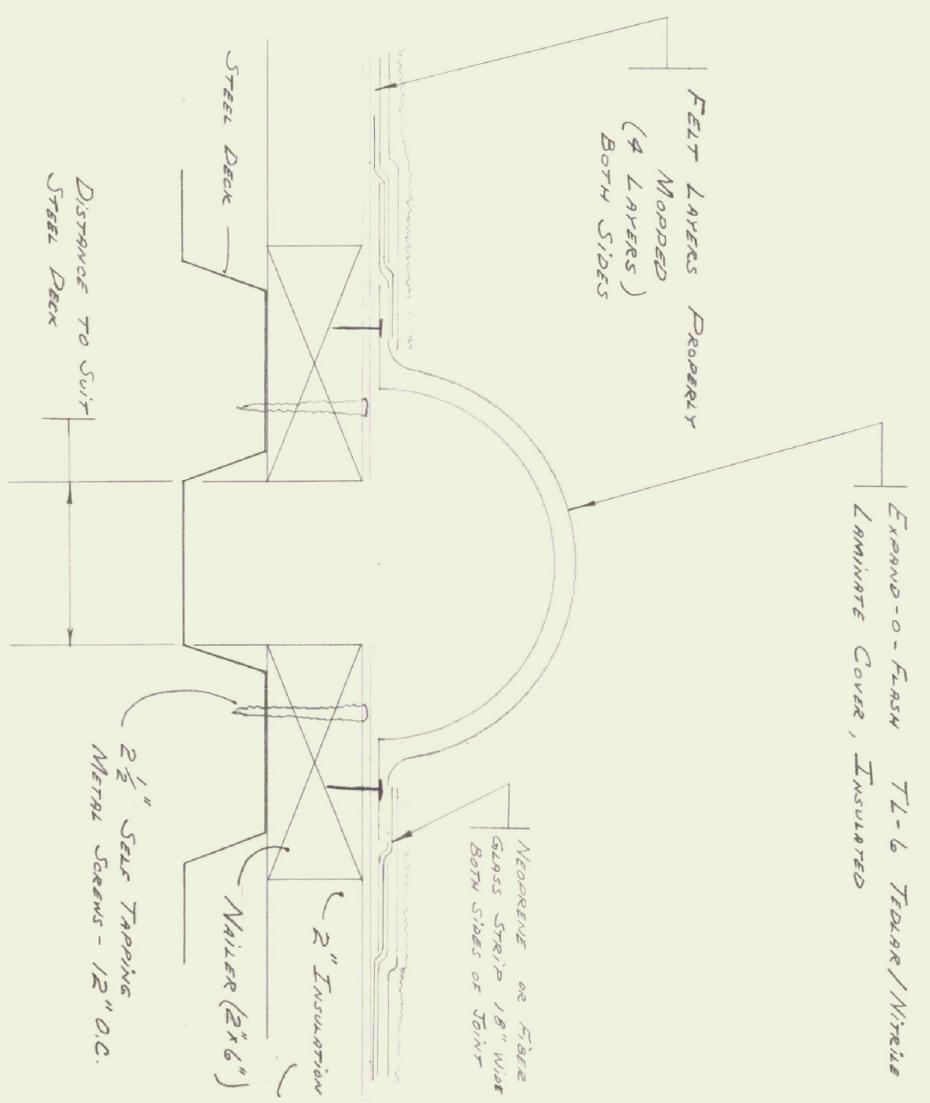

SECT. A-A

DETAIL - EXPANSION JOINT


NO SCALE

STATE OF VERMONT STATE BUILDINGS DIVISION DEPARTMENT OF ADMINISTRATION MONTPELIER, VERMONT	
EXPANSION JOINT MONITOR SECTION	
DESIGNED BY: BERLIN	DWG. NO. VERMONT
DATE: 3-8-71	APPROVED BY:
DRAWN BY: GMM	1 OF 1


NOTE:

THIS ROOF PLAN SHOWS OUR THOSE ITEMS TO BE DELETED, ALTERED OR ADDED TO - ALL OTHER ITEMS, SUCH AS VENTS, EXHAUST HOODS, DRAINS, ETC. ARE TO REMAIN AND ARE TO BE WORKED ON IN ACCORDANCE WITH APPROX SPECIFICATIONS, DATED 8-19-71.

ALL GUTTER STOPS SHALL BE COPPER (1603) 8" WIDE RUN, WITH NAILED AND 18" TAPER EDGE STRIPS; COPPER (1603) TO RUN OVER 5" OF FLASHING. REPLACE ALL FLASHINGS AND GUTTER-FINISHES WITH 1603 COPPER. RESEAL ALL PITCH ROCKETS.

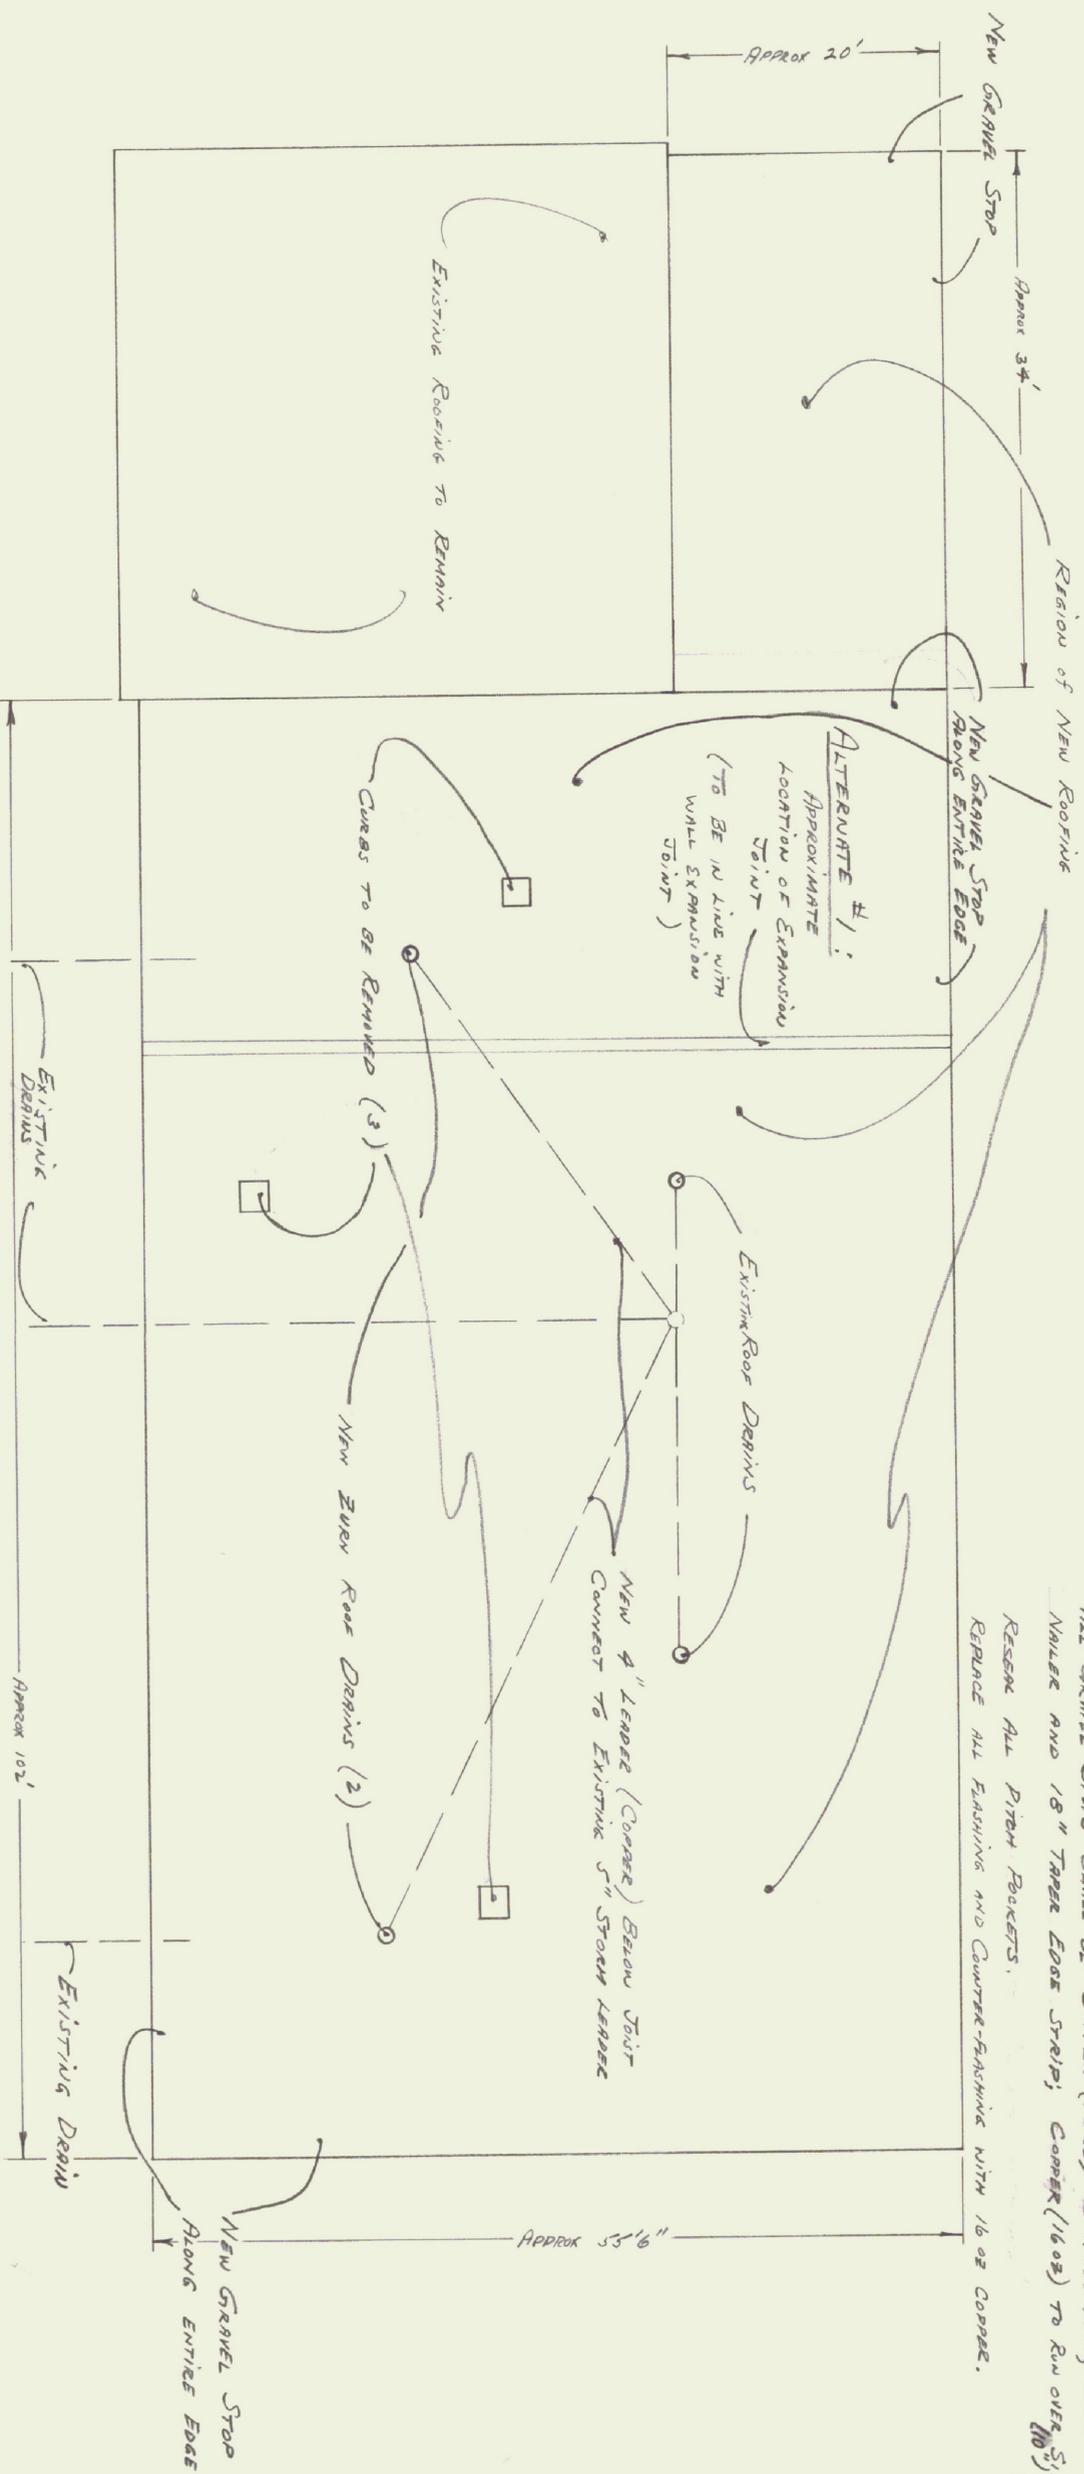


ROOF PLAN - PARTIAL

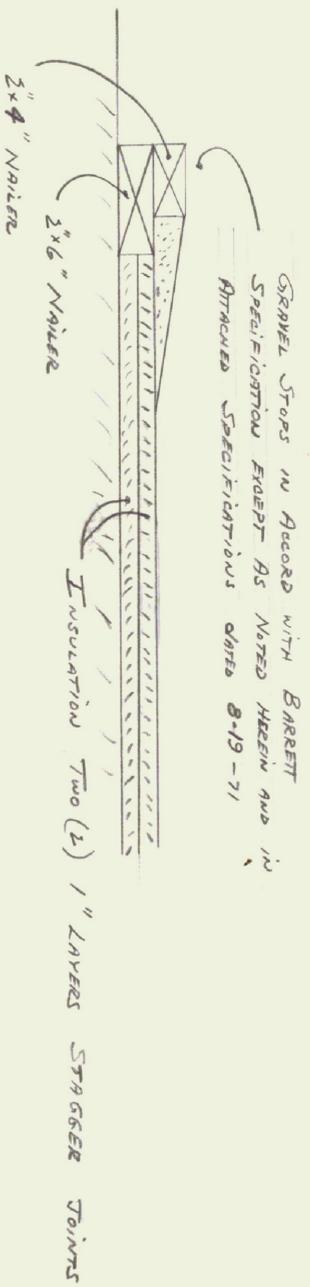

GUTTER STOPS IN ACCORD WITH BARRETT SPECIFICATION EXCEPT AS NOTED HEREIN AND IN ATTACHED SPECIFICATIONS DATED 8-19-71


PARTIAL DETAIL - GUTTER STOP  
SHOWING NAILED ARRANGEMENT  
FOR EXPANSION JOINT

STATE OF VERMONT STATE BUILDINGS DIVISION DEPARTMENT OF ADMINISTRATION MONTPELIER, VERMONT	
SOILS LABORATORY REROOFING - DEPT. of HIGHWAYS BERLIN, VERMONT	
DATE: 8-19-71	DESIGNED BY: GMM
DRAWN BY: GMM	APPROVED BY:
SCALE 1/8" = 1'-0"	DWG. NO. 1 OF 1

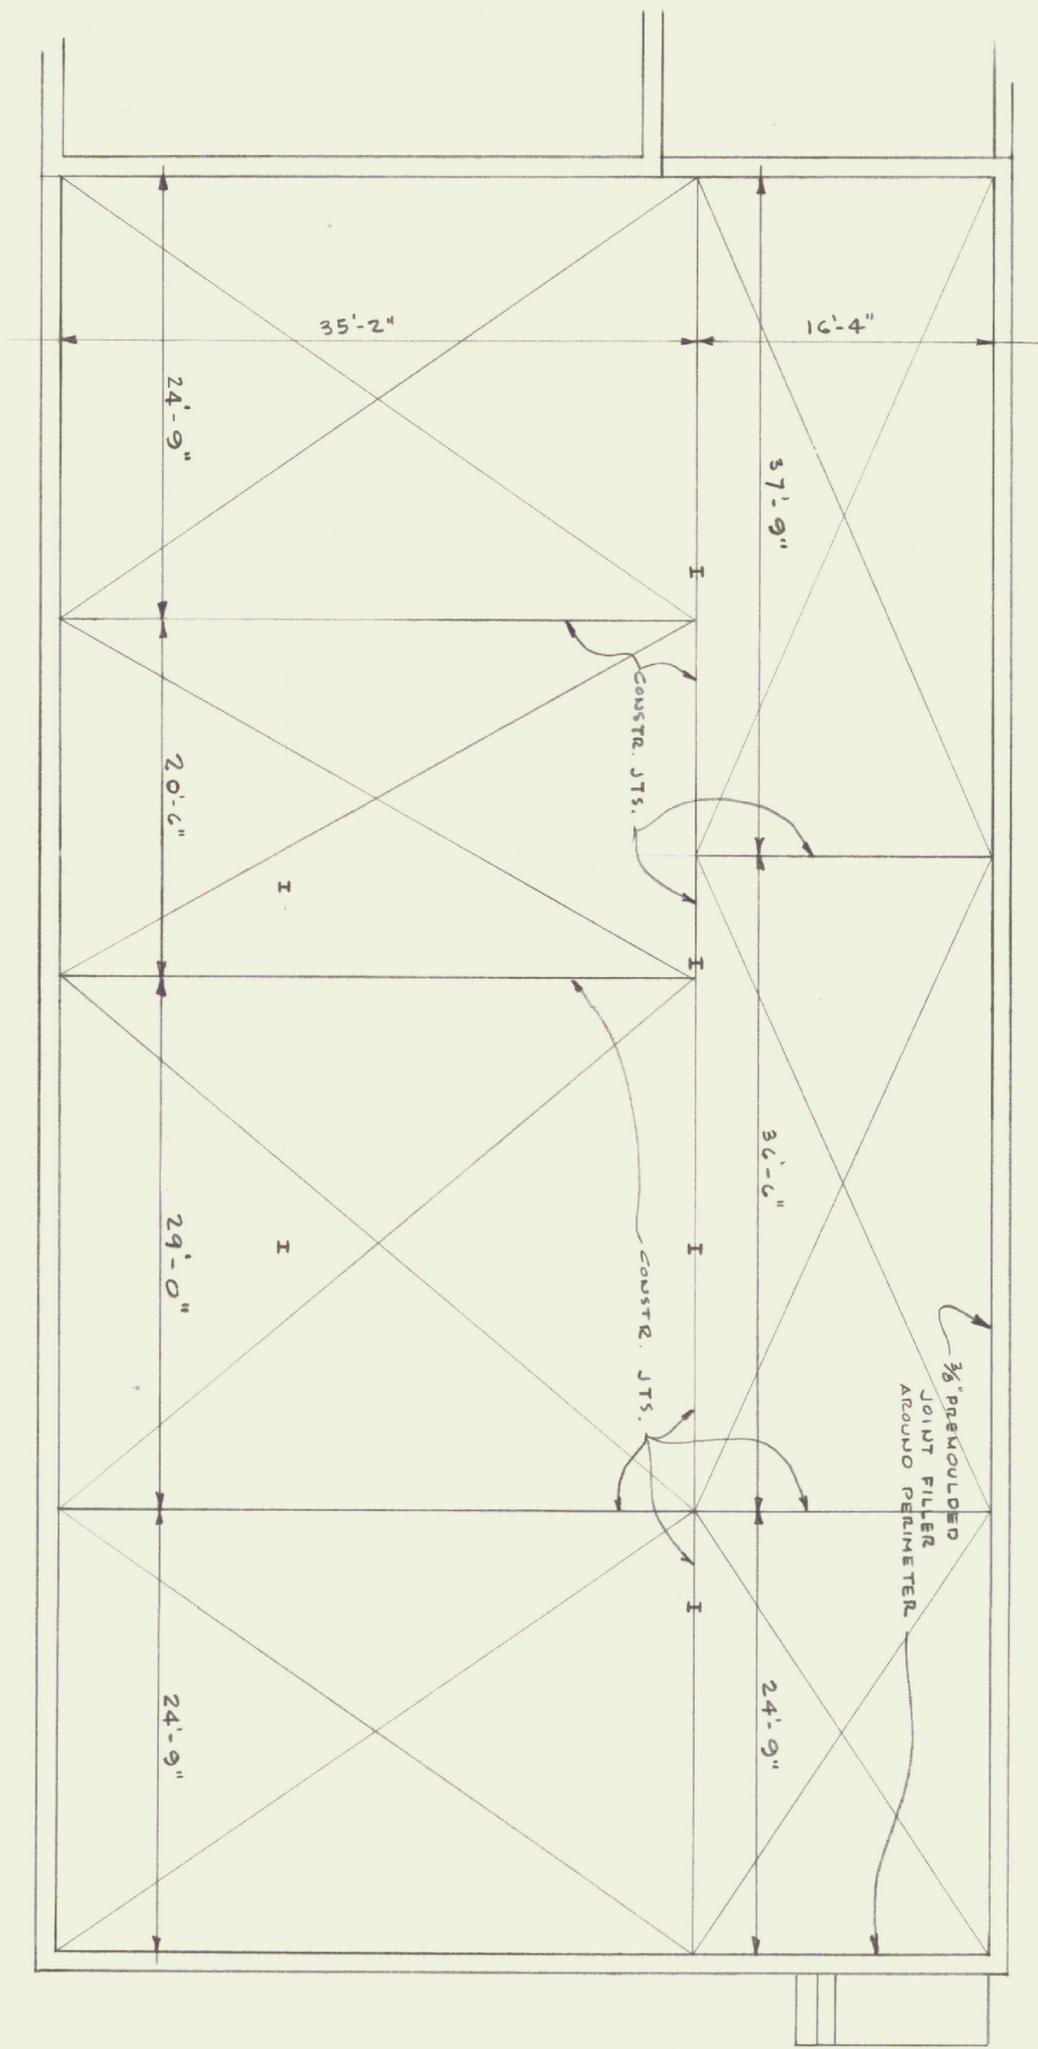

CONC. FLOOR SLAB POUR LAYOUT

ADDITION to VERMONT  
 STATE HIGHWAY LABORATORY  
 STATE BUILDINGS DIVISION  
 1-31-62  
 J.Z.

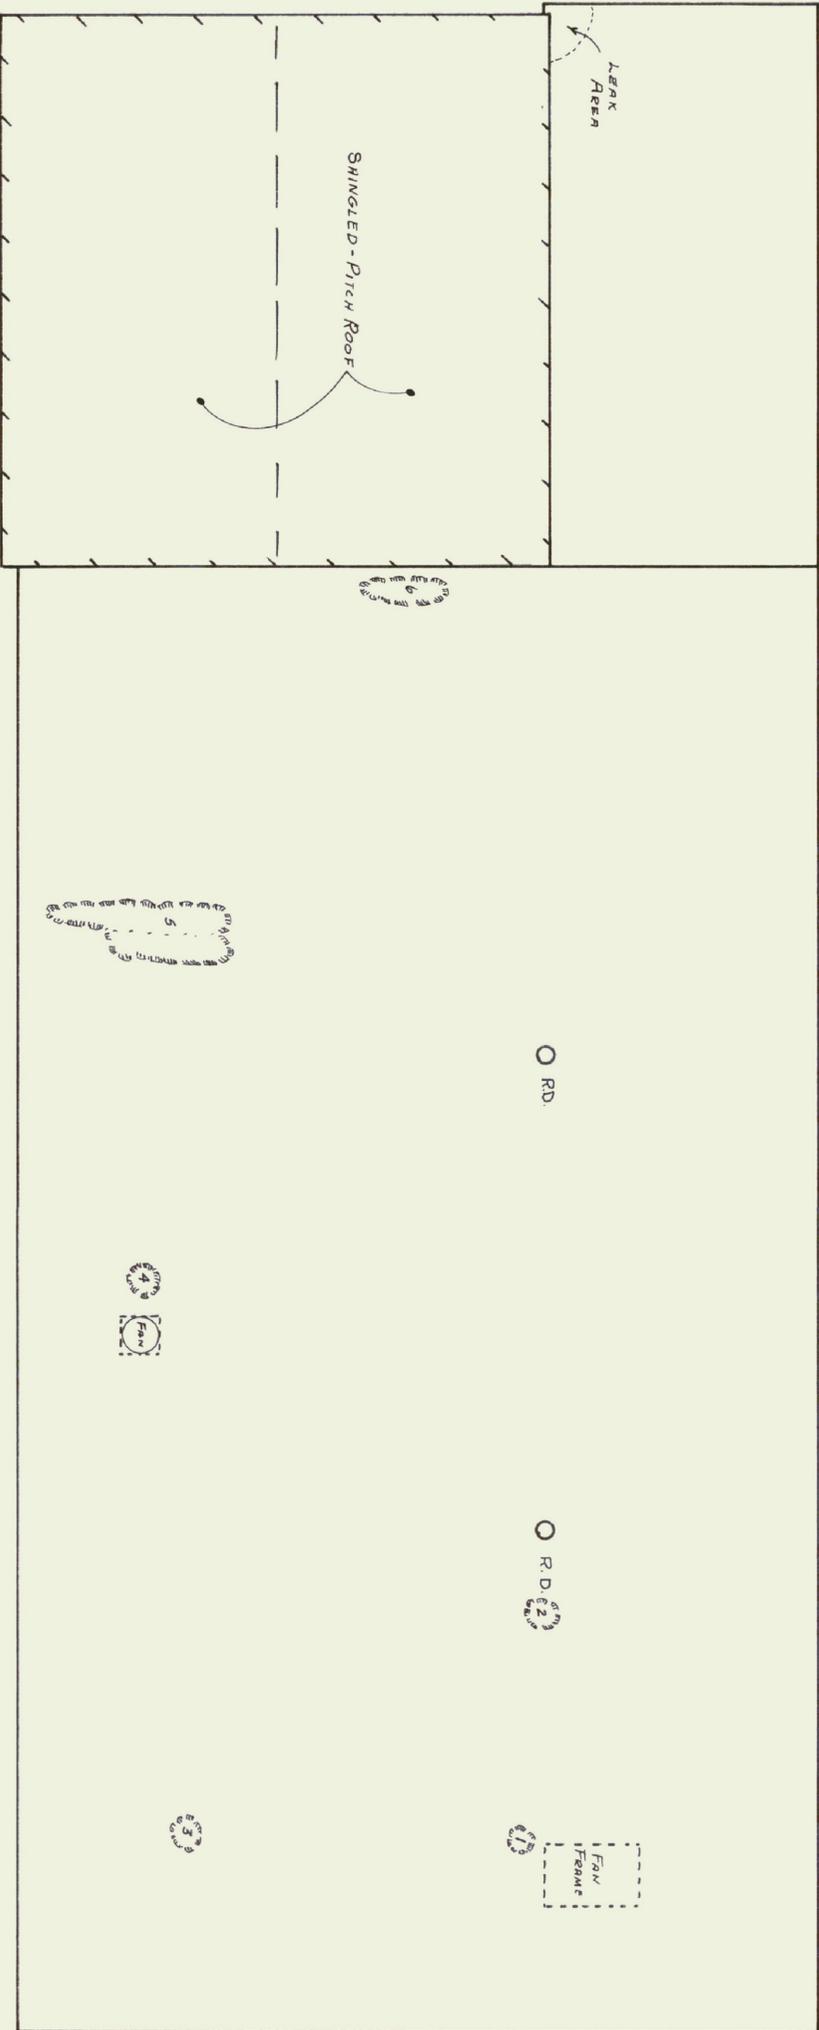

AREAS OF ROOF BUBBLES

- 1. = 4 Sq. Ft.
- 2. = 3 " "
- 3. = 4 " "
- 4. = 3 " "
- 5. = 40 " "
- 6. = 6 " "

ALSO NOTE LEAK AREA, AND MANY AREAS WHICH LACK PROPER STONE COVER.

**ROOF PLAN**

1/8" scale

STATE OF VERMONT  
 STATE BUILDINGS DIVISION  
 DEPARTMENT OF ADMINISTRATION  
 MONTPELIER, VERMONT

**SOILS LABORATORY**  
 DEPT. - OF - HIGHWAYS

BERLIN

VERMONT.

DATE: 6-20-75	DESIGNED BY:	DWG. NO. 1
DRAWN BY: DON	APPROVED BY:	OF