


# DEPARTMENT OF BUILDINGS & GENERAL SERVICES

AGENCY OF ADMINISTRATION, MONTPELIER, VERMONT

## DEPARTMENT OF MOTOR VEHICLES RUTLAND FACILITY RENOVATION & ADDITION

101 STATE PLACE  
RUTLAND, VERMONT

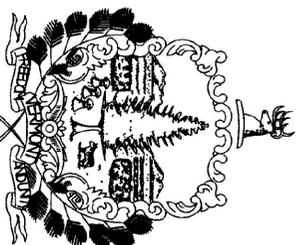


Howard Dean, M.D.  
Governor

AGENCY OF ADMINISTRATION  
DEPT. OF BUILDINGS & GENERAL SERVICES  
2 GOVERNOR AIKEN AVENUE  
MONTPELIER, VERMONT 05633-5801  
THOMAS W. TORTI, COMMISSIONER

DEPARTMENT OF MOTOR VEHICLES  
120 STATE STREET  
MONTPELIER, VERMONT 05603-0001  
PATRICIA MCDONALD, COMMISSIONER

### LIST OF DRAWINGS

- ARCHITECTURAL
  - S1 SITE PLAN
  - X1 EXISTING PLAN & ELEVATIONS
  - A1 FLOOR PLAN
  - A2 BUILDING ELEVATIONS
  - A3 WALL SECTIONS, ATTIC PLAN
  - A4 REFLECTED CEILING PLAN, INTERIOR ELEVS. & DETAILS
- MECHANICAL
  - M1 ATTIC PLAN - MECHANICAL DUCTWORK
  - M2 MAIN FLOOR PLAN - MECHANICAL DUCTWORK
  - M3 MAIN FLOOR PLAN - MECHANICAL HEATING
  - M4 MECHANICAL DETAILS
  - M5 MECHANICAL SCHEDULES
- PLUMBING
  - P1 MAIN FLOOR PLAN - PLUMBING
- ELECTRICAL
  - E1 MAIN FLOOR PLAN - LIGHTING
  - E2 MAIN FLOOR PLAN - POWER & SIGNAL
  - E3 FIRST FLOOR PLAN - ELECTRICAL RENOVALS

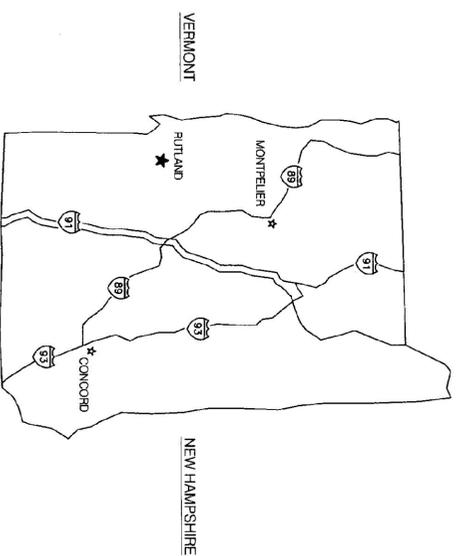

PROJECT LOCATION MAP  
NOT TO SCALE

**ERTEL ASSOCIATES** ARCHITECTS  
15 CENTRAL STREET, WOODSTOCK, VERMONT 05091  
TELEPHONE (802) 457 1602 FAX (802) 457 1750

**LANE ASSOCIATES** CONSULTING ENGINEERS, P.C.

51 KILLINGTON AVENUE,  
RUTLAND, VERMONT 05701  
TELEPHONE: (802) 747-3346  
FAX/MODEM: (802) 747-3356

BID SET  
DATE: MAY 2000

# AS-BUILT

11/2/00

*Heide Miller  
Project Manager (EGS)*