




1
3/4" = 1'-0"

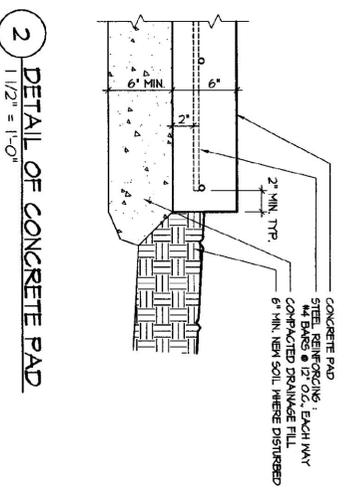

2
1 1/2" = 1'-0"

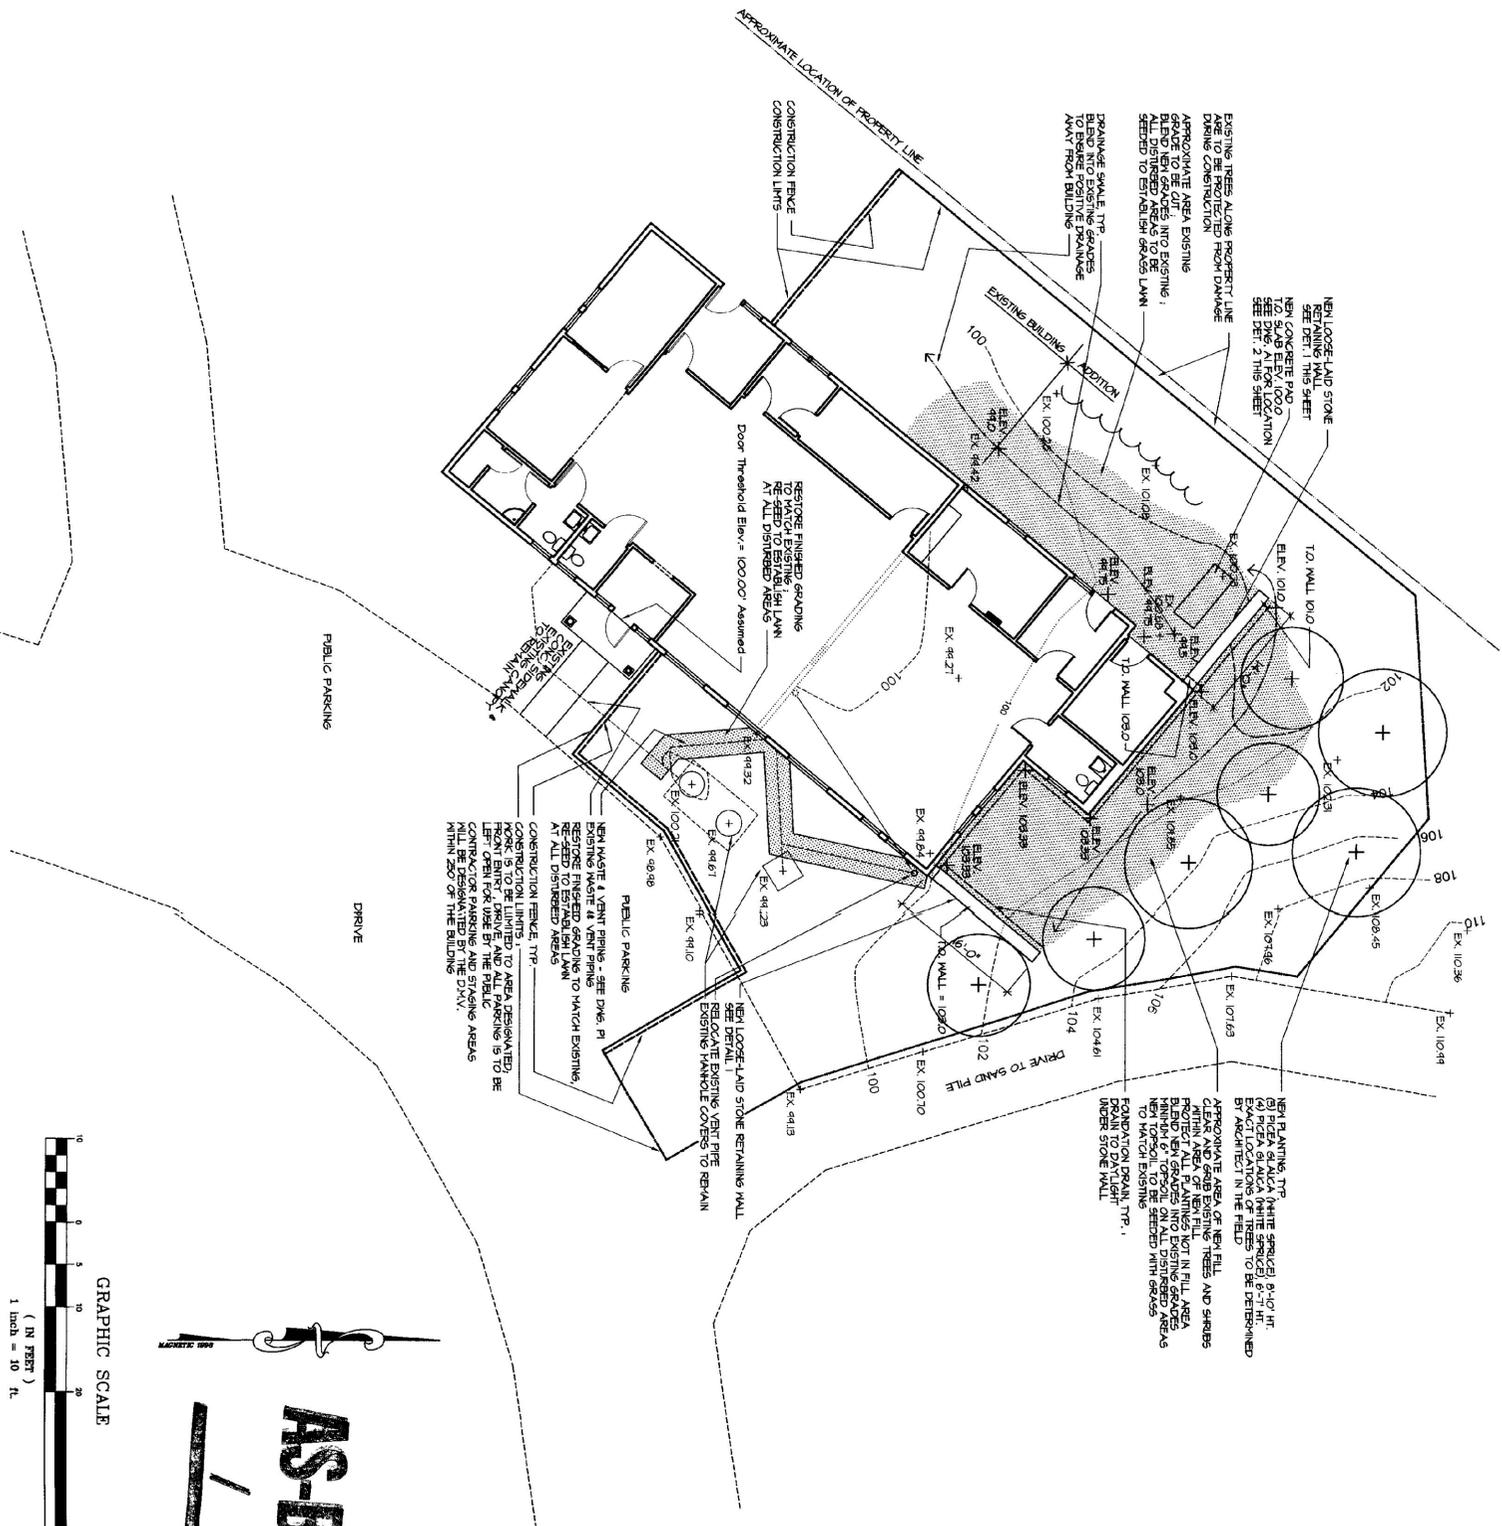

- LEG
- EXISTING CONTOUR
 - NEW CONTOUR
 - NEW CONTOUR
 - + EX 10236 EXIST. GRAVE SPOT ELEVATIONS
 - + ELEV. 1092 NEW GRAVE SPOT ELEVATIONS

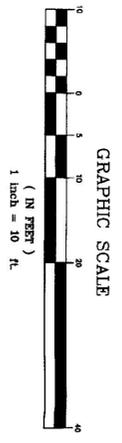


AS-BUILT



ERTEL ASSOCIATES ARCHITECTS
15 CENTRAL STREET WOODSTOCK, VERMONT 05091

DEPARTMENT OF MOTOR VEHICLES
SITE PLAN

RUTLAND, VERMONT

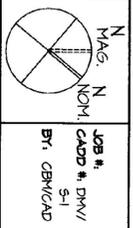

JOB #:
CADD #:
BY: CBW/CAD

SCALE: 1"=10'-0"
DATE: MAY 2000
REVISIONS:

S1