


| ENCL. SCHEDULE | FLOOR | WALLS | CEILING |
|----------------|--|-----------------------|----------------------------|
| 01 | ROOM | EXIST / NEW V.C.T. | EXIST / NEW A.C.T. |
| 02 | MAIN SPACE | EXIST / NEW 6MB, PTD. | EXIST / NEW A.C.T. |
| 03 | PUBLIC AREA | EXIST / NEW 6MB, PTD. | EXIST / NEW A.C.T. |
| 04 | INCLUDES EXAM STATIONS, SEATING AREA, PHOTO STATIONS | EXIST / NEW 6MB, PTD. | EXIST / NEW A.C.T. |
| 05 | CUSTOMER SERVICE AREA | EXIST / NEW 6MB, PTD. | EXIST / NEW A.C.T. |
| 06 | ENTRY | EXIST 6MB, PTD. | EXIST A.C.T. |
| 07 | NOBIS | EXIST V.C.T. | EXIST A.C.T. |
| 08 | NOBIS | EXIST V.C.T. | EXIST A.C.T. |
| 09 | JANITOR | EXIST V.C.T. | EXIST A.C.T. |
| 10 | ELECTRICAL | EXIST V.C.T. | EXIST A.C.T. |
| 11 | EXAM ROOM | EXIST 6MB | EXIST A.C.T. |
| 12 | WAITING ROOM | EXIST 6MB, PTD. | EXIST A.C.T. (CUT & PATCH) |
| 13 | PHONE ROOM | EXIST / NEW 6MB, PTD. | EXIST A.C.T. (CUT & PATCH) |
| 14 | STORAGE ROOM | EXIST V.C.T. | NEW A.C.T. |
| 15 | OFFICE | NEW 6MB, PTD. | NEW A.C.T. |
| 16 | BREAK ROOM | NEW 6MB, PTD. | NEW A.C.T. |
| 17 | BOILER ROOM | SEALED CONCRETE | NEW 6MB, PTD. |
| 18 | STAFF N.C. | NEW V.C.T. | NEW A.C.T. |
| 19 | STAFF N.C. | UNFINISHED FLYWOOD | NEW A.C.T. |
| 20 | ATTC MECHANICAL ROOM | UNFINISHED FLYWOOD | NEW A.C.T. |

INTERIOR TRIM:
 ALL EXISTING WOOD WALL BASE TO REMAIN WHERE POSSIBLE.
 ALL NEW WALLS TO HAVE NEW WOOD WALL BASE PTD. TO MATCH (4" HIGH).
 CUT & PATCH EXISTING WALL BASE WHERE REQUIRED FOR NEW WORK.
 ALL EXISTING WOOD DOOR & WINDOW TRIM TO REMAIN WHERE POSSIBLE.
 ALL NEW OPENINGS TO HAVE NEW FLAT WOOD TRIM PTD. TO MATCH EXISTING.
 CUT & PATCH EXISTING DOOR & WINDOW TRIM WHERE REMOVED FOR NEW WORK.

INTERIOR & EXTERIOR PAINTING:
 ALL NEW WORK TO BE PAINTED ACCORDING TO SPECIFICATIONS.
 EXISTING PAINT TO BE REMOVED AND SURFACES TO BE REPAIRED.
 EXISTING PAINTED SURFACES WITH NO WORK ARE NOT TO BE PAINTED.

- GENERAL NOTES:**
- CONTRACTOR TO VERIFY ALL EXISTING CONDITIONS IN THE FIELD.
 - ALL DIMENSIONS ARE TO FACE OF FRAMING OR CONCRETE, UNLESS OTHERWISE INDICATED.
 - FACILITY IS TO BE FULLY OPERATIONAL, DRIVING REGULAR OFFICE HOURS.
- CONSTRUCTION NOTES:**
- REMOVE SECTION OF EXISTING CABINET.
 - REMOVE (B) SECTION OF LOWER CABINET, INCLUDING TOP, PARTITIONS, SHELVES AND BACKSPLASH CLEANLY IN PLACE. FINISH EXPOSED END OF TOP & SPLASH IN PLASTIC LAMINATE TO MATCH EXISTING. NEW TRIM TO BE INSTALLED ON EXPOSED ENDS. PATCH AS REQUIRED, PAINT END OF CABINET TO MATCH.
 - REBUILD EXISTING WALL AS REQUIRED.
 - REMOVE EXTERIOR & INTERIOR FINISH AS REQUIRED TO ACHIEVE FULL CONFORMITY TO THE USE OF THE EXISTING FACILITY. AND OTHER DISPOSITIONS TO BE DETERMINED BY THE ARCHITECT.
 - REMOVE EXISTING WALL.
 - DEMOLITION OF EXISTING EXTERIOR NORTH WALL SHOULD NOT BE DONE UNTIL CONSTRUCTION OF INTERIOR WALLS IS COMPLETE.
 - REMOVE EXISTING ELECTRICAL HEATER.
 - FILL OPENING IN WOOD FRAMING TO MATCH.
 - REMOVE EXISTING WALL, FINISH TO MATCH EXISTING WALL, PAINT WHOLE WALL.

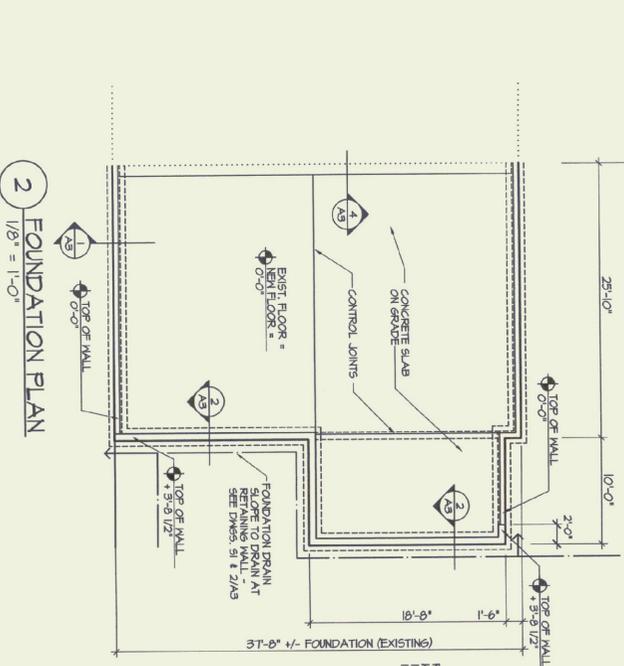


2 FOUNDATION PLAN
1/8" = 1'-0"

WINDOW SCHEDULE:

| NUMBER | SIZE | ITERNOIES | FINISHES |
|--------|------------------|---|-----------------------------------|
| 01 | 6'-0" x 7'-0" | EXISTING EXTERIOR DOOR | NEW LEVER ON EXISTING LOCKSET |
| 02 | 4'-0" x 6'-0" | EXISTING | NEW LEVER ON EXISTING PRIVACY SET |
| 03 | 4'-0" x 6'-0" | EXISTING | NEW LEVER ON EXISTING PRIVACY SET |
| 04 | 4'-2'-0" x 6'-0" | EXISTING | EXISTING LEVER LOCKSET |
| 05 | 4'-2'-0" x 6'-0" | EXISTING | EXISTING |
| 06 | 4'-2'-0" x 6'-0" | EXISTING | EXISTING |
| 07 | 4'-3'-0" x 6'-0" | RELOCATE & RE-USE EXISTING DOOR & FRAME | NEW LEVER ON EXISTING SET |
| 08 | 4'-3'-0" x 7'-0" | EXISTING EXTERIOR DOOR | EXISTING |
| 09 | 9'-0" x 6'-0" | NEW FLUSH WOOD DOOR & FRAME | NEW PASSAGE SET, # 1 |
| 10 | 3'-0" x 6'-0" | NEW FLUSH WOOD DOOR & FRAME | NEW LOCKSET, # 2 |
| 11 | 3'-0" x 7'-0" | NEW FLUSH WOOD DOOR & FRAME | NEW LOCKSET, # 2 |
| 12 | 3'-0" x 7'-0" | NEW FLUSH WOOD DOOR & FRAME | NEW LOCKSET, # 1, 2 |
| 13 | 3'-0" x 6'-0" | NEW FLUSH WOOD DOOR & FRAME | NEW LOCKSET, # 1 |
| 14 | 3'-0" x 7'-0" | NEW FLUSH WOOD DOOR & FRAME | NEW LOCKSET, # 4 |
| 15 | 3'-0" x 6'-0" | NEW FLUSH WOOD DOOR & FRAME | NEW LOCKSET, # 4 |
| 16 | 3'-0" x 6'-0" | NEW FLUSH WOOD DOOR & FRAME | NEW PRIVACY SET, # 3 |
| 17 | 2'-0" x 6'-0" | NEW INSULATED FLUSH METAL DOOR | NEW PASSAGE SET, # 1 |
| 18 | 2'-0" x 6'-0" | NEW INSULATED FLUSH METAL DOOR | NEW PASSAGE SET, # 1 |

DOOR FRAME & TRIM:
 ALL DOOR FRAMES ARE TO BE WOOD TO MATCH EXISTING FRAMES. INTERIOR AND EXTERIOR DOOR TRIM IS TO BE FLAT WOOD CASING TO MATCH EXISTING TRIM PAINTED TO MATCH.

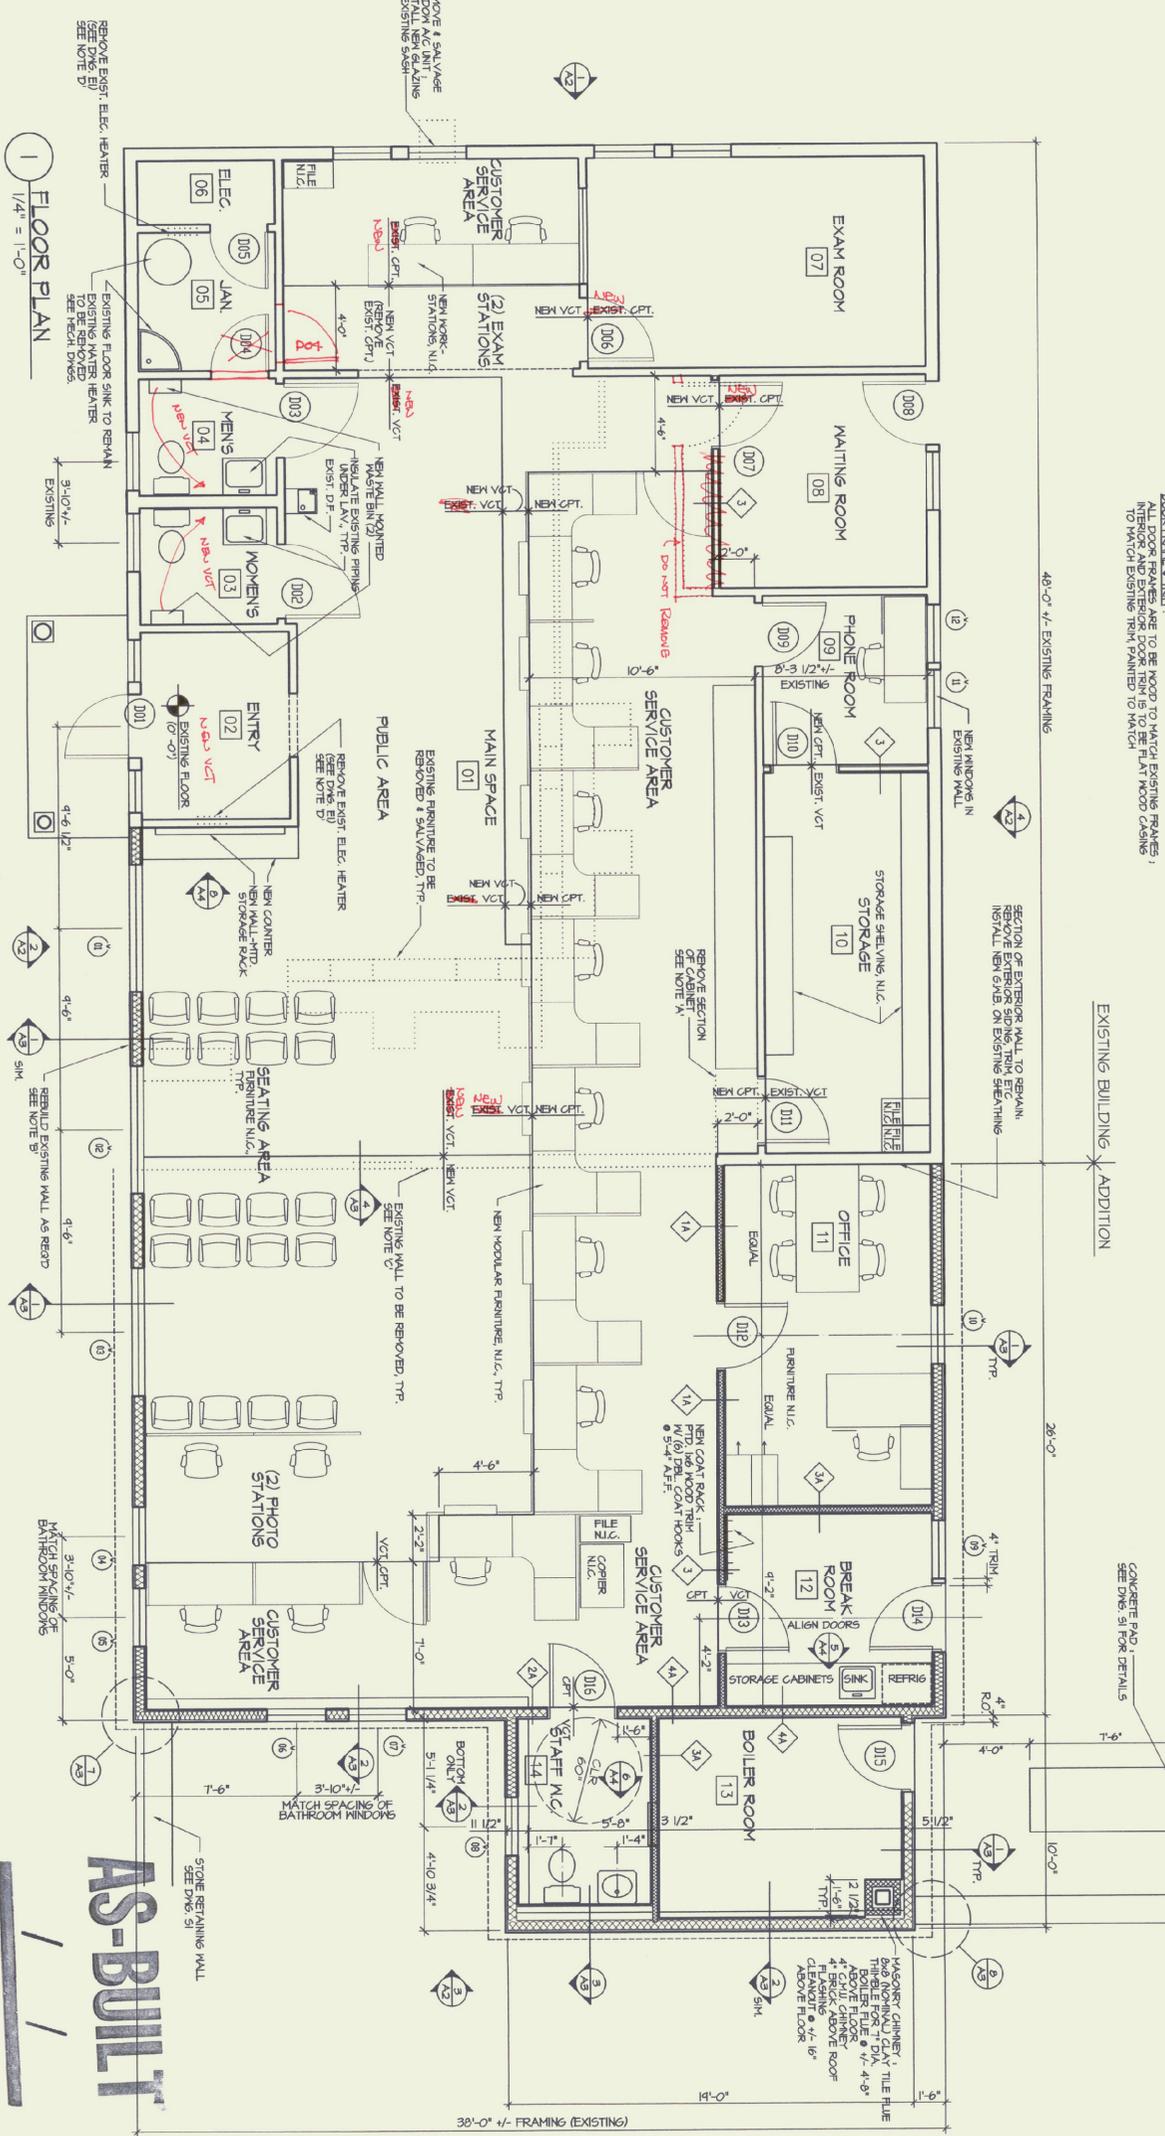

1 FLOOR PLAN
1/4" = 1'-0"



ERTEL ASSOCIATES ARCHITECTS
 15 CENTRAL STREET WOODSTOCK, VERMONT 05091

DEPARTMENT OF MOTOR VEHICLES
 FLOOR PLAN

RUTLAND, VERMONT

JOB #:
 ACT: CAD: DNV:
 A2-1
 BY: CEM/CAD

SCALE: 1/4" = 1'-0"
 DATE: MAY 2000
 REVISIONS:

A1

AS-BUILT