




1 SOUTH ELEVATION
1/4" = 1'-0"

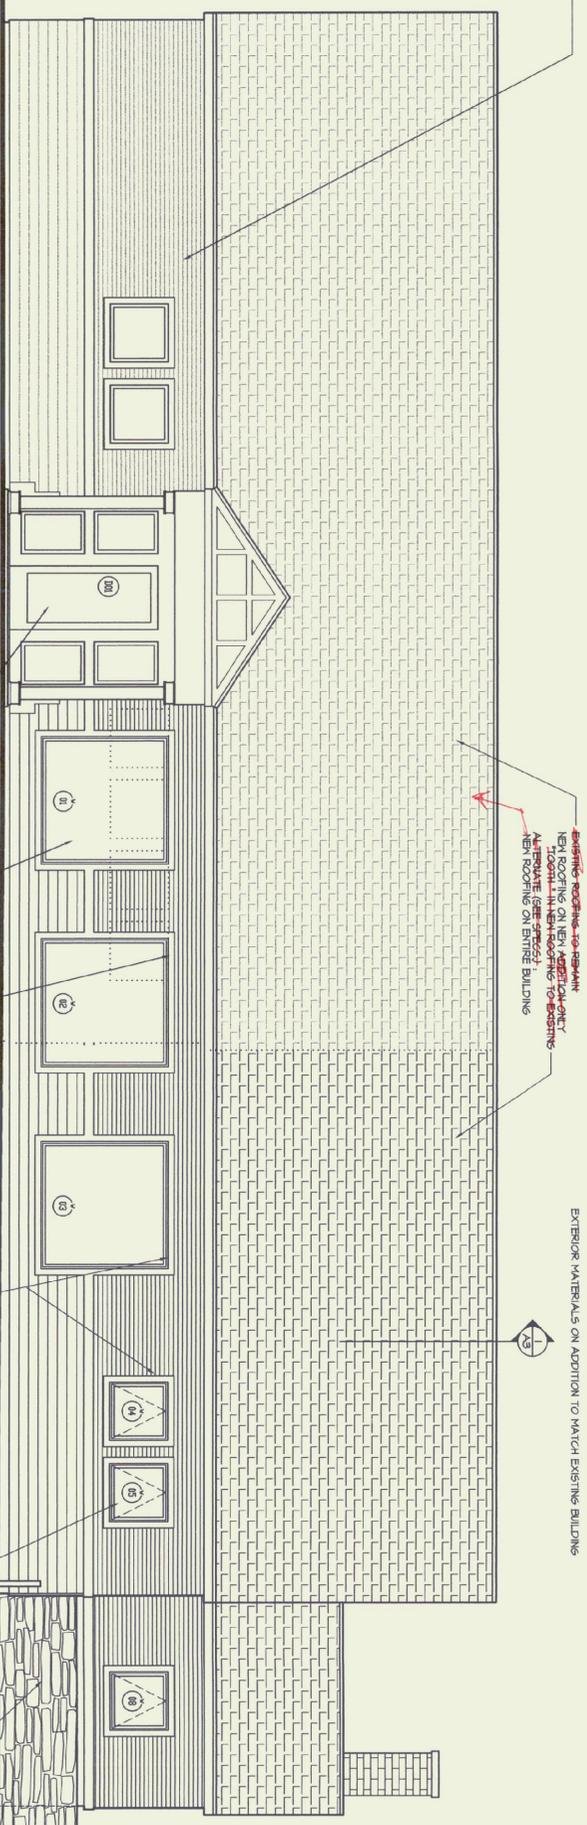

2 EAST ELEVATION
1/4" = 1'-0"

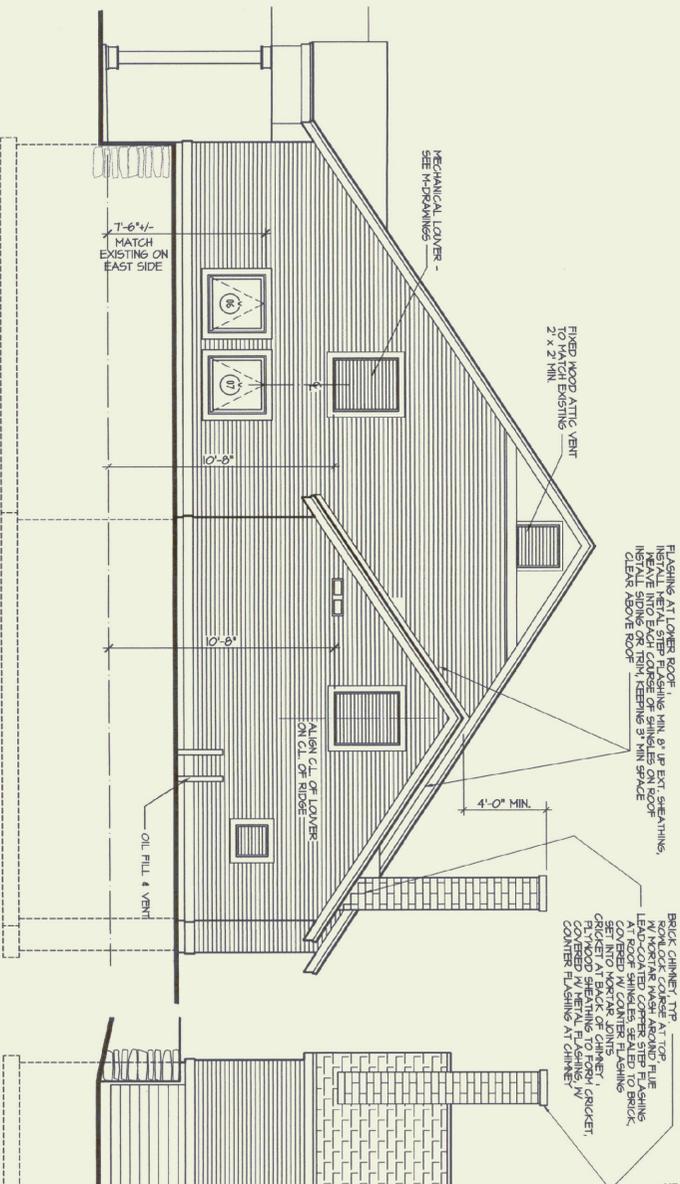

3 NORTH ELEVATION
1/4" = 1'-0"

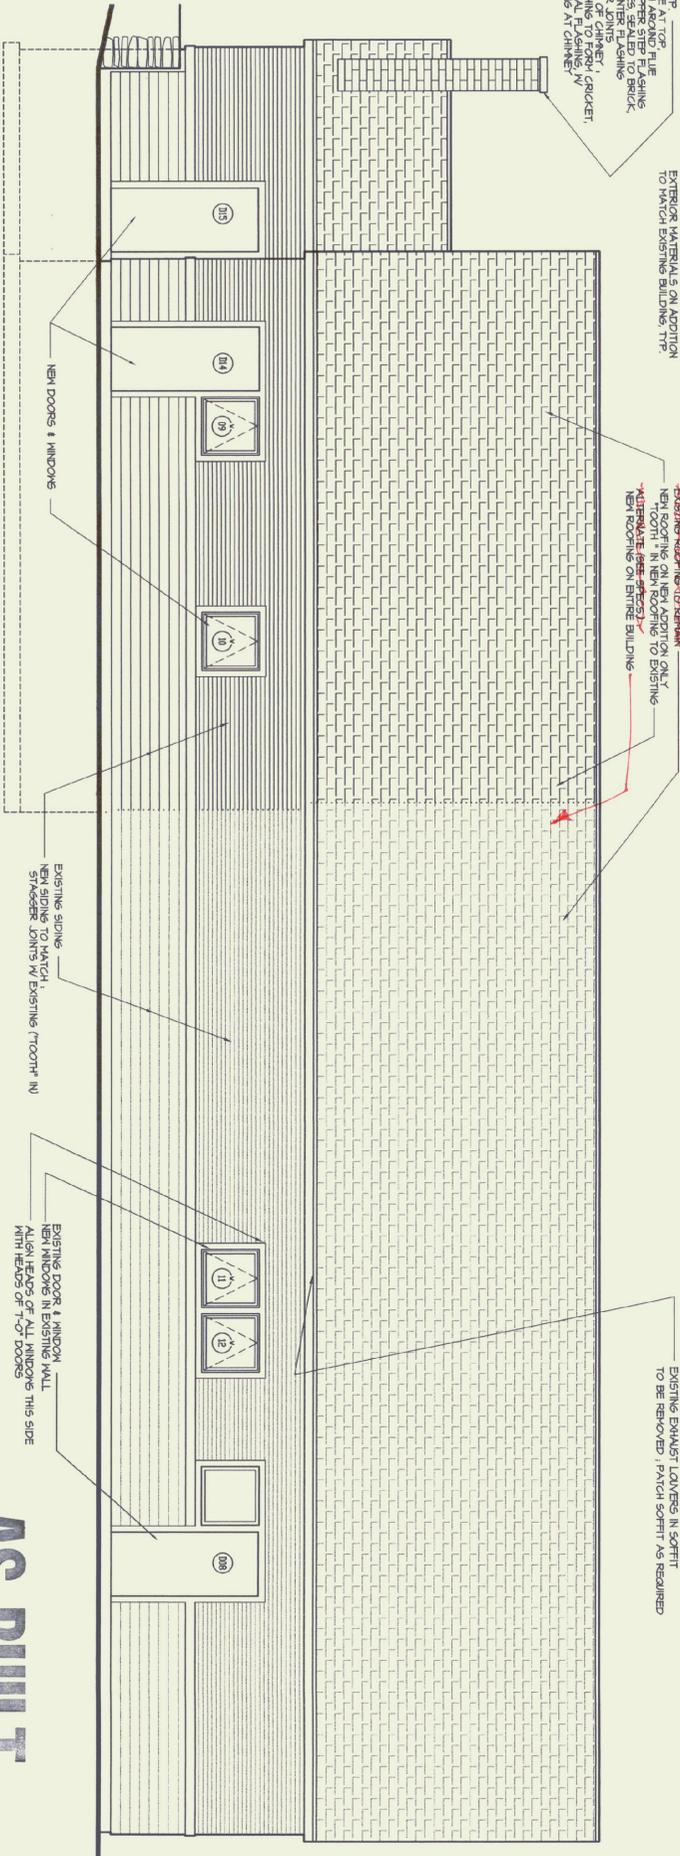

4 WEST ELEVATION
1/4" = 1'-0"

AS-BUILT



ERTEL ASSOCIATES ARCHITECTS
15 CENTRAL STREET WOODSTOCK, VERMONT 05091

DEPARTMENT OF MOTOR VEHICLES
BUILDING ELEVATIONS

RUTLAND, VERMONT

JOB #:
CADD #:
BY: CBN/CAD

SCALE: 1/4" = 1'-0"
DATE: MAY 2000
REVISIONS:

A2