


MAIN FLOOR PLAN - HYDRONIC HEATING LAYOUT  
 SCALE: 1/4"=1'-0"

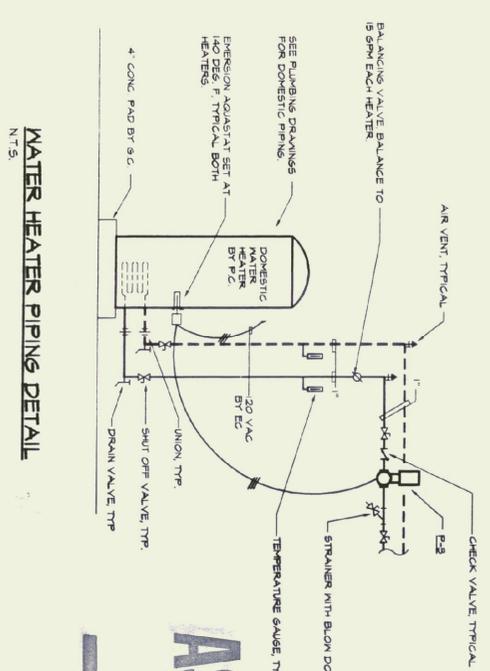

WATER HEATER PIPING DETAIL  
 N.T.S.

**AS-BUILT**

<p>SCALE: AS NOTED</p> <p>DATE: MAY 2000</p> <p>REVISIONS:</p>	<p>JOB #:</p> <p>CADD #:</p> <p>TDL</p>	<p>REVISIONS:</p>	<p>M3</p>
--	---	-------------------	-----------

