
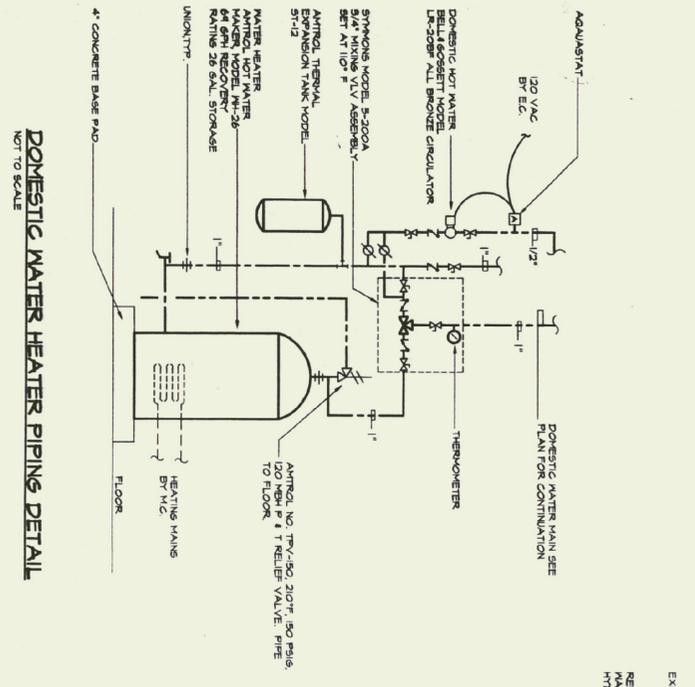



PLUMBING FIXTURE CONNECTION SCHEDULE						PLAN SYMBOL: E-1
No.	ITEM	SOIL	WASTE	VENT	CM	HM
P-1	WATER CLOSET	8"	-	2"	1/2"	-
P-2	LAVATORY	-	1 1/2"	1 1/2"	1/2"	1 1/2" X 1/4" P-T-RAP
P-3	1 C SINK	-	1 1/2"	9"	1/2"	1 1/2" P-T-RAP

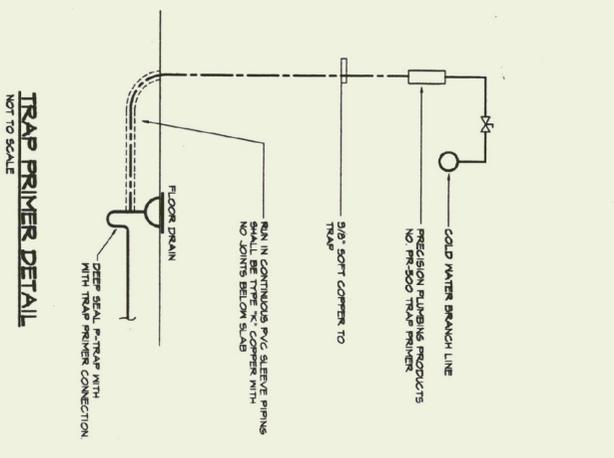


ERTEL ASSOCIATES ARCHITECTS
 15 CENTRAL STREET WOODSTOCK, VERMONT 05091
LANE ASSOCIATES CONSULTING ENGINEERS
 51 KILLINGTON AVENUE RUTLAND, VERMONT 05701

DEPARTMENT OF MOTOR VEHICLES RUTLAND - RENOVATION & ADDITION
 MAIN FLOOR PLAN - PLUMBING

- PLUMBING LEGEND AND ABBREVIATIONS**
- Ø BALL VALVE
 - ⊓ FIXTURE STOP
 - ⊓ DRAIN VALVE
 - ⊓ BALANCING VALVE
 - ⊓ NON-FREEZE WALL HYDRANT
 - ⊓ WATER METER
 - ⊓ CLEANOUT
 - ⊓ SIDE CLEANOUT
 - ⊓ PIPE CAP
 - ⊓ FLOOR CLEANOUT
 - ⊓ EXISTING GRADE CLEANOUT
 - ⊓ GRADE CLEANOUT
- GENERAL ABBREVIATIONS**
- DOMESTIC COLD WATER PIPING
 - DOMESTIC HOT WATER PIPING
 - DOMESTIC HOT WATER RECIRCULATION PIPING
 - SANITARY WASTE AND SOIL PIPING
 - SANITARY VENT PIPING
 - CONDENSATE DRAINAGE PIPING
 - M.C. MECHANICAL CONTRACTOR
 - P.C. PLUMBING CONTRACTOR
 - P.R.V. PRESSURE REDUCING VALVE
 - V.T.R. VENT THROUGH ROOF
 - FD FLOOR DRAIN
 - ⊕ EXISTING PLUMBING FIXTURE AND TRIM TO REMAIN

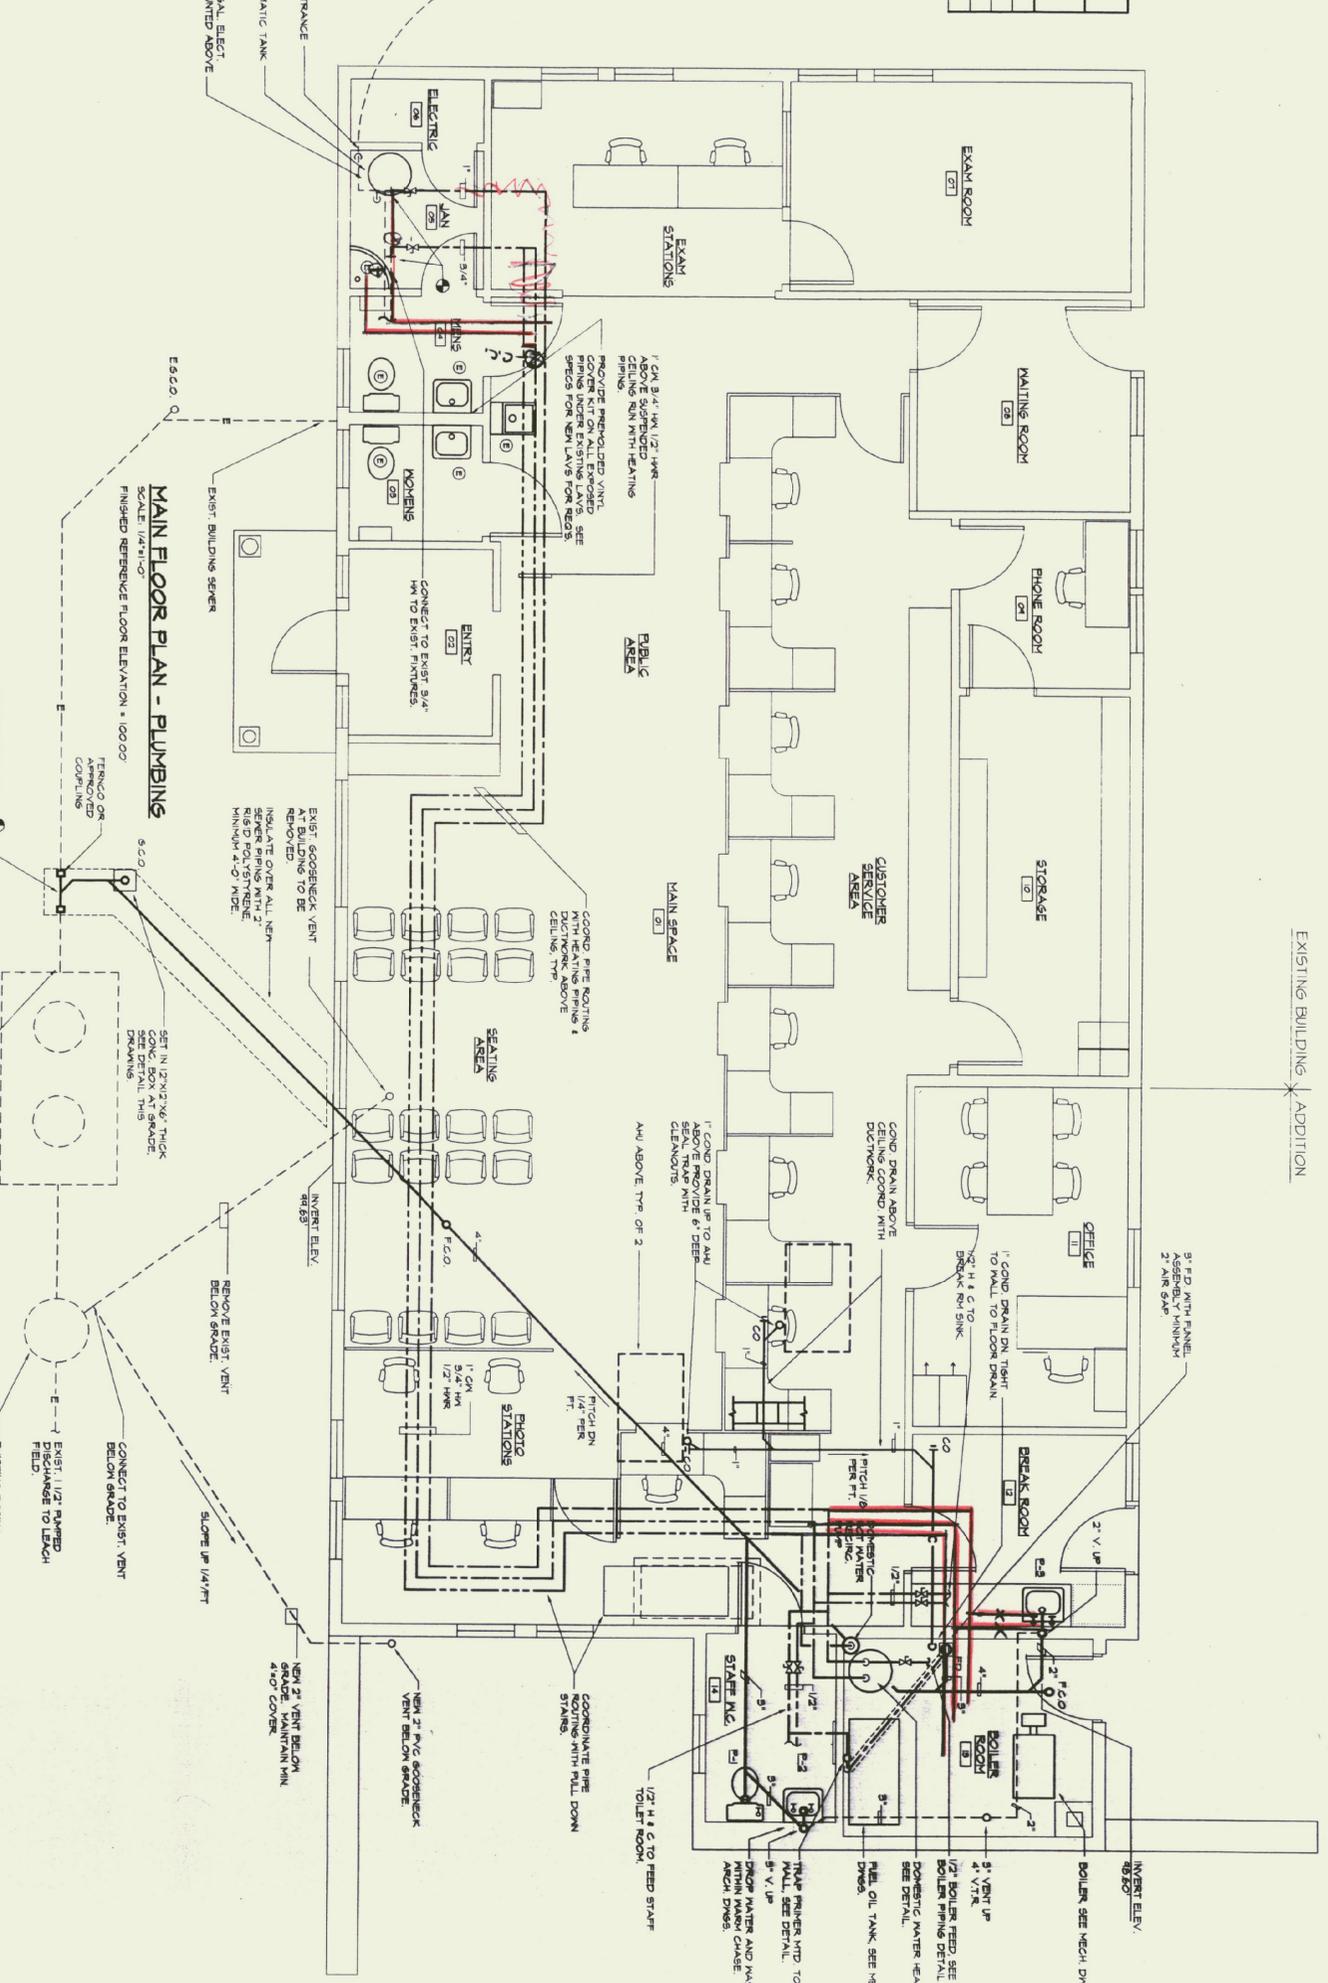

- GENERAL NOTES**
- INVERTS SHOWN WERE OBTAINED FROM ORIGINAL CONTRACT DRAWINGS AS DESIGNED. INVERTS SHOWN CALL OUT DATED 07/18/98. DATA FIELD VERIFY ALL INVERTS PRIOR TO CONSTRUCTION.

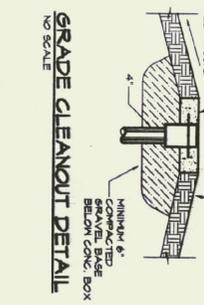

AS-BUILT

SCALE: AS NOTED

DATE: MAY 2000

REVISIONS:

NO. BY: P1

