



NOTES:
 PLUMBING CONTRACTOR SHALL PROVIDE WATER, WASTE AND CONDENSATE DRAIN FROM NEW A-C UNIT.
 ELECTRICAL CONTRACTOR SHALL PROVIDE POWER CIRCUITS TO ADDITIONAL UNIT HEATERS NOT SHOWN ON ORIGINAL DRAWING H-1, AND ALSO A 50 AMP, 3 PHASE BREAKER IN PANEL DP TO SERVICE THE 3 TON AC UNIT.
 ALL ROOF CURBS AS CALLED FOR ON ORIGINAL PLANS SHALL BE INSTALLED AND CAPPED IN THIS CONTRACT AND WALL OPENINGS PROVIDED & BLOCKED FOR FUTURE H FANS.
 WALL INTAKE LOUVER "P" FOR THE MOIST ROOM SHALL ALSO BE FRAMED IN AND SEALED AT THIS TIME, TO REMOVE THE LOUVER IN THE FUTURE.

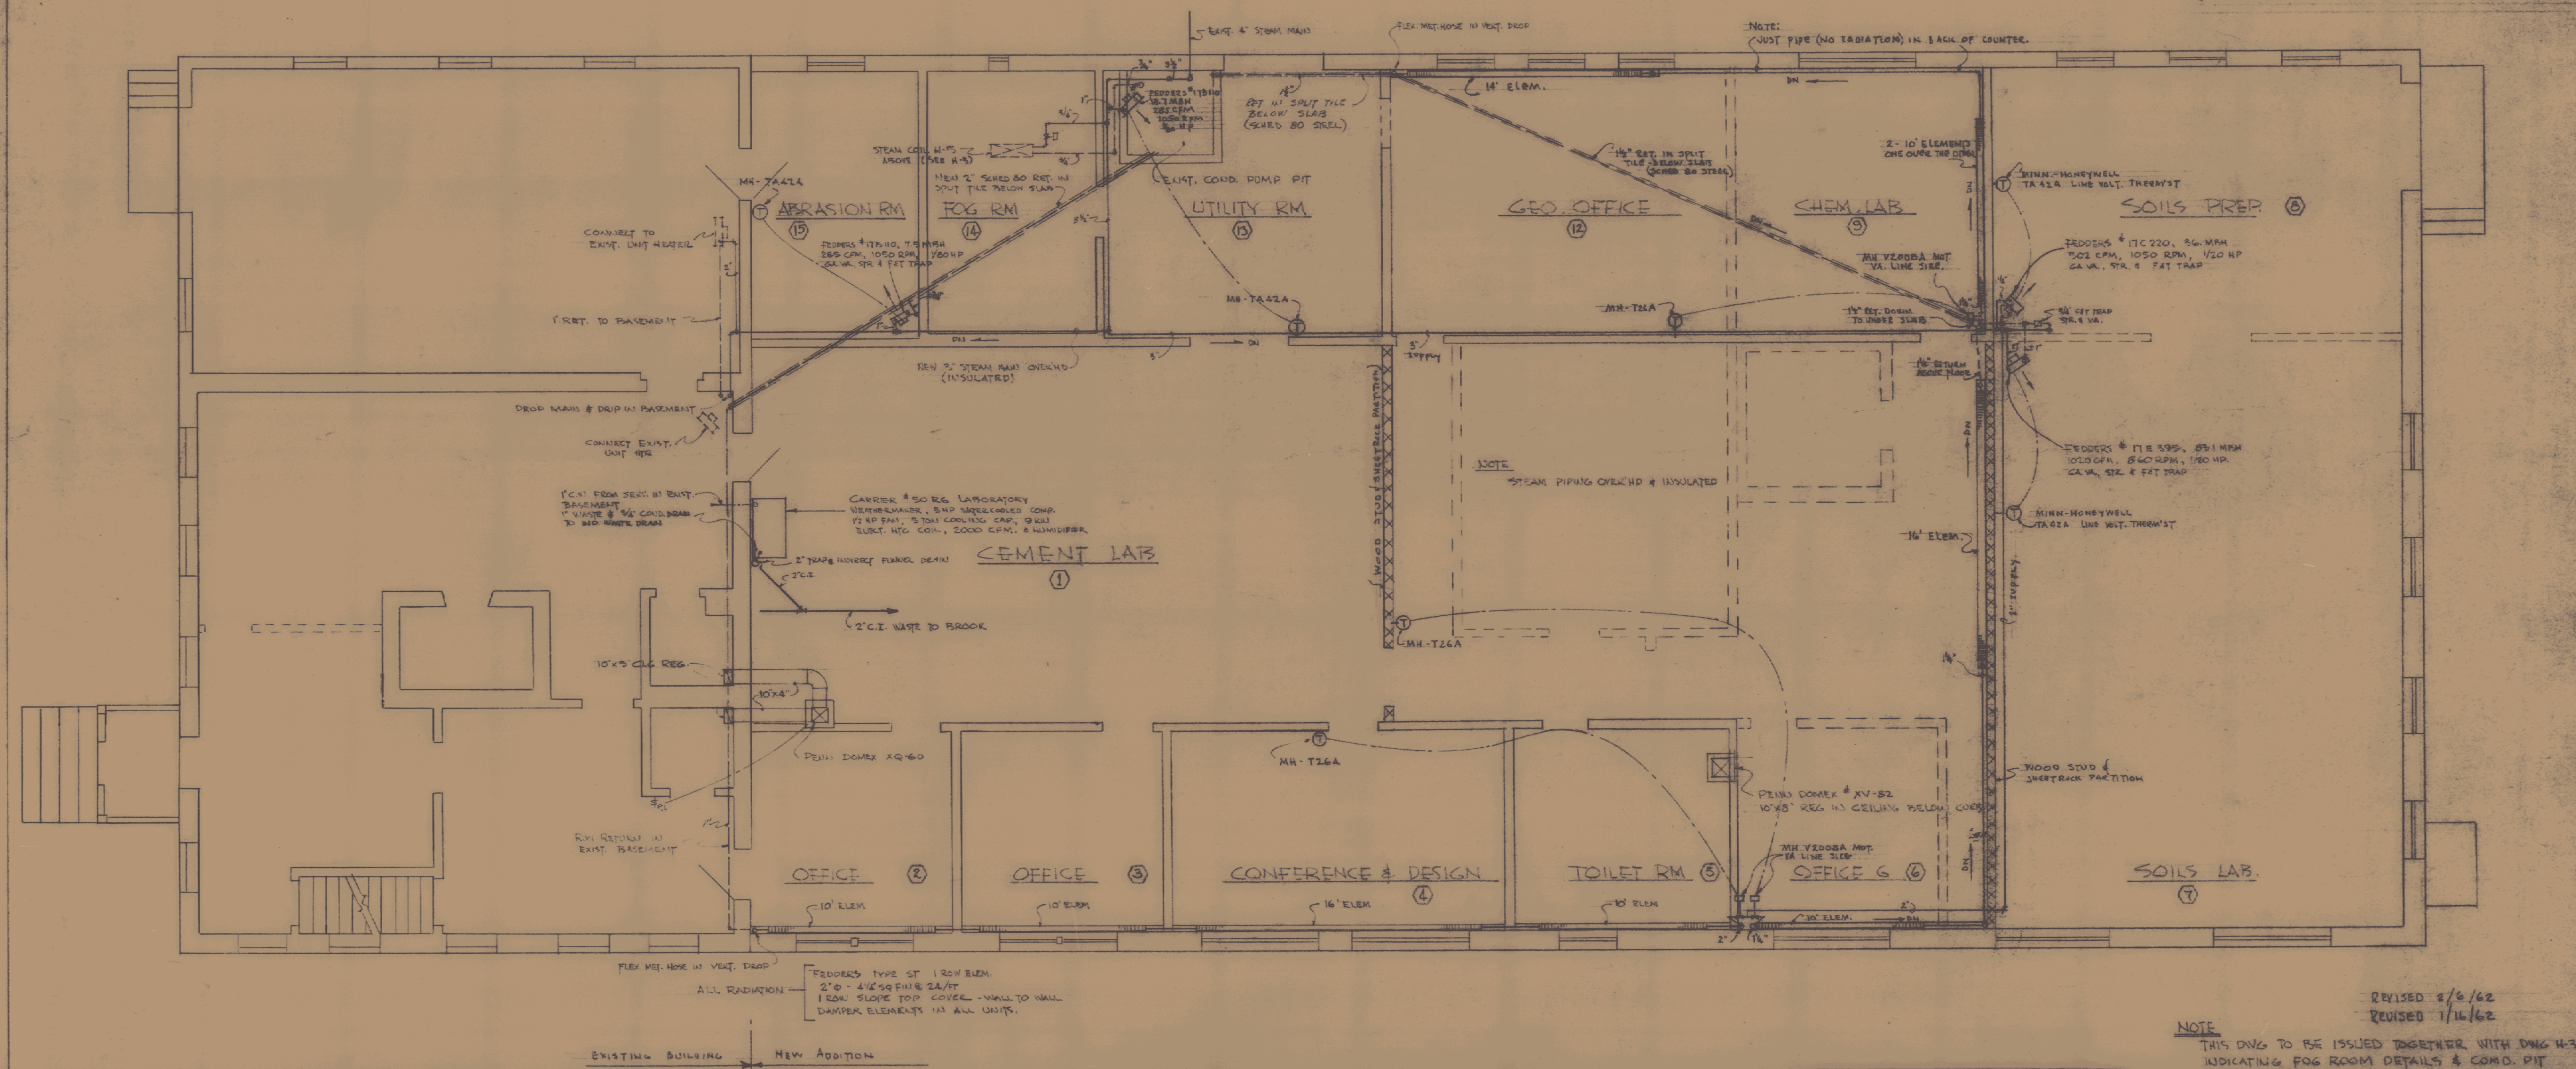

REvised 2/6/62
 REvised 7/16/62
 NOTE
 THIS DWG TO BE ISSUED TOGETHER WITH DWG H-3 INDICATING FOG ROOM DETAILS & COMD. PIT DETAILS & ORIGINAL SPECIFICATIONS (omit sections which do not apply)

ADDITION TO VERMONT
 STATE HIGHWAY LABORATORY
 MONTPELIER, VERMONT
 GORDON G. WOODS
 ARCHITECT
 ST. JOHNSBURY, VERMONT

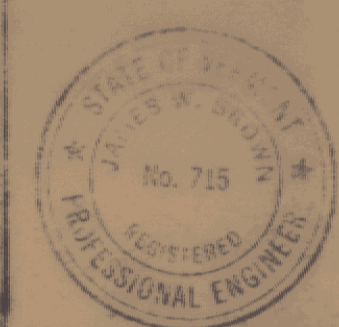

STATE HIGHWAY LABORATORY
 REVISED HEATING & AIR COND.
 WORK NO. 547
 DRAWN BY JWG
 CHECKED BY JWG
 DATE OCT 61
 JENNISON ENGINEERING INC.
 CONSULTING ENGINEERS
 85 CALVER ST. SUITE 200, BURLINGTON, VT. TEL. 263-2000
 SHEET NO. H-1A
 DATE OCT 25, 61