

THESE AS-BUILT OR RECORD DRAWINGS HAVE BEEN PREPARED, IN PART, ON THE BASIS OF INFORMATION COMPILED AND FURNISHED BY OTHERS. THE ENGINEER WILL NOT BE RESPONSIBLE FOR ANY ERRORS OR OMISSIONS WHICH HAVE BEEN INCORPORATED INTO THIS DOCUMENT AS A RESULT OF INFORMATION BY OTHERS.

# RECORD DRAWING

SHOWN PICTORALLY  
MAY NOT BE TO SCALE

## DRAWING LOCATION PLAN

SCALE: 1:4000



NO.	DATE	REVISIONS	DEWN	CHKD
5	9/30/98	NO AS-BUILT INFORMATION ADDED	DSM	KAS
4	12/26/98	CONTRACT PLANS	DSM	MPY
3	1/11/98	FINAL REVIEW REVISIONS	DSM	MPY
2	6/4/96	REVISIONS PER REVIEW COMMENTS	DSM	MPY
1	4/8/96	REVISIONS PER REVIEW COMMENTS	DSM	MPY

**TIMOTHY D. SMITH & ASSOCIATES, PC ARCHITECTS**  
 OLD RAILROAD STATION  
 802-442-8184  
 NORTH BENNINGTON, VERMONT 05257  
 FAX 802-442-8241

**WRIGHT ENGINEERING, LTD. CIVIL ENGINEERS**  
 128 MERCHANTS ROW - P.O. BOX 176  
 802-775-2511  
 RUTLAND, VERMONT 05702-0176  
 FAX 802-775-8915





PROJECT NO. IM 091-1 (29)  
 WATER & SEWER EXTENSION PROJECT  
 TOWN OF GUILFORD  
 TOWN OF BRATTLEBORO

DESIGN BY: JAC  
 DRAWN BY: DSM  
 CHECKED BY: JAC  
 SHEET TITLE: DRAWING LOCATION PLAN

STATE OF VERMONT  
 AGENCY OF TRANSPORTATION  
 SOUTHEAST VERMONT WELCOME CENTER  
 GUILFORD, VERMONT

DATE: 1-2-96  
 SHEET NO. 4 OF 55 SHEETS

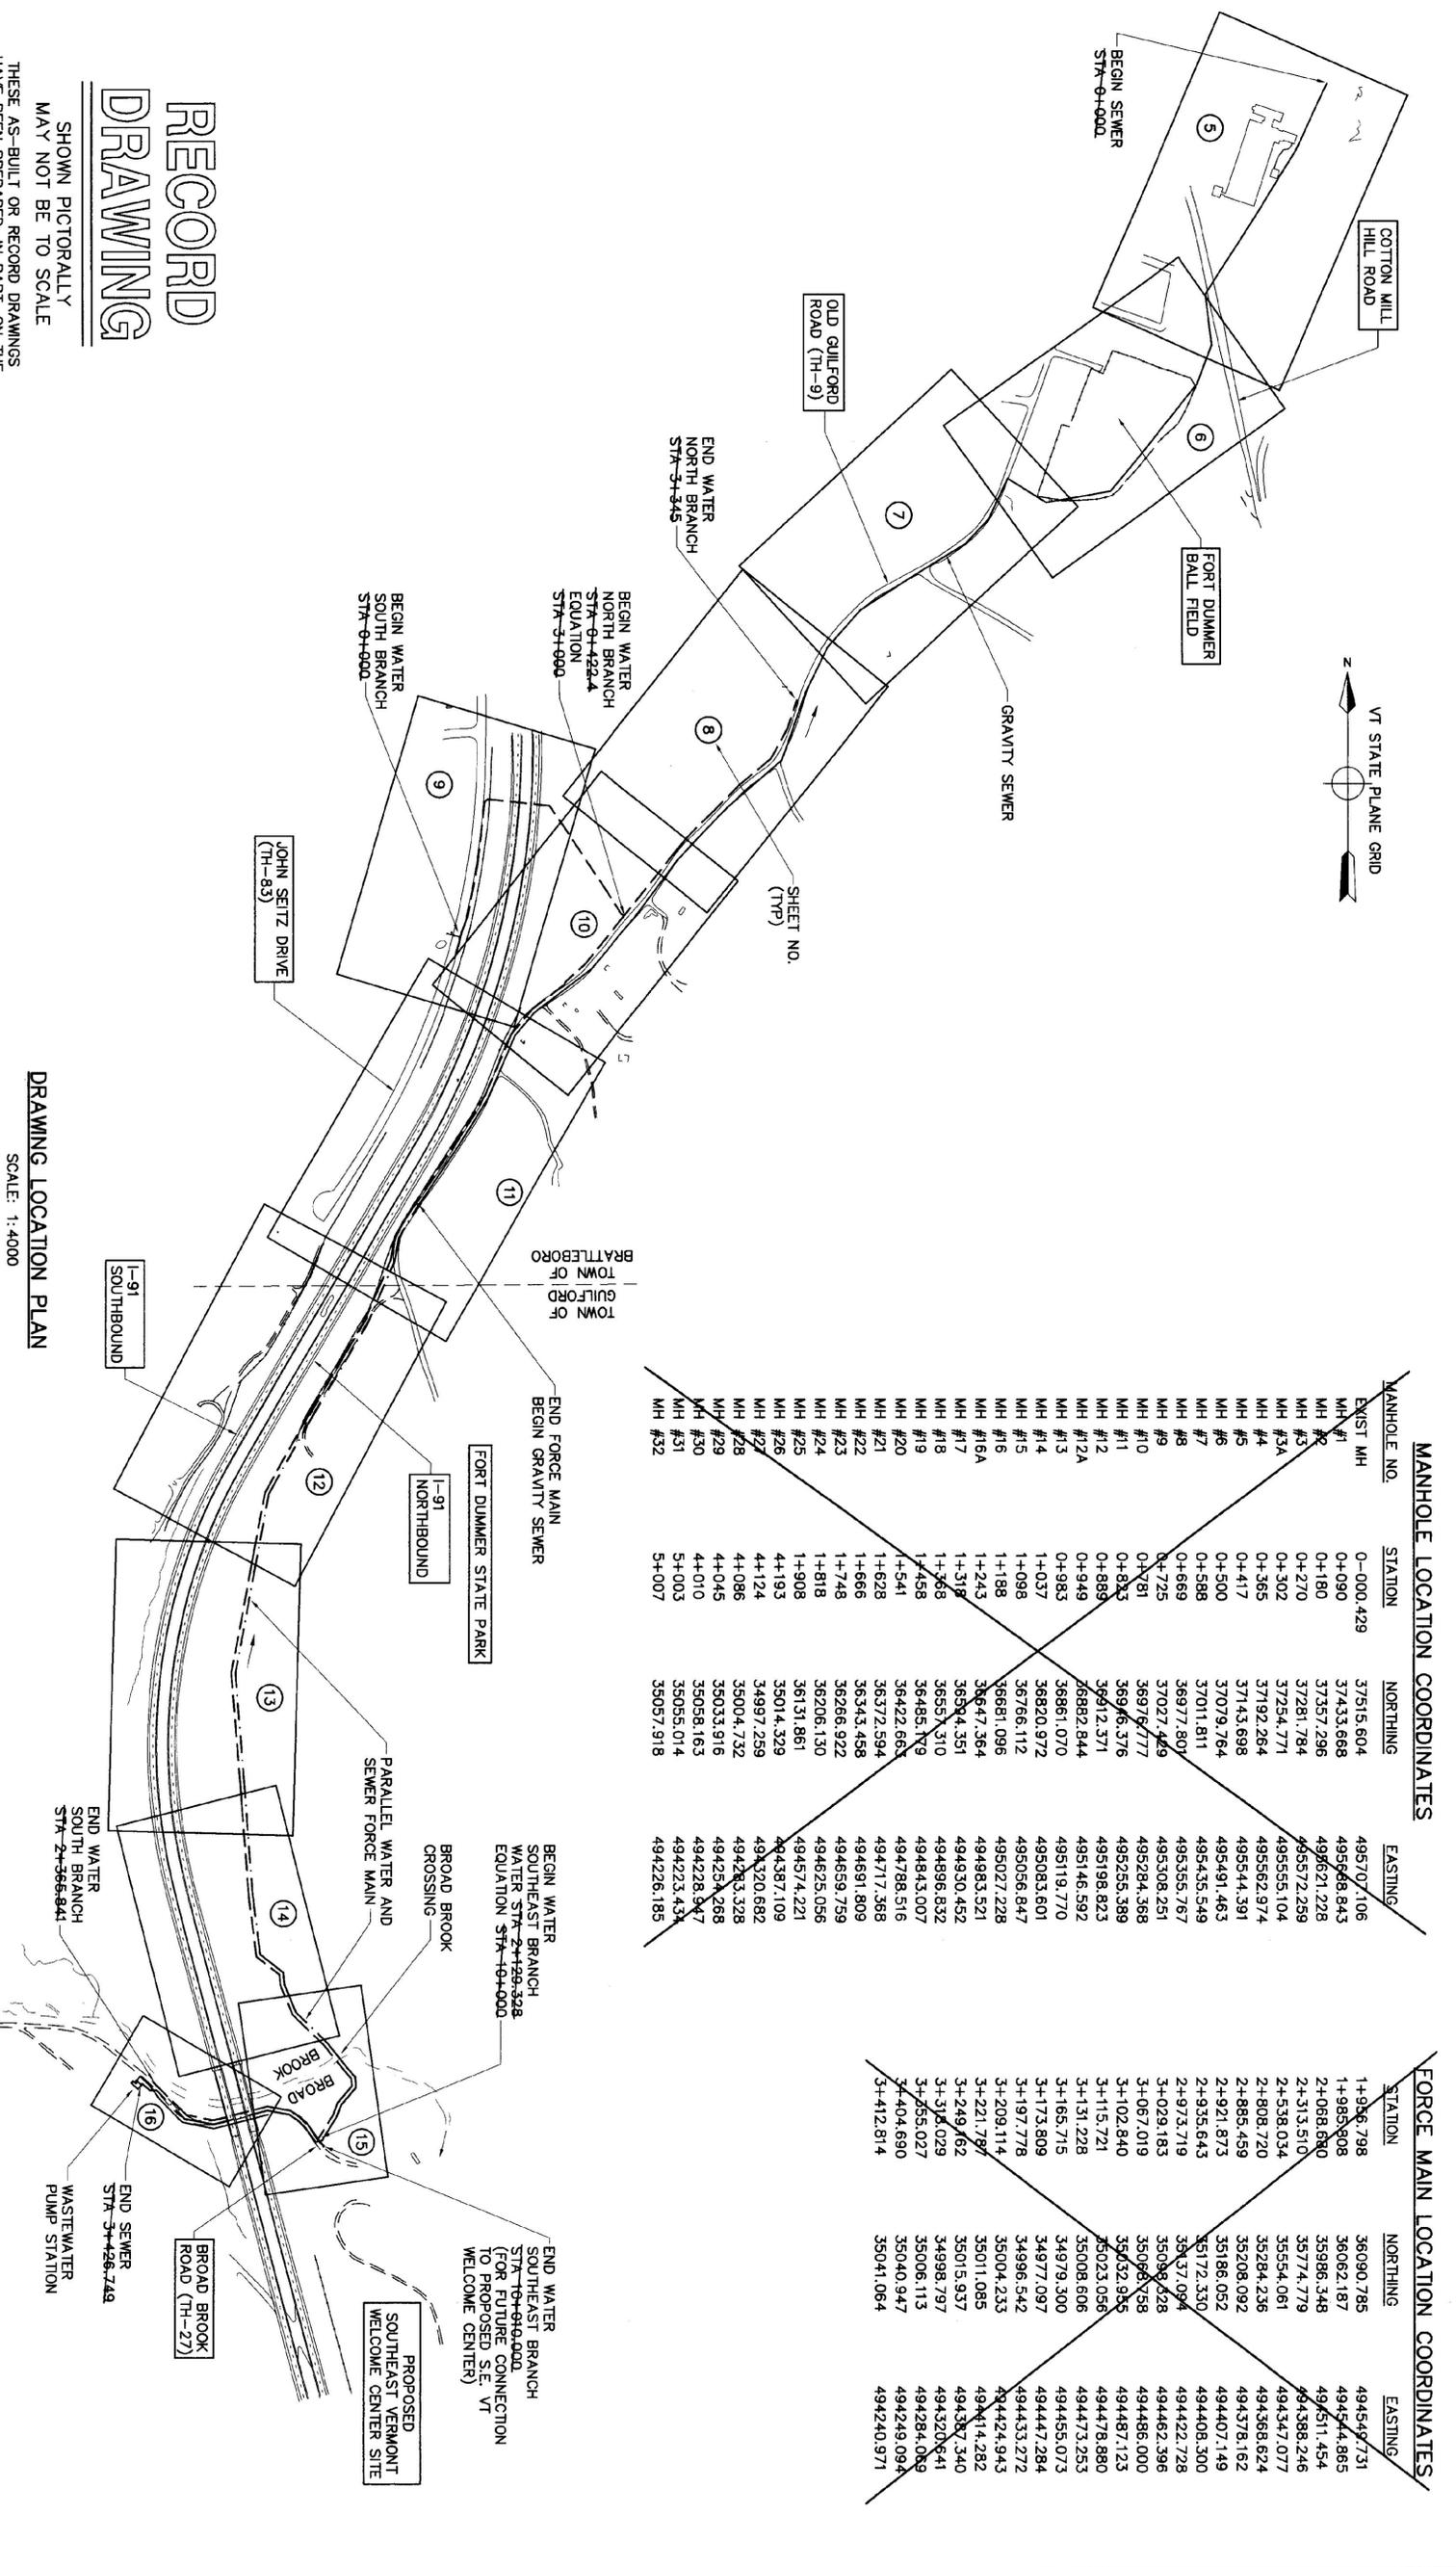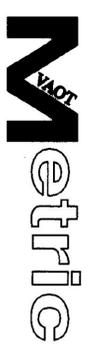

### MANHOLE LOCATION COORDINATES

MANHOLE NO.	STATION	NORTHING	EASTING
EXIST MH			
MH #1	0+000.429	37515.604	495707.106
MH #2	0+090	37433.668	495568.843
MH #3	0+180	37357.296	495621.228
MH #4	0+270	37281.784	495572.259
MH #5A	0+302	37254.771	495555.104
MH #4	0+365	37192.284	495562.974
MH #5	0+417	37143.698	495544.391
MH #6	0+500	37079.764	495491.463
MH #7	0+588	37011.811	495435.549
MH #8	0+669	36977.807	495355.767
MH #9	0+725	37027.449	495308.251
MH #10	0+831	36979.777	495284.368
MH #11	0+833	36946.376	495255.589
MH #12	0+889	36912.371	495198.823
MH #12A	0+949	36882.844	495146.592
MH #13	0+983	36861.070	495119.770
MH #14	1+037	36820.972	495083.601
MH #15	1+098	36766.112	495027.228
MH #16	1+188	36681.096	494983.521
MH #16A	1+243	36647.364	494943.521
MH #17	1+319	36584.351	494930.452
MH #18	1+368	36557.310	494896.832
MH #19	1+458	36485.007	494843.007
MH #20	1+541	36422.663	494788.516
MH #21	1+628	36372.594	494717.368
MH #22	1+666	36343.458	494691.809
MH #22	1+748	36286.922	494659.759
MH #23	1+818	36206.130	494623.056
MH #24	1+908	36131.861	494574.221
MH #25	4+193	35014.329	494387.109
MH #26	4+124	34997.259	494320.882
MH #27	4+086	35004.732	494283.328
MH #28	4+045	35033.916	494254.268
MH #29	4+010	35058.163	494228.947
MH #30	5+003	35055.014	494223.434
MH #31	5+007	35057.918	494223.434
MH #32	5+007	35057.918	494226.185

### FORCE MAIN LOCATION COORDINATES

STATION	NORTHING	EASTING
1+936.798	36090.785	494549.731
1+985.908	36062.187	494544.865
2+068.080	35986.348	494511.454
2+313.510	35774.779	494388.246
2+538.034	35554.061	494347.077
2+808.720	35284.236	494368.624
2+885.459	35208.092	494378.162
2+921.873	35186.052	494407.149
2+935.643	35172.330	494408.300
2+973.719	35137.094	494422.728
3+029.183	35088.028	494462.396
3+067.019	35068.758	494486.000
3+102.840	35052.985	494487.123
3+115.721	35023.056	494478.880
3+131.228	35008.606	494473.253
3+165.715	34979.300	494455.073
3+173.809	34977.097	494447.284
3+197.778	34996.542	494433.272
3+209.114	35004.233	494424.943
3+221.787	35011.085	494414.282
3+249.662	35015.937	494387.340
3+316.029	34998.797	494320.841
3+355.027	35006.113	494284.058
3+404.690	35040.947	494249.094
3+412.814	35041.064	494240.971