


PLAN
SCALE: 1:500

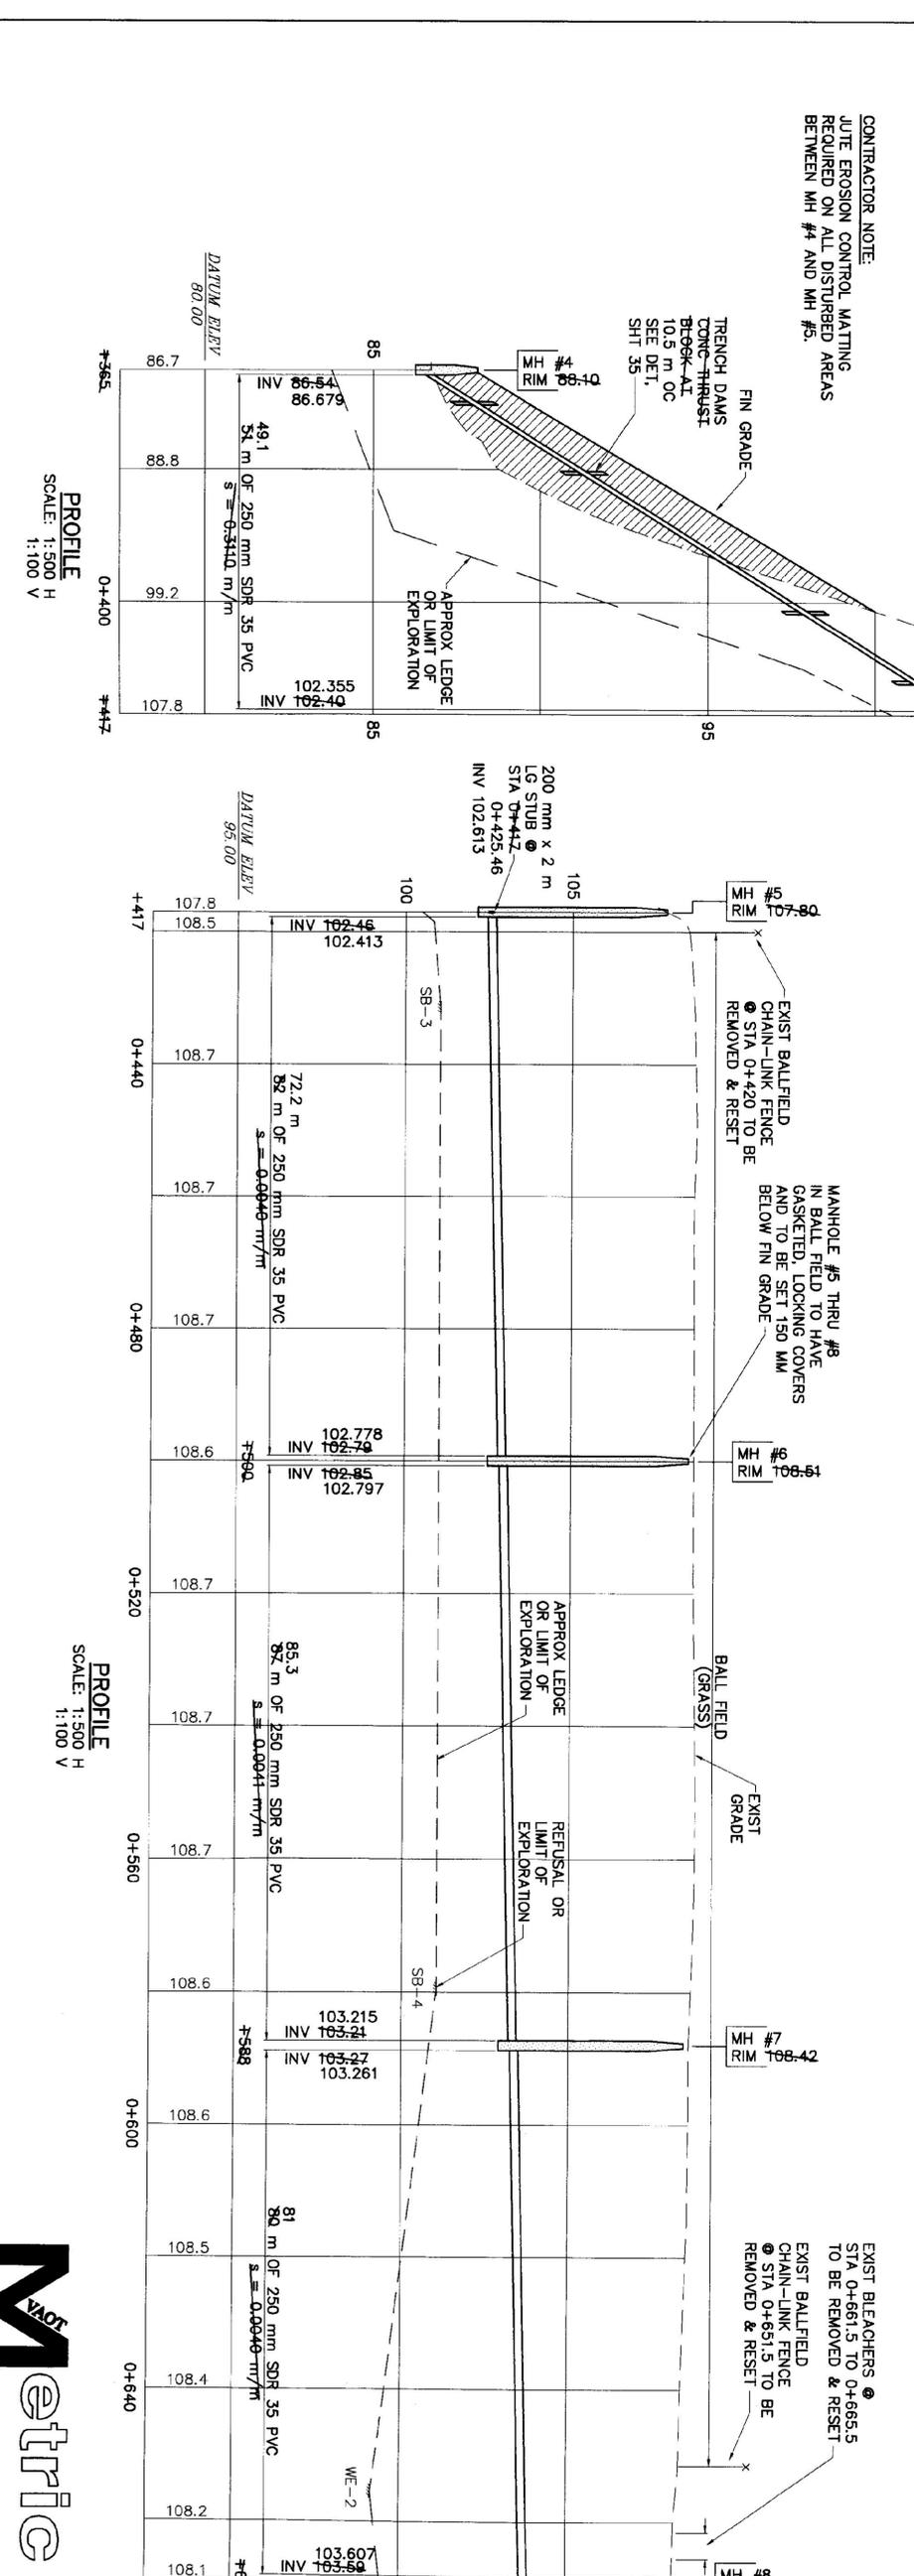

PROFILE
SCALE: 1:500 H
1:100 V

PROFILE
SCALE: 1:500 H
1:100 V

CONTRACTOR NOTE:
LUTE EROSION CONTROL MATTING
REQUIRED ON ALL DISTURBED AREAS
BETWEEN MH #4 AND MH #5.

NOTE:
CONTRACTOR TO INSTALL SOD ON
ALL DISTURBED AREAS WITHIN
BALL FIELD FENCE (STA 0+420
TO STA 0+651)

**RECORD
DRAWING**

SHOWN PICTORALLY
MAY NOT BE TO SCALE

THESE AS-BUILT OR RECORD DRAWINGS
HAVE BEEN PREPARED, IN PART, ON THE
BASIS OF INFORMATION COMPILED AND
FURNISHED BY OTHERS. THE ENGINEER WILL
NOT BE RESPONSIBLE FOR ANY ERRORS OR
OMISSIONS WHICH HAVE BEEN INCORPORATED
INTO THIS DOCUMENT AS A RESULT OF
INFORMATION BY OTHERS.

NO.	DATE	REVISIONS	DRWN	CHKD
1	4/8/96	REVISIONS PER REVIEW COMMENTS	MPY	MPY
2	6/4/96	REVISIONS PER REVIEW COMMENTS	MPY	MPY
3	11/1/96	FINAL REVIEW REVISIONS	MPY	MPY
4	12/26/96	CONTRACT PLANS	MPY	MPY
5	9/30/98	AS-BUILT INFORMATION ADDED	KAS	MPY

DESIGN BY:	JAC
DRAWN BY:	DSM
CHKD BY:	JAC
CHKD BY:	MPY

DATE:	1-2-96
SHEET NO.:	6 OF 55 SHEETS

PROJECT NO.:	091-1 (29)
TOWN OF:	GUILFORD
TOWN OF BRATTLEBORO	
PROJECT TITLE:	SANITARY SEWER PLAN AND PROFILE

STATE OF VERMONT	AGENCY OF TRANSPORTATION
SOUTHEAST VERMONT WELCOME CENTER	GUILFORD, VERMONT

TIMOTHY D. SMITH & ASSOCIATES, PC ARCHITECTS	CIVIL ENGINEERS
OLD RAILROAD STATION	RUTLAND, VERMONT 05702-0176
802-442-8184	FAX 802-775-8915
802-442-8184	
128 MERCHANTS ROW - P.O. BOX 176	
802-775-2511	

