
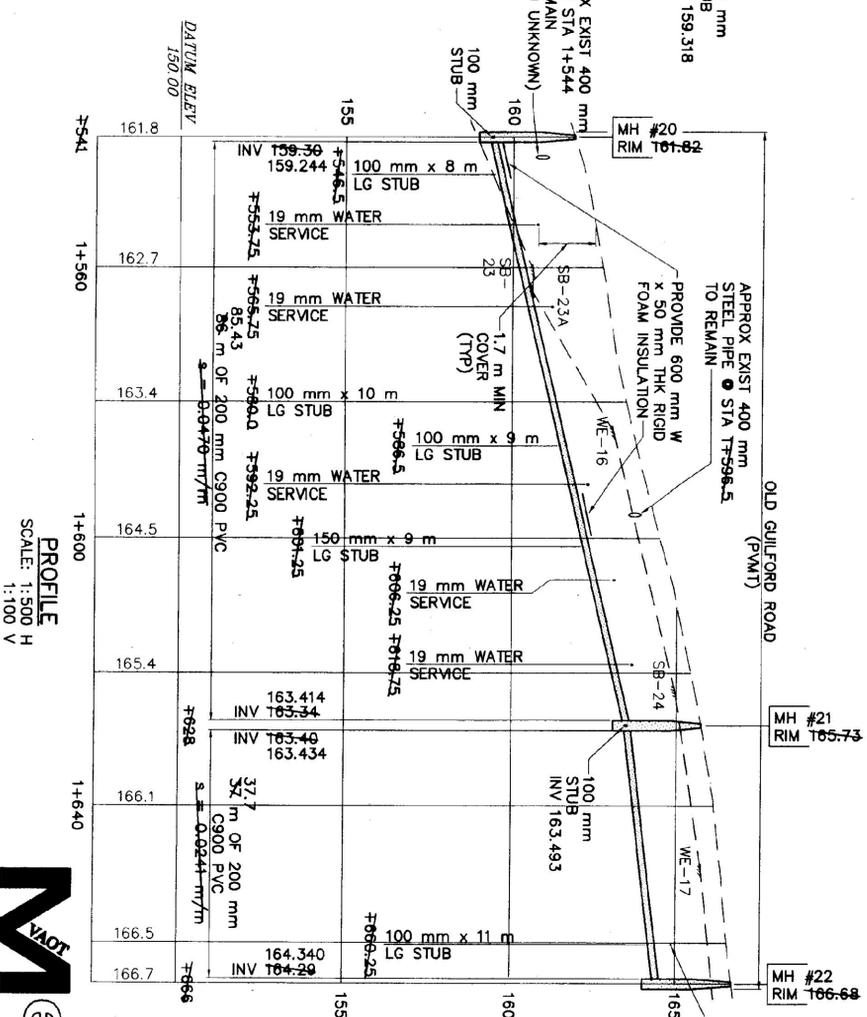
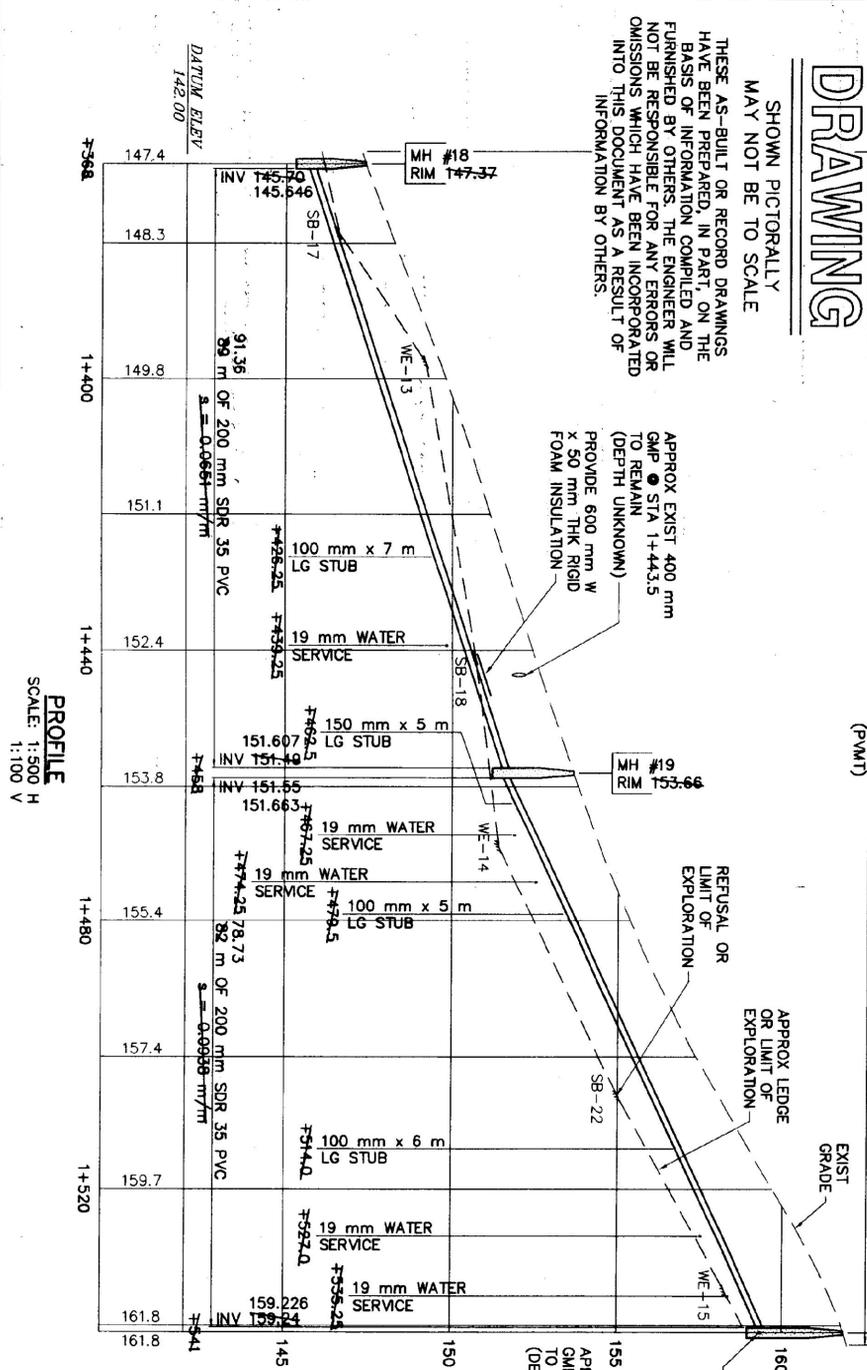


RECORD DRAWING

SHOWN PICTORALLY
MAY NOT BE TO SCALE

THESE AS-BUILT OR RECORD DRAWINGS
HAVE BEEN PREPARED, IN PART, ON THE
BASIS OF INFORMATION COMPILED AND
FURNISHED BY OTHERS. THE ENGINEER WILL
NOT BE RESPONSIBLE FOR ANY ERRORS OR
OMISSIONS WHICH HAVE BEEN INCORPORATED
INTO THIS DOCUMENT AS A RESULT OF
INFORMATION BY OTHERS.

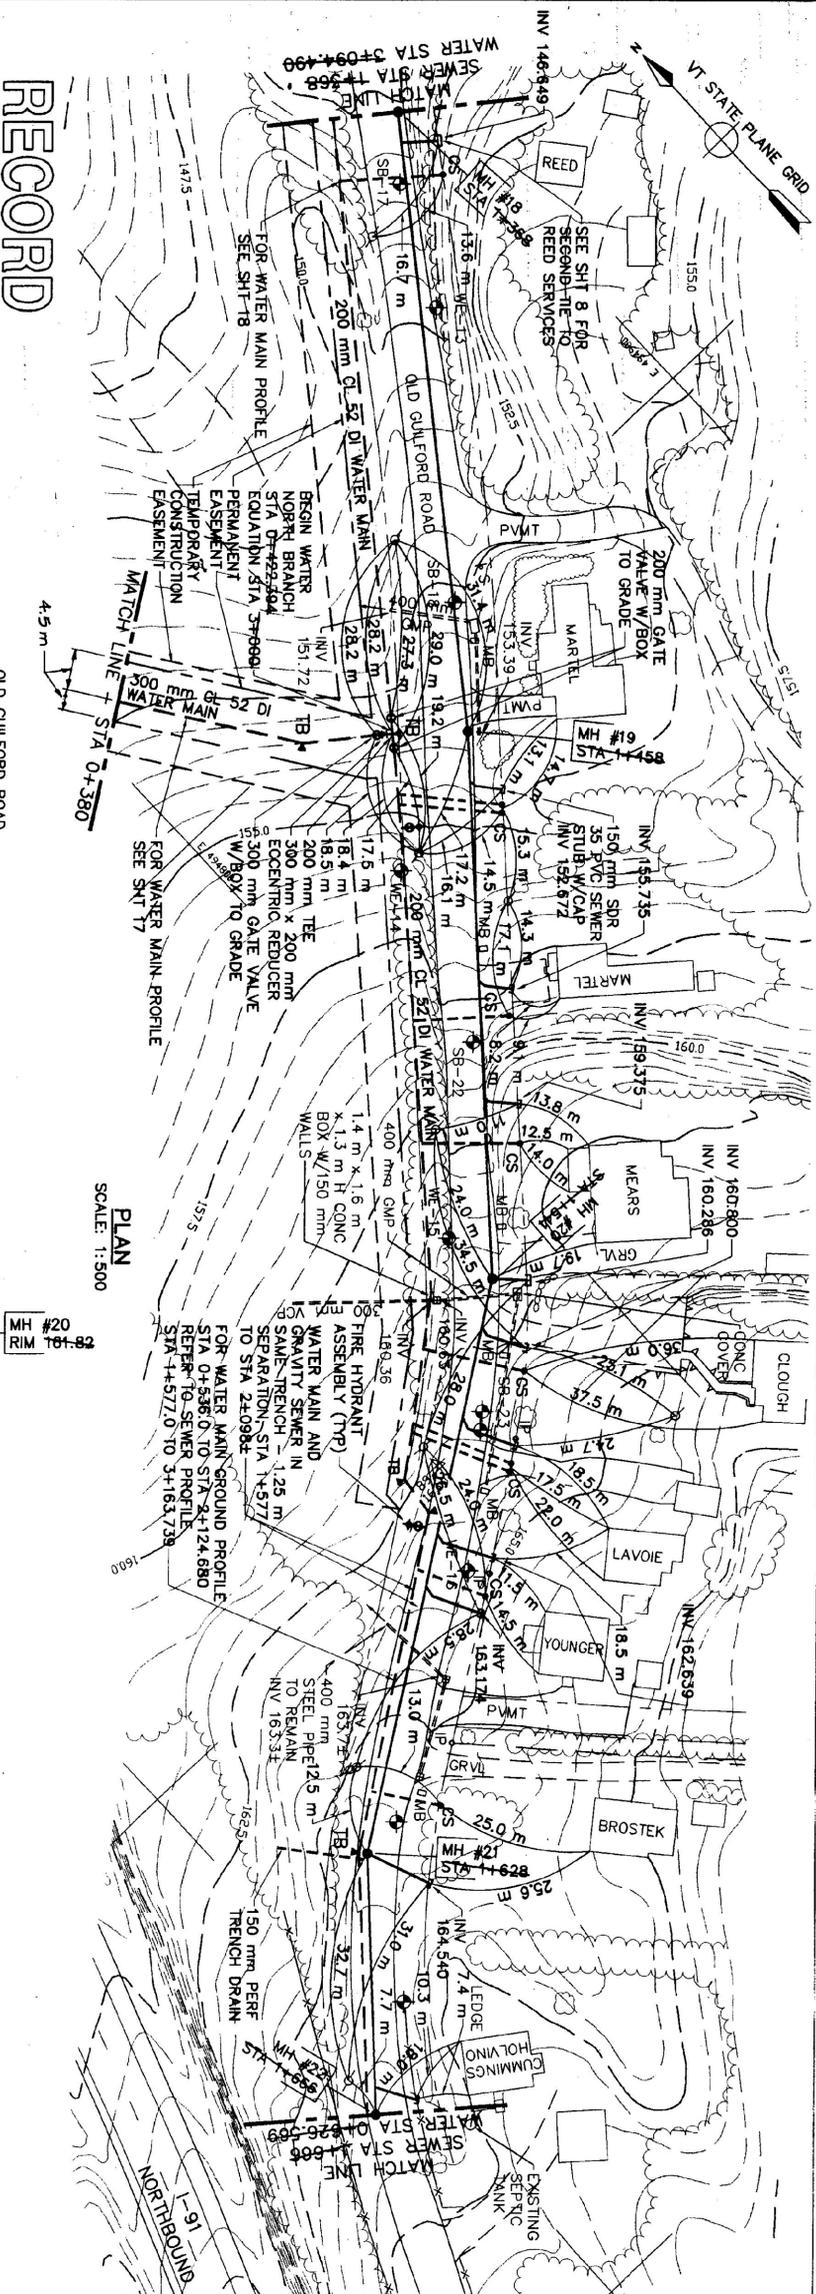

- NOTES:
1. ALL SEWER SERVICE STUBS ARE 100 mm UNLESS OTHERWISE NOTED
 2. ALL WATER SERVICES ARE 19 mm TYPE K COPPER WITH 19 mm COPPER & CLIP STOP W/BOX TO GRADE UNLESS OTHERWISE NOTED
 3. HYDRANTS LOCATED CLOSER THAN 3 m TO SEWER SHALL HAVE DRAIN PLUGGED
 4. CONNECT SEWER SERVICE @ STA 1+660.25 TO EXISTING 4" PIPE (CUMMINGS/HOLVINO)
- NOTE:
WHERE SEWER & WATER MAIN ARE IN SAME TRENCH (STA T+527 TO STA T+998.5) MIN 21 m OF COVER SHALL BE MAINTAINED OVER THE SEWER

5	9/3/96	AS-BUILT INFORMATION ADDED	DSM	KAS
4	1/2/96	CONTRACT PLANS	DSM	MPY
3	11/1/96	FINAL REVIEW REVISIONS	DSM	MPY
2	6/4/96	REVISIONS PER REVIEW COMMENTS	DSM	MPY
1	4/8/96	REVISIONS PER REVIEW COMMENTS	DSM	MPY
NO.	DATE	REVISIONS	DRWN	CHKD

TIMOTHY D. SMITH & ASSOCIATES, PC ARCHITECTS
 OLD RAILROAD STATION
 NORTH BENNINGTON, VERMONT 05257
 802-442-8184 FAX 802-442-9241

WRIGHT ENGINEERING, LTD. CIVIL ENGINEERS
 128 MERCHANTS ROW - P.O. BOX 176
 RUTLAND, VERMONT 05702-0176
 802-775-2511 FAX 802-775-8915

PROJECT NO. IM 091-1 (29)
 WATER & SEWER EXTENSION PROJECT
 TOWN OF GUILFORD
 TOWN OF BRATTLEBORO

SANITARY SEWER/WATER PLAN AND
 SANITARY SEWER PROFILE

STATE OF VERMONT
AGENCY OF TRANSPORTATION
 SOUTHEAST VERMONT WELCOME CENTER
 GUILFORD, VERMONT

DESIGN BY: JAC
 DRAWN BY: DSM
 CHECKED BY: JAC
 DATE: 1-2-96

SHEET NO. 10 OF 55 SHEETS

