

FOR WATER MAIN GROUND PROFILE
STA 0+536.0 TO STA 2+124.680
REFER TO SEWER PROFILE
STA 1+577.0 TO 3+163.739


PLAN
SCALE: 1:500

EXISTING CHAIR RAIL &
CHAIN LINK FENCE TO BE
REMOVED (10 m) AND
RESET IN SAME LOCATION

RECORD DRAWING

SHOWN PICTORALLY
MAY NOT BE TO SCALE

THESE AS-BUILT OR RECORD DRAWINGS
HAVE BEEN PREPARED, IN PART, ON THE
BASIS OF INFORMATION COMPILED AND
FURNISHED BY OTHERS. THE ENGINEER WILL
NOT BE RESPONSIBLE FOR ANY ERRORS OR
OMISSIONS WHICH HAVE BEEN INCORPORATED
INTO THIS DOCUMENT AS A RESULT OF
INFORMATION BY OTHERS.

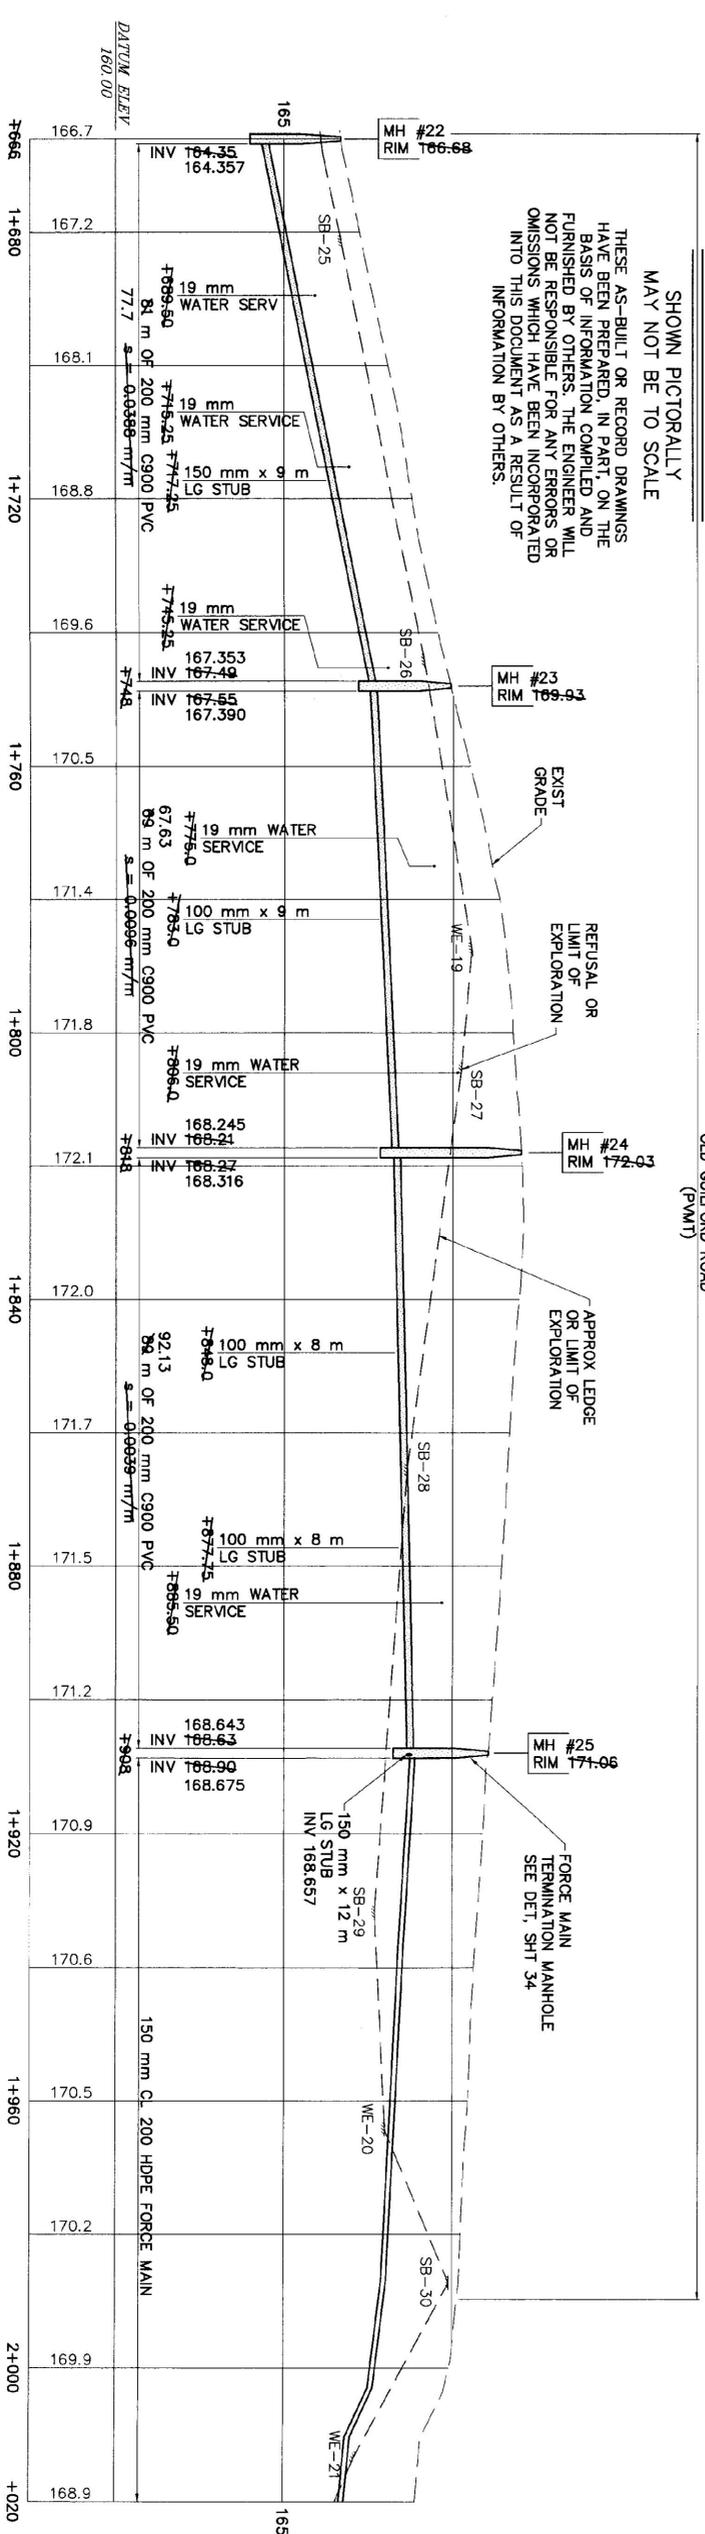

PROFILE
SCALE: 1:500 H
1:100 V

NOTE:
WHERE SEWER & WATER MAIN ARE
IN SAME TRENCH (STA 1+577 TO
STA 2+098.4) MIN 2.1 m OF COVER
SHALL BE MAINTAINED OVER THE SEWER

- NOTES:
1. ALL SEWER SERVICE STUBS ARE 100 mm UNLESS OTHERWISE NOTED.
 2. ALL WATER SERVICES ARE 19 mm TYPE K COPPER WITH 19 mm CURB STOP W/BOX TO GRADE UNLESS OTHERWISE NOTED.
 3. HYDRANTS LOCATED CLOSER THAN 3 m TO SEWER SHALL HAVE DRAIN PLUGGED

NO.	DATE	REVISIONS	DRWN	CHKD
1	4/9/96	REVISIONS PER REVIEW COMMENTS	MPY	MPY
2	6/4/96	REVISIONS PER REVIEW COMMENTS	MPY	MPY
3	11/1/96	FINAL REVIEW REVISIONS	MPY	MPY
4	12/26/96	CONTRACT PLANS	MPY	MPY
5	9/30/98	AS-BUILT INFORMATION ADDED	MPY	MPY

PROJECT NO. IM 091-1 (29)	PROJECT TITLE:
WATER & SEWER EXTENSION PROJECT	SANITARY SEWER, WATER PLAN AND
TOWN OF BRATTLEBORO	SANITARY SEWER PROFILE

DESIGN BY:	JAC
DRWN BY:	DSM
CHKD BY:	JAC

AGENCY OF TRANSPORTATION	STATE OF VERMONT
SOUTHEAST VERMONT WELCOME CENTER	GUILFORD, VERMONT

DATE:	1-2-98
SHEET NO.	11 OF 55 SHEETS



TIMOTHY D. SMITH & ASSOCIATES, PC ARCHITECTS
NORTH BENNINGTON, VERMONT 05257
802-442-0184

WRIGHT ENGINEERING, LTD.
RUTLAND, VERMONT 05702-0176
802-775-2511

CIVIL ENGINEERS