


RECORD DRAWING

SHOWN PICTORALLY
MAY NOT BE TO SCALE


THESE AS-BUILT OR RECORD DRAWINGS
HAVE BEEN PREPARED, IN PART, ON THE
BASIS OF INFORMATION COMPILED AND
FURNISHED BY OTHERS. THE ENGINEER WILL
NOT BE RESPONSIBLE FOR ANY ERRORS OR
OMISSIONS WHICH HAVE BEEN INCORPORATED
INTO THIS DOCUMENT AS A RESULT OF
INFORMATION BY OTHERS.

NOTE:
WHERE SEWER & WATER MAIN ARE
IN SAME TRENCH (STA 1+577 TO
STA 1+908) MIN 2.1 m OF COVER
SHALL BE MAINTAINED OVER THE SEWER

NOTE:
WHERE SEWER & WATER MAIN ARE
NOT IN SAME TRENCH 1.5 m OF
COVER SHALL BE MAINTAINED OVER
THE SEWER

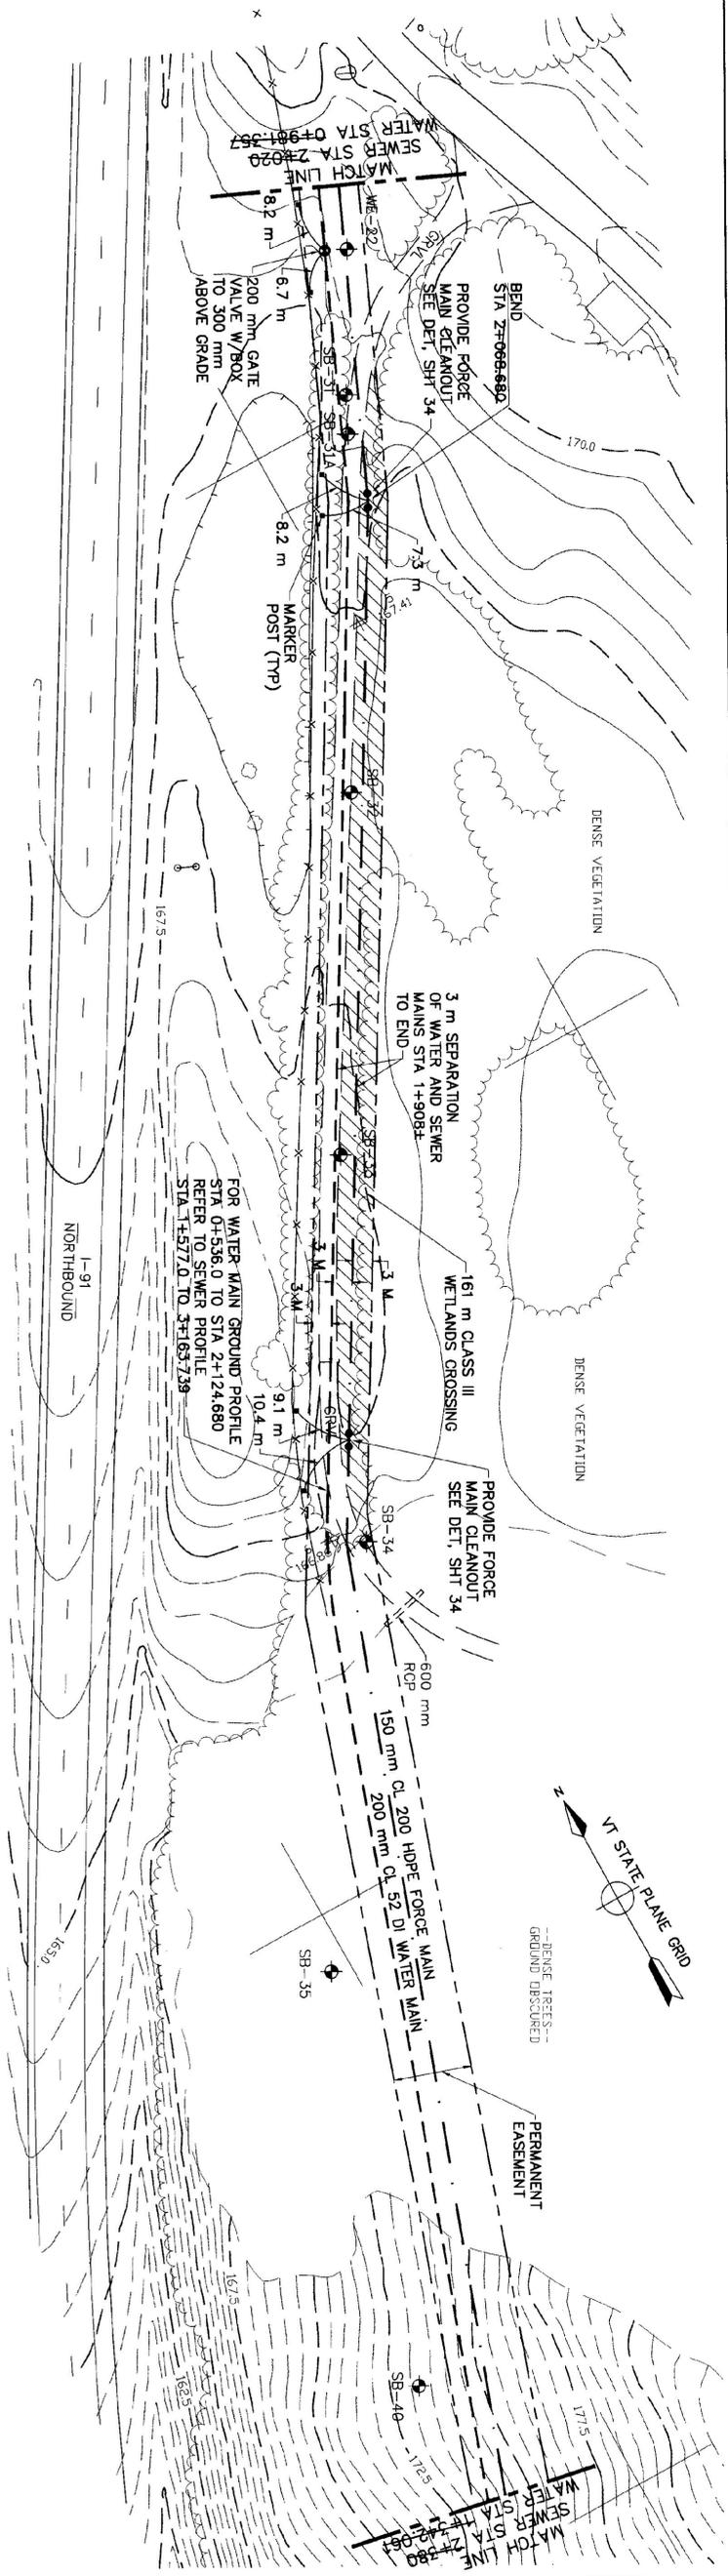

PLAN
SCALE: 1:500

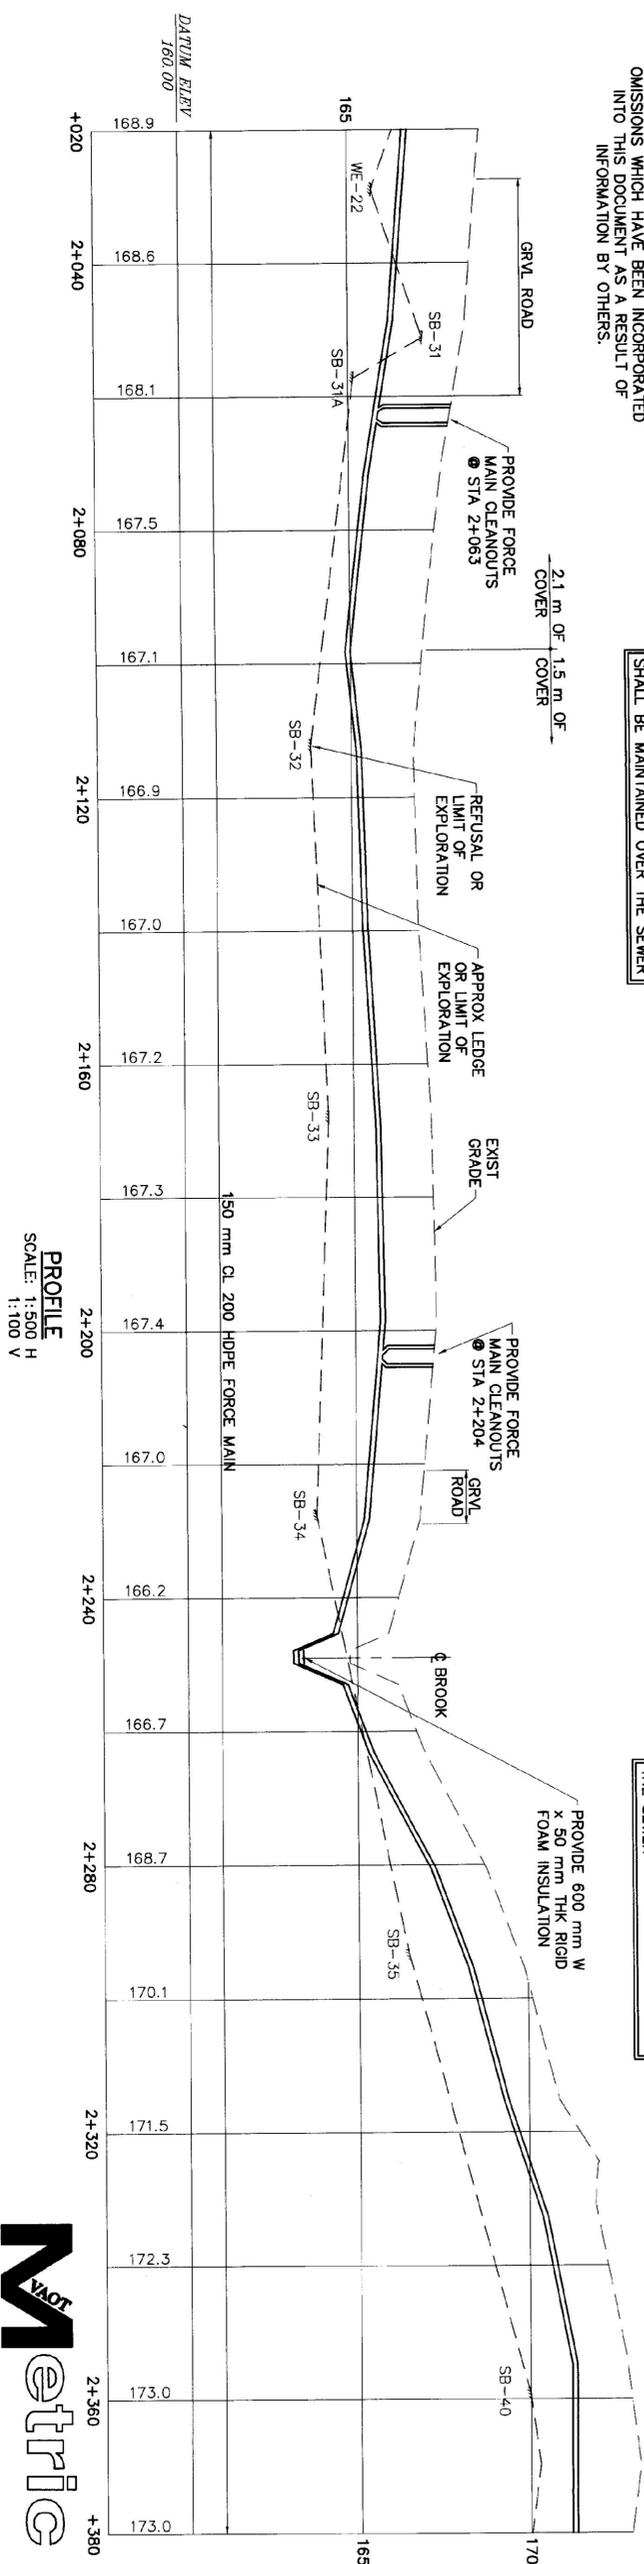

PROFILE
SCALE: 1:500 H
1:100 V

NO.	DATE	REVISIONS	DRWN	CHKD	NO.	DATE	REVISIONS	DRWN	CHKD
1	4/8/96	REVISIONS PER REVIEW COMMENTS	DSM	MPY	1	128 MERCHANTS ROW - P.O. BOX 176			
2	6/4/96	REVISIONS PER REVIEW COMMENTS	DSM	MPY	128 MERCHANTS ROW - P.O. BOX 176				
3	11/1/96	FINAL REVIEW REVISIONS	DSM	MPY	802-773-2511				
4	12/28/96	CONTRACT PLANS	DSM	MPY					
5	9/30/98	AS-BUILT INFORMATION ADDED	DSM	KAS					

DESIGN BY:	JAC	STATE OF VERMONT
DRAWN BY:	DSM	AGENCY OF TRANSPORTATION
CHECKED BY:	JAC	SOUTHEAST VERMONT WELCOME CENTER
DATE:	1-2-96	GULFORD, VERMONT

PROJECT NO.	IM 091-1 (29)
TOWN OF	GULFORD
TOWN OF	BRAITTLIBORO
SHEET TITLE:	SANITARY SEWER/WATER PLAN AND SANITARY SEWER PROFILE

DESIGN BY:	JAC
DRAWN BY:	DSM
DATE:	1-2-96
SHEET NO.	12 OF 55 SHEETS



TIMOTHY D. SMITH & ASSOCIATES, PC ARCHITECTS
NORTH BENNINGTON, VERMONT 05257
FAX 802-442-5241

WRIGHT ENGINEERING, LTD. CIVIL ENGINEERS
RUTLAND, VERMONT 05702-0176
FAX 802-775-8915