


PLAN
SCALE: 1:500

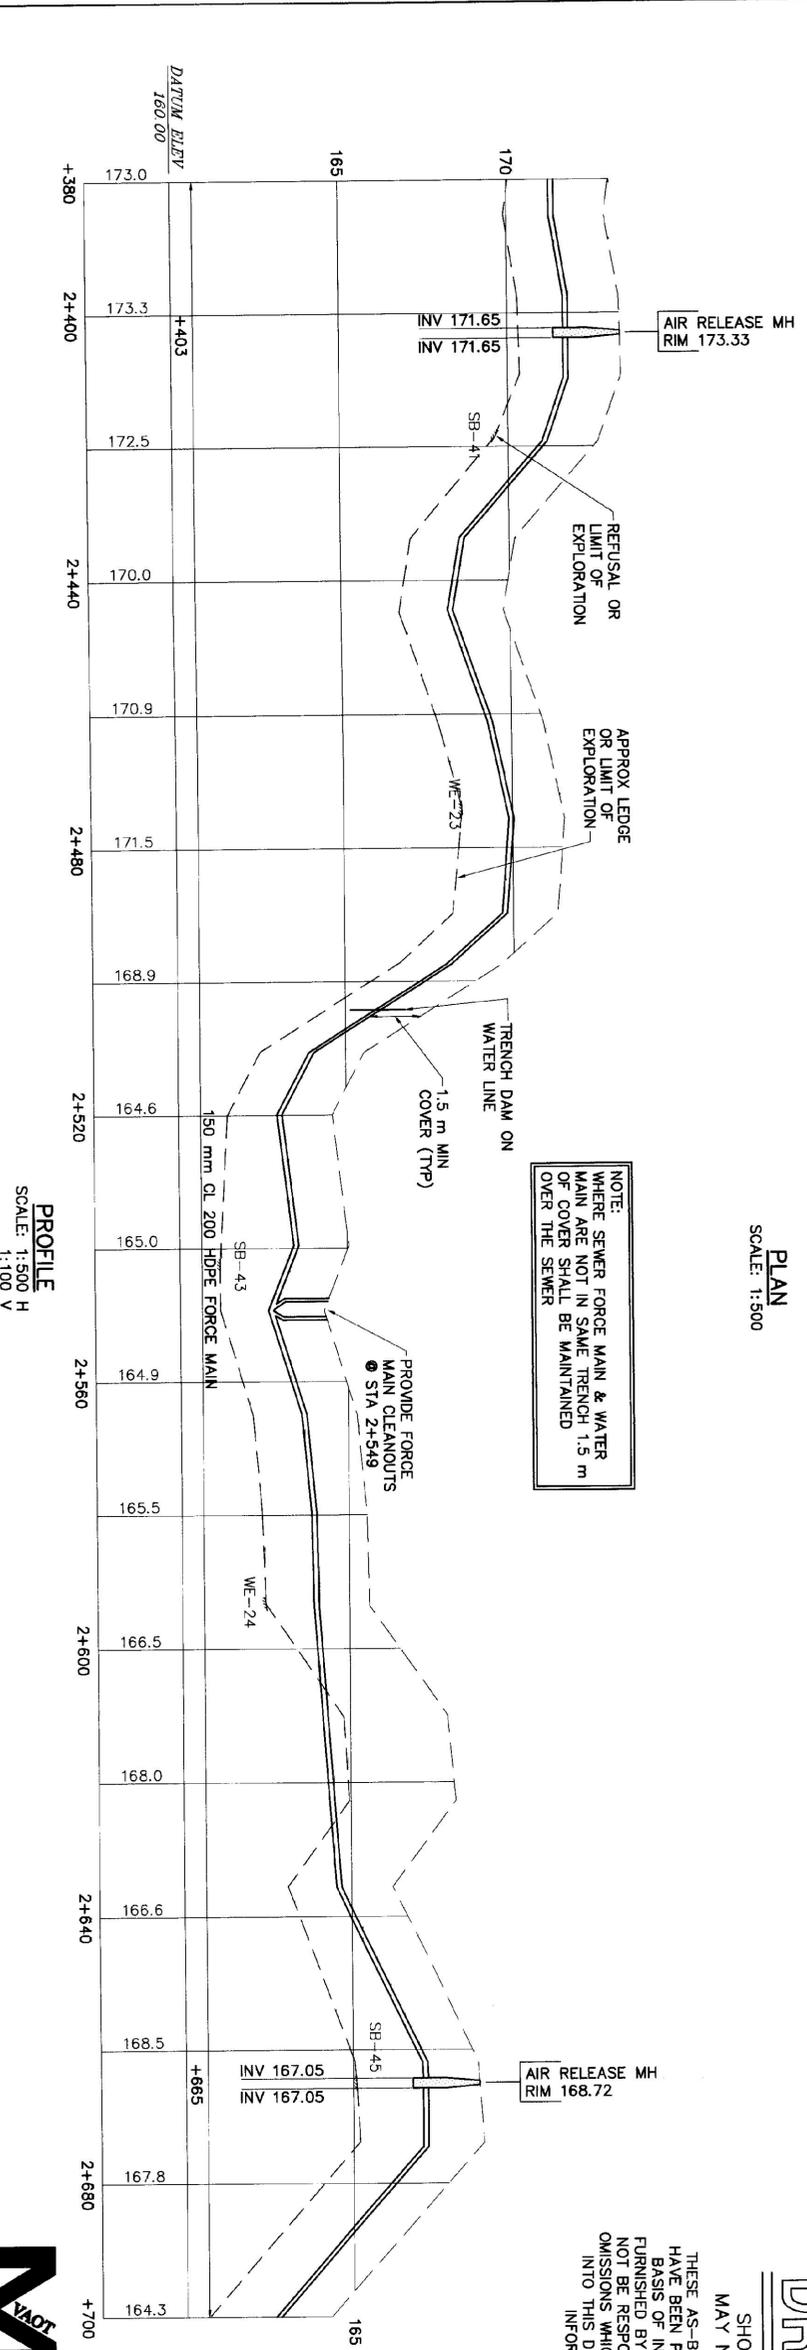

PROFILE
SCALE: 1:500 H
1:100 V

NOTE:
WHERE SEWER FORCE MAIN & WATER
MAIN ARE NOT IN SAME TRENCH 1.5 m
OF COVER SHALL BE MAINTAINED
OVER THE SEWER

**RECORD
DRAWING**

SHOWN PICTORALLY
MAY NOT BE TO SCALE

THESE AS-BUILT OR RECORD DRAWINGS
HAVE BEEN PREPARED, IN PART, ON THE
BASIS OF INFORMATION COMPILED AND
FURNISHED BY OTHERS. THE ENGINEER WILL
NOT BE RESPONSIBLE FOR ANY ERRORS OR
OMISSIONS WHICH HAVE BEEN INCORPORATED
INTO THIS DOCUMENT AS A RESULT OF
INFORMATION BY OTHERS.



NO.	DATE	REVISIONS	DRWN	CHKD
1	4/8/96	REVISIONS PER REVIEW COMMENTS	MPY	
2	6/4/96	REVISIONS PER REVIEW COMMENTS	MPY	
3	11/1/96	FINAL REVIEW REVISIONS	MPY	
4	12/29/96	CONTRACT PLANS	MPY	
5	9/30/98	AS-BUILT INFORMATION ADDED	KAS	

TIMOTHY D. SMITH & ASSOCIATES, PC ARCHITECTS OLD RAILROAD STATION NORTH BENNINGTON, VERMONT 05257 FAX 802-442-8241	CIVIL ENGINEERS WRIGHT ENGINEERING, LTD. 128 MERCHANTS ROW - P.O. BOX 176 RUTLAND, VERMONT 05702-0176 FAX 802-775-8915
---	--

PROJECT NO. IM 091-1 (29) WATER & SEWER EXTENSION PROJECT TOWN OF GUILDFORD TOWN OF BRATTLEBORO	SHEET TITLE: SANITARY SEWER/WATER PLAN AND SANITARY SEWER PROFILE
--	---

DSGN BY: JAC DRWN BY: DSM CHKD BY: JAC	DSGN BY: JAC DRWN BY: DSM CHKD BY: JAC
--	--

STATE OF VERMONT AGENCY OF TRANSPORTATION SOUTHEAST VERMONT WELCOME CENTER GUILDFORD, VERMONT	DATE: 1-2-96 SHEET NO. 13 OF 55 SHEETS
--	---