
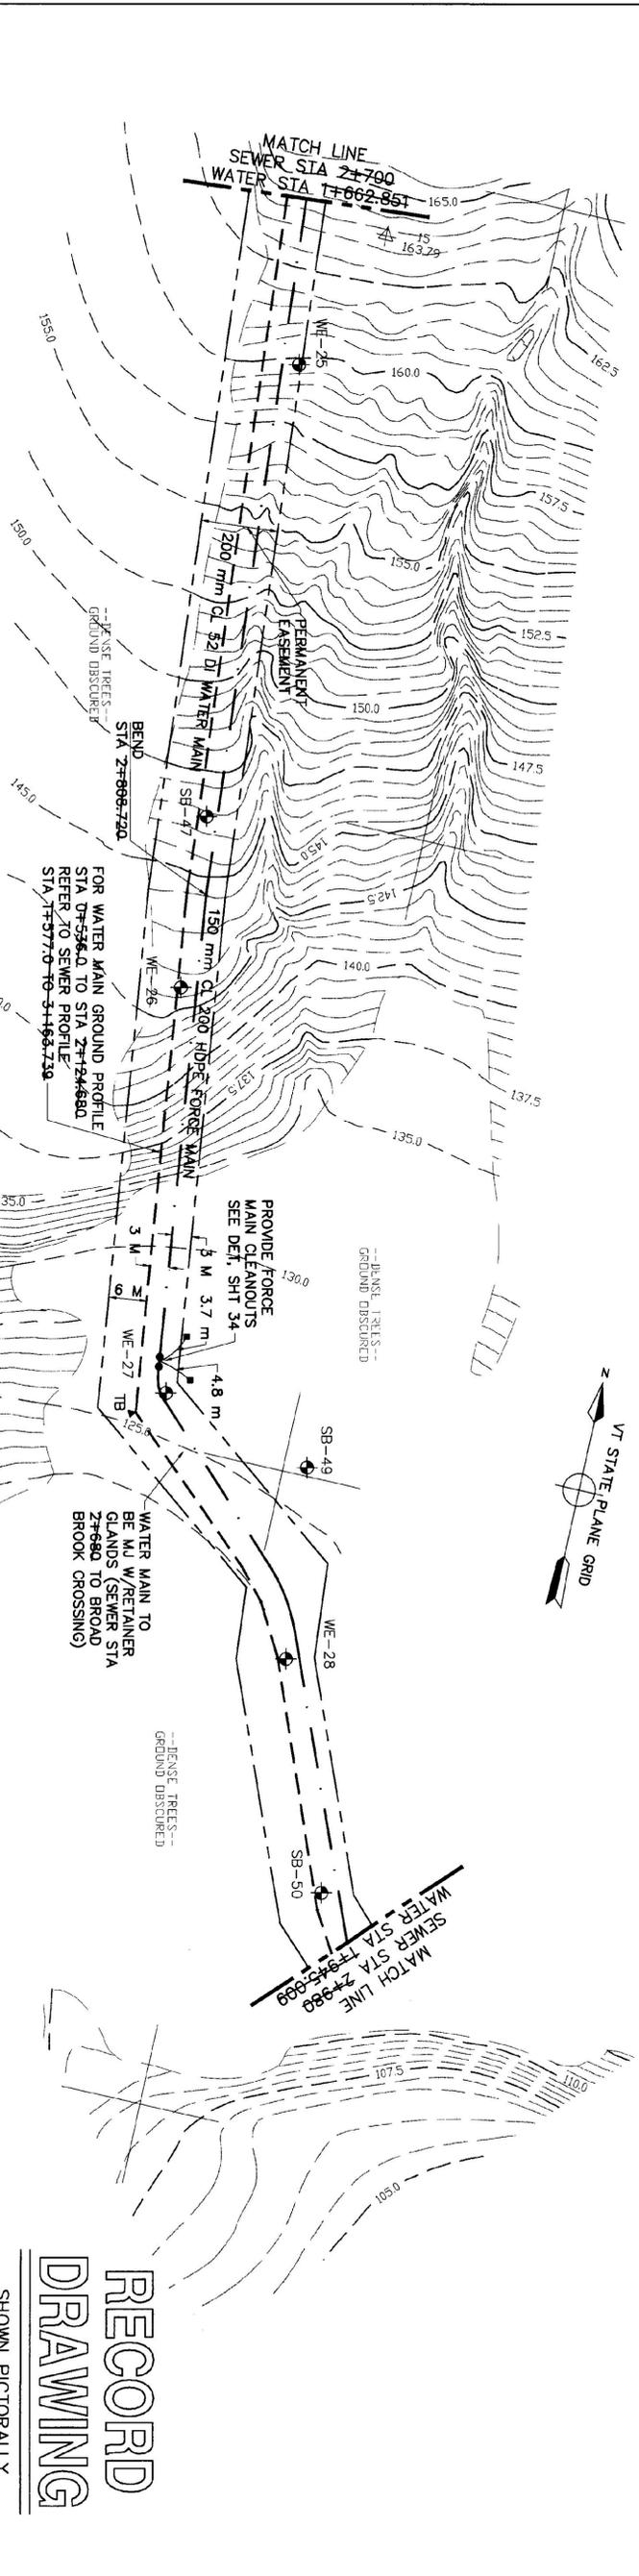


5	9/30/98	AS-BUILT INFORMATION ADDED	DSM	KAS	TIMOTHY D. SMITH & ASSOCIATES, PC ARCHITECTS		PROJECT NO. IM 091-1 (29) WATER & SEWER EXTENSION PROJECT TOWN OF GUILFORD TOWN OF BRATTLEBORO	SHEET TITLE: SANITARY SEWER/WATER PLAN AND SANITARY SEWER PROFILE	DSGN BY: JAC DRWN BY: DSM CHKD BY: JAC	STATE OF VERMONT AGENCY OF TRANSPORTATION SOUTHEAST VERMONT WELCOME CENTER GUILFORD, VERMONT
4	12/28/98	CONTRACT PLANS	DSM	MPY	OLD RAILROAD STATION					
3	11/11/98	FINAL REVIEW REVISIONS	DSM	MPY	NORTH BENNINGTON, VERMONT 05257					
2	6/4/98	REVISIONS PER REVIEW COMMENTS	DSM	MPY	802-442-8184					
1	4/8/98	REVISIONS PER REVIEW COMMENTS	DSM	MPY	802-442-5241					
NO. DATE		REVISIONS	DRWN	CHKD	WRIGHT ENGINEERING, LTD. 128 MERCHANTS ROW - P.O. BOX 176 RUTLAND, VERMONT 05702-0176 802-775-2511	CIVIL ENGINEERS VERMONT 05702-0176 FAX 802-775-8915				

**PROFILE**  
SCALE: 1:500 H  
1:100 V

**PROFILE**  
SCALE: 1:500 H  
1:100 V

**PROFILE**  
SCALE: 1:500 H  
1:100 V

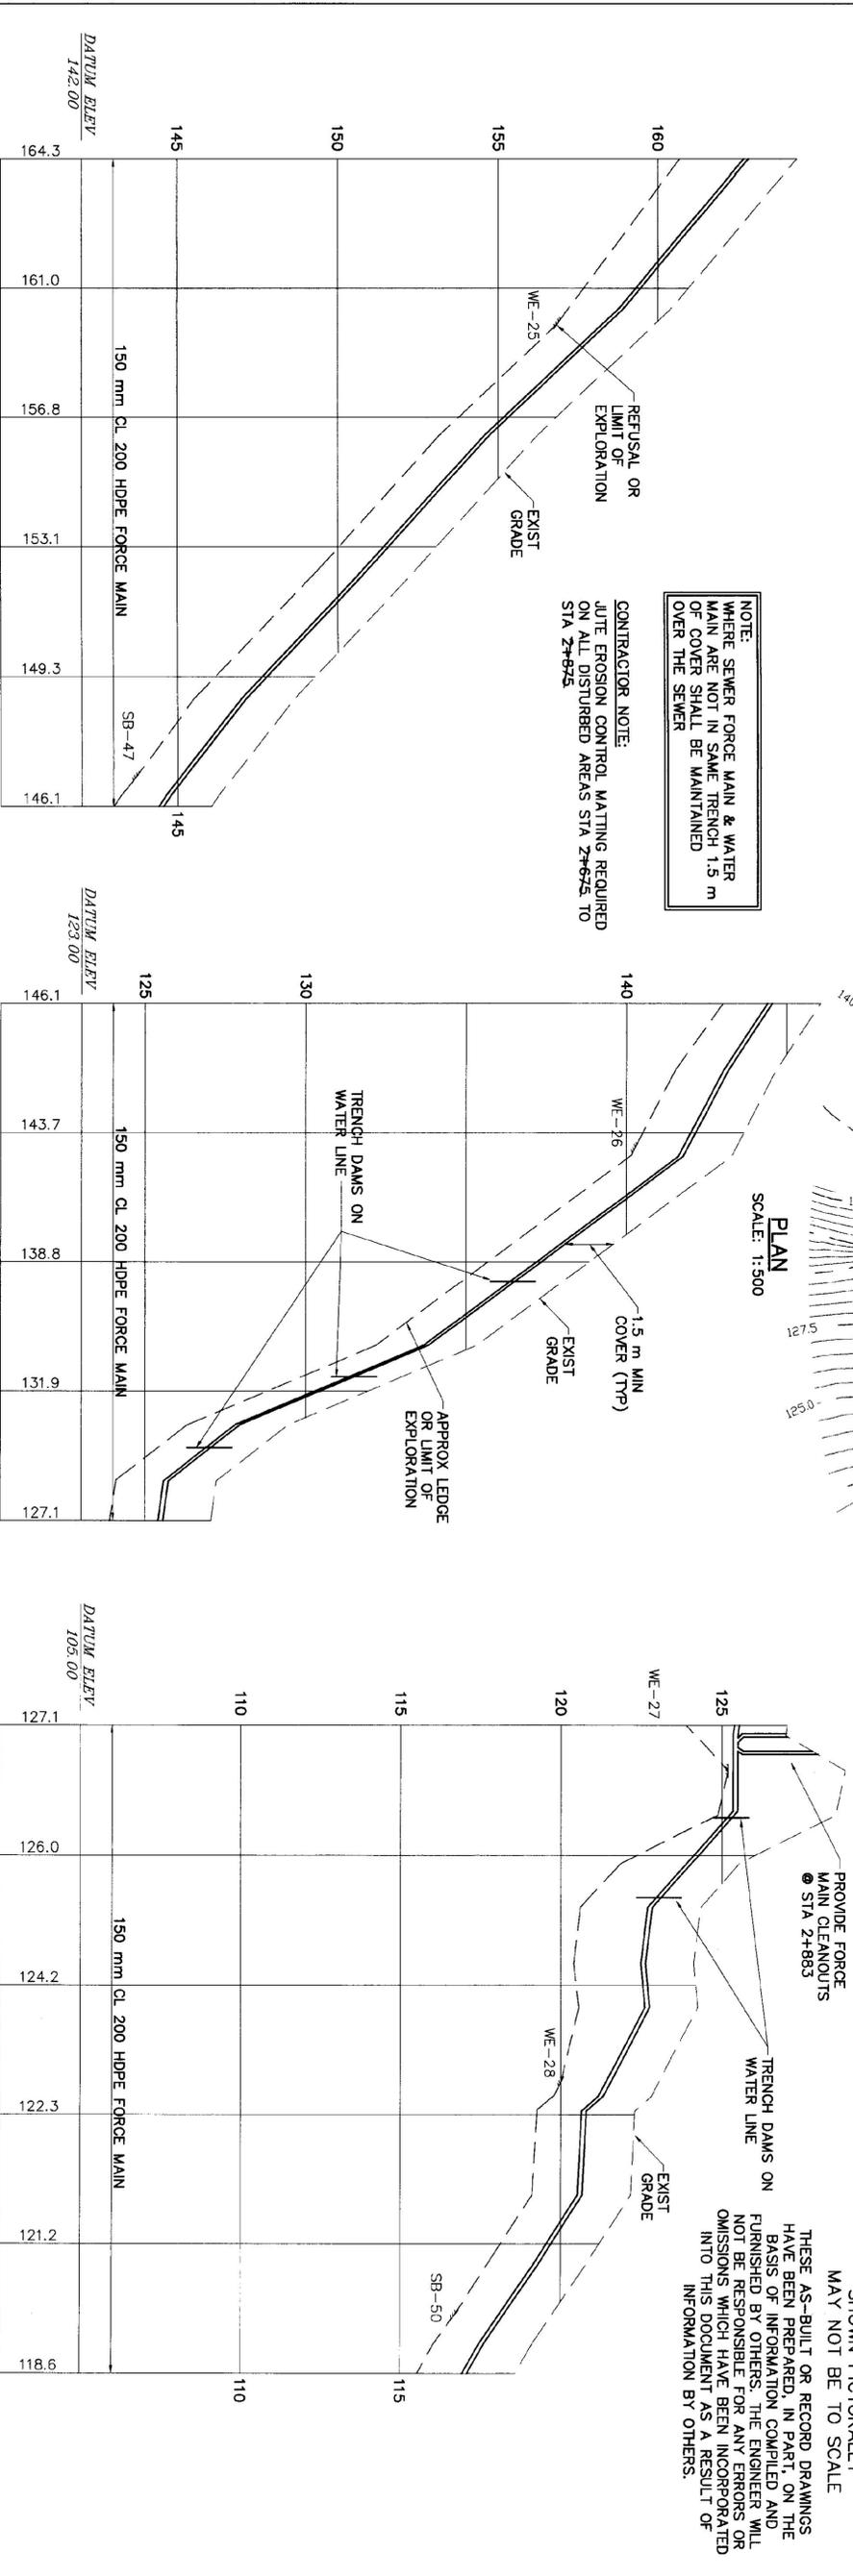

**RECORD DRAWING**

SHOWN PICTORALLY  
MAY NOT BE TO SCALE

THESE AS-BUILT OR RECORD DRAWINGS HAVE BEEN PREPARED, IN PART, ON THE BASIS OF INFORMATION COMPILED AND FURNISHED BY OTHERS. THE ENGINEER WILL NOT BE RESPONSIBLE FOR ANY ERRORS OR OMISSIONS WHICH HAVE BEEN INCORPORATED INTO THIS DOCUMENT AS A RESULT OF INFORMATION BY OTHERS.