


NOTE:  
FOR WATER MAIN PLAN  
SEE SHIS 15 & 16

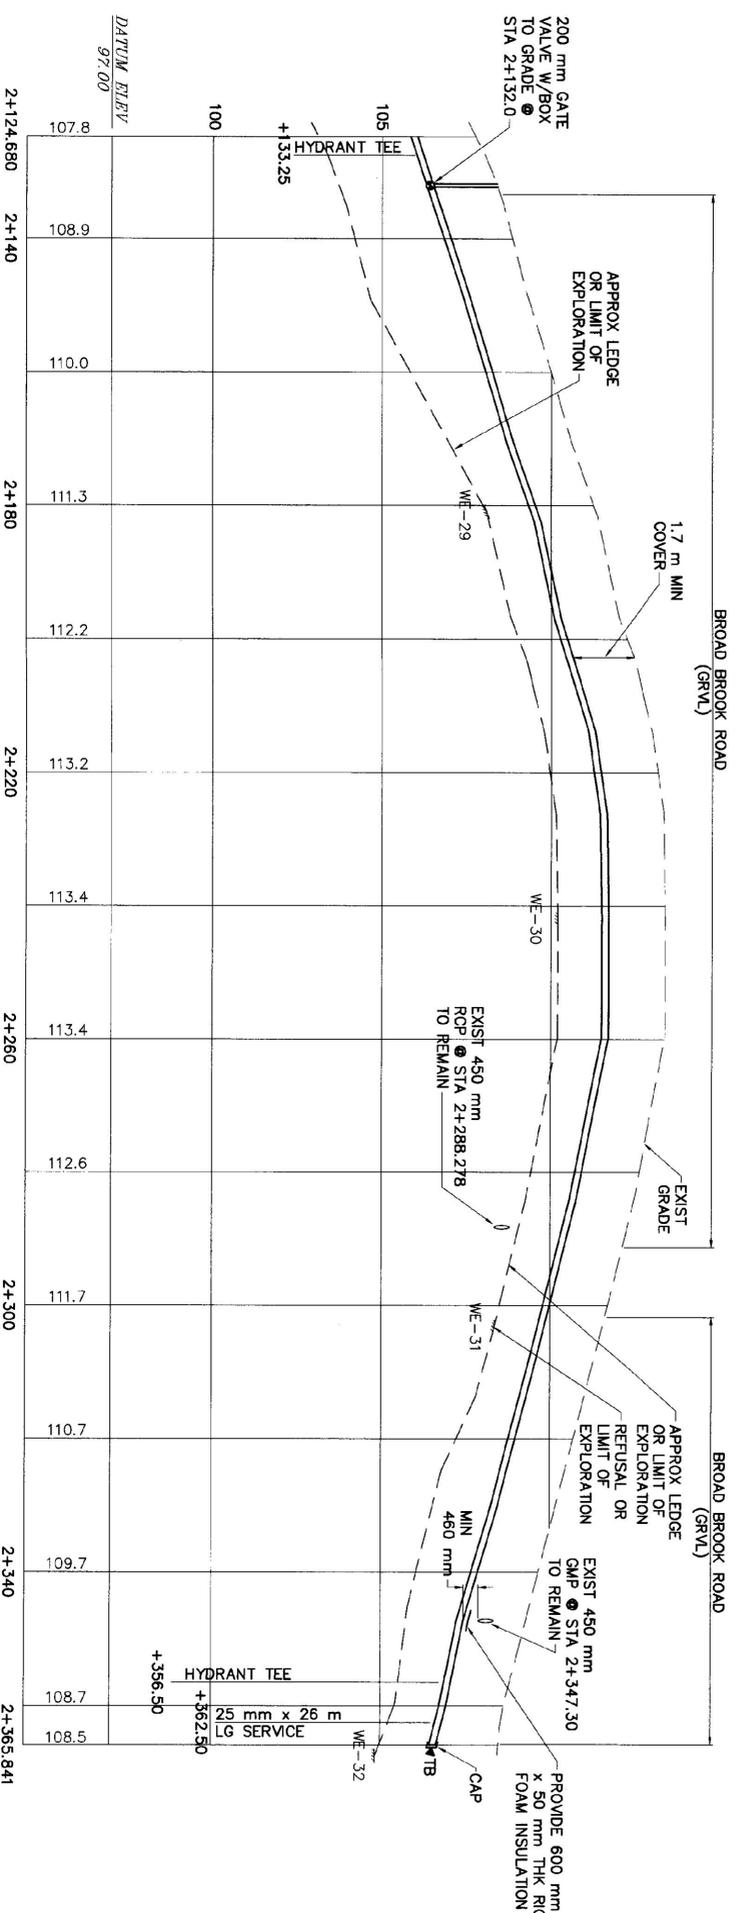

**WATER MAIN PROFILE**  
SCALE: 1:500 H  
1:100 V

**RECORD  
DRAWING**

SHOWN PICTORALLY  
MAY NOT BE TO SCALE

THESE AS-BUILT OR RECORD DRAWINGS  
HAVE BEEN PREPARED, IN PART, ON THE  
BASIS OF INFORMATION COMPILED AND  
FURNISHED BY OTHERS. THE ENGINEER WILL  
NOT BE RESPONSIBLE FOR ANY ERRORS OR  
OMISSIONS WHICH HAVE BEEN INCORPORATED  
INTO THIS DOCUMENT AS A RESULT OF  
INFORMATION BY OTHERS.



NO.	DATE	REVISIONS	DRWN	CHKD	128 MERCHANTS ROW - P.O. BOX 176 RUTLAND, VERMONT 05702-0176 FAX 802-773-8915		<p>PROJECT NO. JM 091-1 (29)</p> <p>WATER &amp; SEWER EXTENSION PROJECT</p> <p>TOWN OF GUILFORD</p> <p>TOWN OF BRATTLEBORO</p>	<p>DESIGN BY: JAC</p> <p>DRWN BY: DSM</p> <p>CHKD BY: JAC</p>	<p>STATE OF VERMONT</p> <p>AGENCY OF TRANSPORTATION</p> <p>SOUTHEAST VERMONT WELCOME CENTER</p> <p>GUILFORD, VERMONT</p>
1	4/8/96	REVISIONS PER REVIEW COMMENTS	DSM	MPY	128 MERCHANTS ROW - P.O. BOX 176 RUTLAND, VERMONT 05702-0176 FAX 802-773-8915				
2	6/4/96	REVISIONS PER REVIEW COMMENTS	DSM	MPY	128 MERCHANTS ROW - P.O. BOX 176 RUTLAND, VERMONT 05702-0176 FAX 802-773-8915				
3	11/1/96	FINAL REVIEW REVISIONS	DSM	MPY	128 MERCHANTS ROW - P.O. BOX 176 RUTLAND, VERMONT 05702-0176 FAX 802-773-8915				
4	12/6/96	CONTRACT PLANS	DSM	MPY	128 MERCHANTS ROW - P.O. BOX 176 RUTLAND, VERMONT 05702-0176 FAX 802-773-8915				
5	9/26/96	NO AS-BUILT INFORMATION ADDED	DSM	KAS	128 MERCHANTS ROW - P.O. BOX 176 RUTLAND, VERMONT 05702-0176 FAX 802-773-8915				