



DL-1 DOORS NO. 1 2


DOOR HEAD DETAILS AND LINTEL MARKS  
SCALE: 1:5

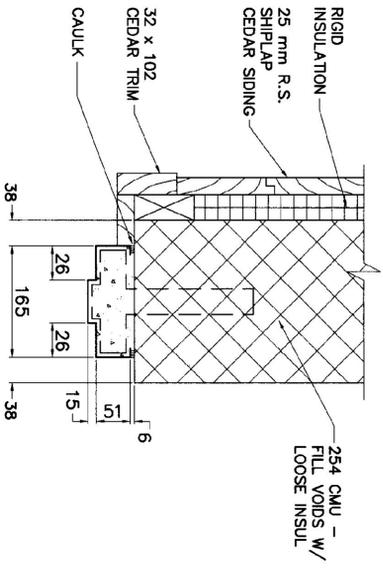

DOOR JAMB DETAILS  
SCALE: 1:5

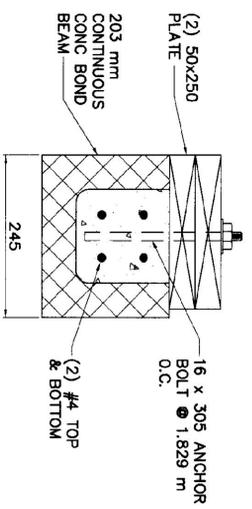


CONCRETE BOND BEAM DETAIL  
SCALE: 1:5

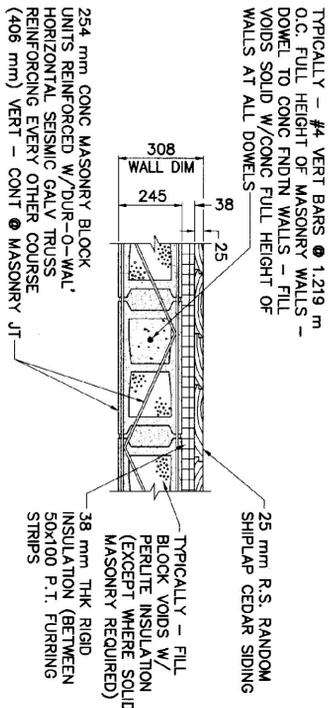


EXTERIOR WALL REINFORCEMENT DETAIL  
NOT TO SCALE

DOOR SCHEDULE							REMARKS
DOOR NUMBER	SIZE	MATERIAL	TYPE	FRAME MATERIAL	SADDLE MATERIAL	LINTEL	
1	914 x 2,134 x 45	INSULATED HOLLOW METAL	1	HOLLOW METAL	ALUMINIUM	DL-1	TOP MOUNTED DOOR CLOSER, FULL WEATHERSTRIP, INSULATED CORE
2	(2) 914 x 2,134 x 45	INSULATED HOLLOW METAL	1	HOLLOW METAL	ALUMINIUM	DL-1	TOP MOUNTED DOOR CLOSER, FULL WEATHERSTRIP, INSULATED CORE
3	2,134 x 2,286 x 45	R.S. CEDAR	2	N/A	N/A	N/A	SCREWED AND GLUED, EDGE BAND W/R.S. CEDAR

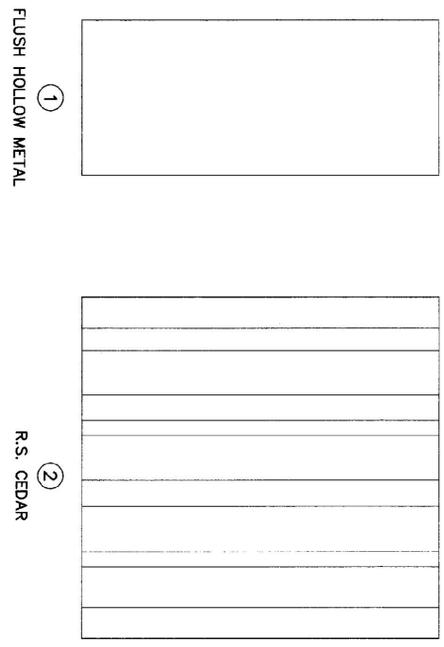

DOOR TYPES  
SCALE: 1:20

**RECORD DRAWING**  
SHOWN PICTORALLY  
MAY NOT BE TO SCALE  
THESE AS-BUILT OR RECORD DRAWINGS HAVE BEEN PREPARED, IN PART, ON THE BASIS OF INFORMATION COMPILED AND FURNISHED BY OTHERS. THE ENGINEER WILL NOT BE RESPONSIBLE FOR ANY ERRORS OR OMISSIONS WHICH HAVE BEEN INCORPORATED INTO THIS DOCUMENT AS A RESULT OF INFORMATION BY OTHERS.

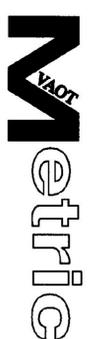

5	9/30/98	NO AS-BUILT INFORMATION ADDED	DSM	KAS	TIMOTHY D. SMITH & ASSOCIATES, PC ARCHITECTS				
4	12/26/98	CONTRACT PLANS	DSM	MPY	OLD RAILROAD STATION				
3	11/11/98	FINAL REVIEW REVISIONS	DSM	MPY	802-442-8184				
2	6/4/96	REVISIONS PER REVIEW COMMENTS	DSM	MPY	WRIGHT ENGINEERING, LTD.				
1	4/8/96	REVISIONS PER REVIEW COMMENTS	DSM	MPY	128 MERCHANTS ROW - P.O. BOX 176				
		REVISIONS	DRWN	CHKD	802-775-2511				

PROJECT NO. IM 091-1 (29)	DESIGN BY: MPY	STATE OF VERMONT
WATER & SEWER EXTENSION PROJECT	DRWN BY: DSM	AGENCY OF TRANSPORTATION
TOWN OF BRATTLEBORO	CHKD BY: JAC	SOUTHEAST VERMONT WELCOME CENTER
	CHKD BY: MPY	GUILFORD, VERMONT
SHEET TITLE: PUMP STATION DETAILS, DOOR LINTEL MARKS, DOOR FRAME DETAILS	DATE: 1-2-96	SHEET NO. 27 OF 55 SHEETS