


**BASE SLAB PLAN  
BOTTOM MAT**  
SCALE: 1:50

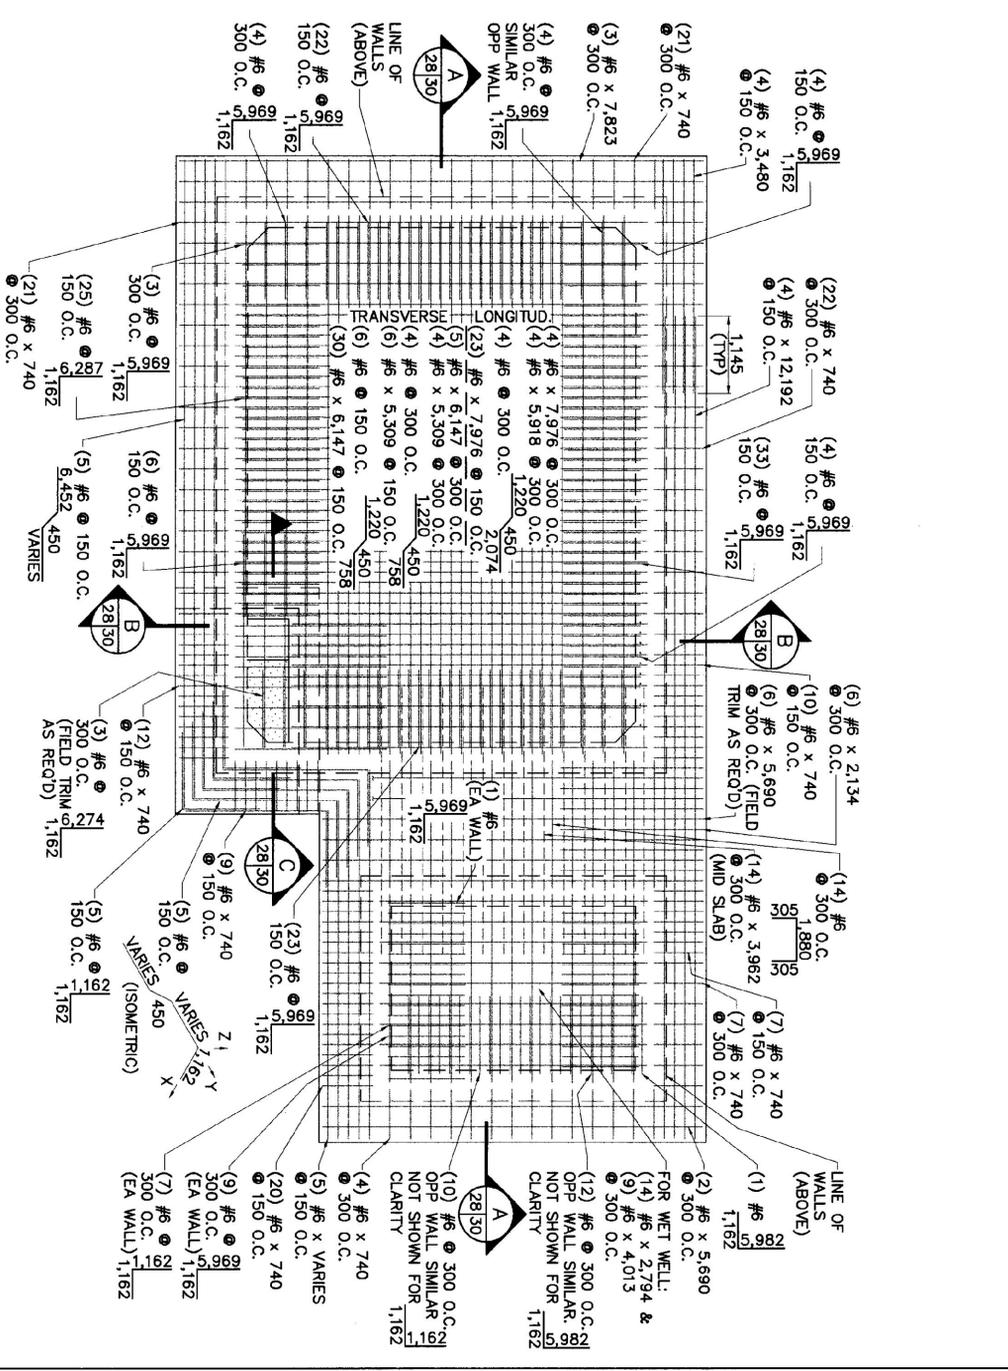


**BASE SLAB PLAN  
TOP MAT**  
SCALE: 1:50

**RECORD  
DRAWING**

SHOWN PICTORALLY  
MAY NOT BE TO SCALE

THESE AS-BUILT OR RECORD DRAWINGS  
HAVE BEEN PREPARED, IN PART, ON THE  
BASIS OF INFORMATION COMPILED AND  
FURNISHED BY OTHERS. THE ENGINEER WILL  
NOT BE RESPONSIBLE FOR ANY ERRORS OR  
OMISSIONS WHICH HAVE BEEN INCORPORATED  
INTO THIS DOCUMENT AS A RESULT OF  
INFORMATION BY OTHERS.

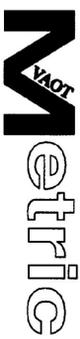

NO.	DATE	REVISIONS	DRWN	CHKD
5	9/30/98	NO AS-BUILT INFORMATION ADDED	DSM	KAS
4	12/29/96	CONTRACT PLANS	DSM	MPY
3	11/11/96	FINAL REVIEW REVISIONS	DSM	MPY
2	6/4/96	REVISIONS PER REVIEW COMMENTS	DSM	MPY
1	4/8/96	REVISIONS PER REVIEW COMMENTS	DSM	MPY

**TIMOTHY D. SMITH & ASSOCIATES, PC ARCHITECTS**  
OLD RAILROAD STATION  
802-442-0184  
NORTH BENNINGTON, VERMONT 05257  
FAX 802-442-5241

**CIVIL ENGINEERS**  
RUTLAND, VERMONT 05702-0176  
FAX 802-775-8915



PROJECT NO. IM 091-1 (29)  
**WATER & SEWER EXTENSION PROJECT**  
TOWN OF GUILFORD  
TOWN OF BRATTLEBORO

SHEET TITLE: PUMP STATION BASE SLAB PLANS

DSGN BY: KAS  
DRWN BY: DSM  
CHKD BY: KAS

STATE OF VERMONT  
**AGENCY OF TRANSPORTATION**  
SOUTHEAST VERMONT WELCOME CENTER  
GUILFORD, VERMONT

DATE: 1-2-96  
SHEET NO. 28 OF 55 SHEETS