


- NOTES:**
1. ALL SLEEVE DIMENSIONS SHOWN ARE EXTERIOR MEASUREMENTS.
 2. ALL SLEEVE PLACEMENTS SHALL ALLOW FOR 55 mm MINIMUM CLEAR COVER FROM SLAB OR WALL REINFORCEMENT. SHOULD THIS NOT BE POSSIBLE IN ISOLATED LOCATIONS, AS DIRECTED BY THE ENGINEER, PROVISIONS OF THE SLAB/WALL OPENING DETAIL SHALL APPLY IN TOTAL.
 3. ALL SLEEVES AND SWEEPS SHALL BE PRESET. CORING SHALL NOT BE ALLOWED.

**RECORD
DRAWING**

SHOWN PICTORALLY
MAY NOT BE TO SCALE

THESE AS-BUILT OR RECORD DRAWINGS HAVE BEEN PREPARED, IN PART, ON THE BASIS OF INFORMATION COMPILED AND FURNISHED BY OTHERS. THE ENGINEER WILL NOT BE RESPONSIBLE FOR ANY ERRORS OR OMISSIONS WHICH HAVE BEEN INCORPORATED INTO THIS DOCUMENT AS A RESULT OF INFORMATION BY OTHERS.

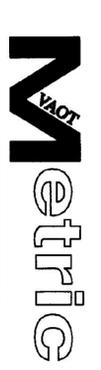

NO.	DATE	REVISIONS	DRWN	CHKD
5	9/30/98	NO AS-BUILT INFORMATION ADDED	DSM	KAS
4	12/26/98	CONTRACT PLANS	DSM	MPY
3	1/11/99	FINAL REVIEW REVISIONS	DSM	MPY
2	6/4/99	REVISIONS PER REVIEW COMMENTS	DSM	MPY
1	4/8/98	REVISIONS PER REVIEW COMMENTS	DSM	MPY

TIMOTHY D. SMITH & ASSOCIATES, PC ARCHITECTS	NORTH BENNINGTON, VERMONT 05257	802-442-8184	FAX 802-442-5241
CIVIL ENGINEERS	128 MERCHANTS ROW - P.O. BOX 176	RUTLAND, VERMONT 05702-0176	FAX 802-775-8915

PROJECT NO. IM 091-1 (29)	WATER & SEWER EXTENSION PROJECT
TOWN OF GUILDFORD	TOWN OF BRATTLEBORO
SHEET TITLE: PUMP STATION FOUNDATION AND FIRST FLOOR SLAB PLANS - STRUCTURAL	

DSGN BY: KAS	DRWN BY: DSM	CHKD BY: KAS
DATE: 1-2-96	SHEET NO. 29	OF 55 SHEETS

STATE OF VERMONT	AGENCY OF TRANSPORTATION
SOUTHEAST VERMONT WELCOME CENTER	GUILDFORD, VERMONT