


BARRIER STABILIZATION DETAIL
NOT TO SCALE


300 mm x 900 mm OBJECT MARKER TO BE INSTALLED AT END OF BARRIER. TAPER STRIPES SLOPE DOWNWARD TOWARD THE SIDE OF THE BARRIER ON WHICH TRAFFIC IS TO PASS. MOUNTING IS DETERMINED BY CONTRACTOR.

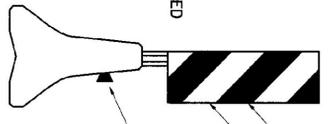

BARRIER MARKER DETAIL
NOT TO SCALE

BLACK REFLECTORIZED YELLOW SHEETING (TYPE II OR III) YELLOW REFLECTORS SHALL BE MOUNTED EVERY 6.1 m ALONG THE SIDE OF THE BARRIER.

NOTE: BARRIER CONFIGURATION, FLASHING ARROW BOARD AND SIGNAGE FOR I-91 SOUTHBOUND IDENTICAL TO THAT SHOWN FOR I-91 NORTHBOUND

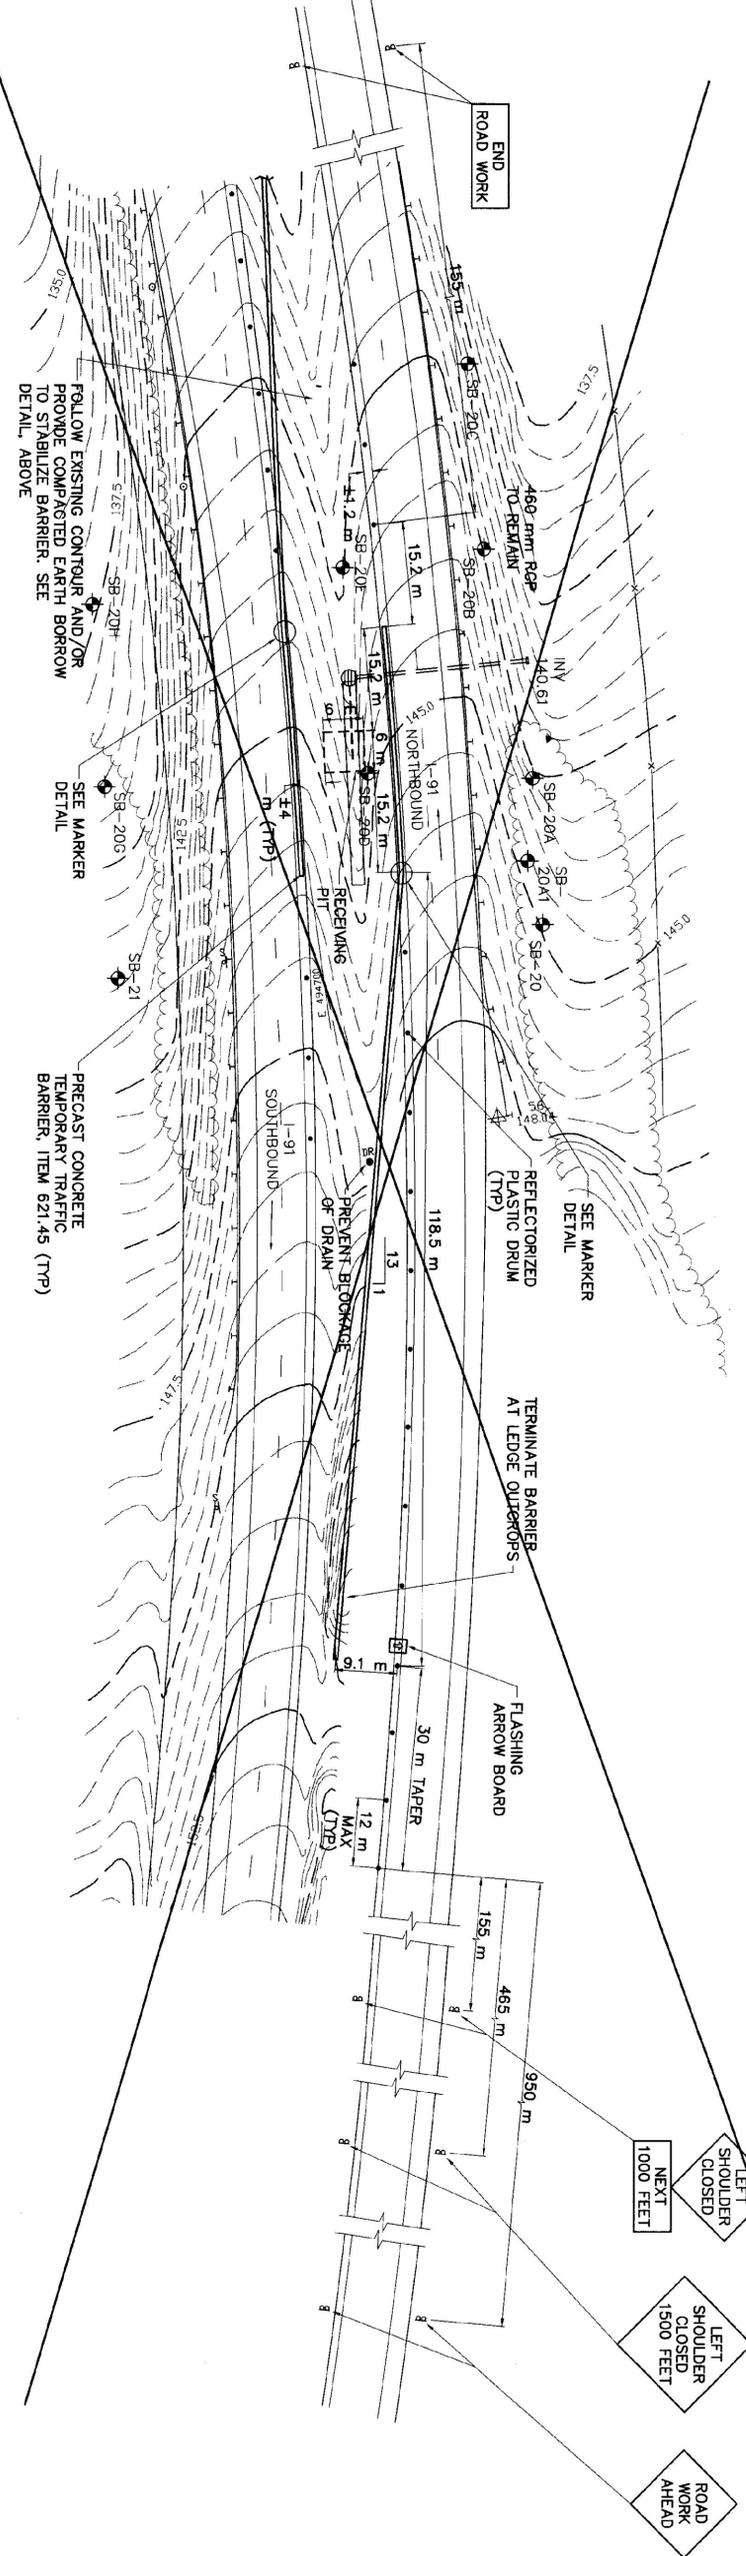

TRAFFIC CONTROL PLAN
SCALE: 1:500

NOTE: ALL WORK THIS SHEET PAYABLE UNDER ITEM 64110 - TRAFFIC CONTROL, UNLESS OTHERWISE NOTED.

RECORD DRAWING

SHOWN PICTORALLY
MAY NOT BE TO SCALE

THESE AS-BUILT OR RECORD DRAWINGS HAVE BEEN PREPARED, IN PART, ON THE BASIS OF INFORMATION COMPILED AND FURNISHED BY OTHERS. THE ENGINEER WILL NOT BE RESPONSIBLE FOR ANY ERRORS OR OMISSIONS WHICH HAVE BEEN INCORPORATED INTO THIS DOCUMENT AS A RESULT OF INFORMATION BY OTHERS.

NO.	DATE	REVISIONS	DRWN	CHKD
5	9/30/98	NO AS-BUILT INFORMATION ADDED	DSM	KAS
4	12/26/98	CONTRACT PLANS	DSM	MPY
3	11/11/98	NEW SHEET	DSM	MPY



PROJECT NO. IM 091-1 (29)
WATER & SEWER EXTENSION PROJECT
TOWN OF GUILFORD
TOWN OF BRATTLEBORO

DSGN BY:	KAS
DRWN BY:	DSM
CHKD BY:	KAS
CHKD BY:	MPY

STATE OF VERMONT
AGENCY OF TRANSPORTATION
SOUTHEAST VERMONT WELCOME CENTER
GUILFORD, VERMONT

DATE: 11/11/98
SHEET NO. 42 OF 55 SHEETS



TIMOTHY D. SMITH & ASSOCIATES, PC ARCHITECTS
OLD RAILROAD STATION
802-442-8184
NORTH BENNINGTON, VERMONT 05257
FAX 802-442-5241

WRIGHT ENGINEERING, LTD. CIVIL ENGINEERS
128 MERCHANTS ROW - P.O. BOX 176
802-775-2511
RUTLAND, VERMONT 05702-0176
FAX 802-775-8915