



SHEET REFERENCE	SHEET NUMBERS
A	C1, C4, C17, C20, C30
B	C2, C3, C18, C21, C31
C	C5, C8, C19, C22
D	C26
E	C27
F	E1
G	E2
H	C28
I	C46
J	L4

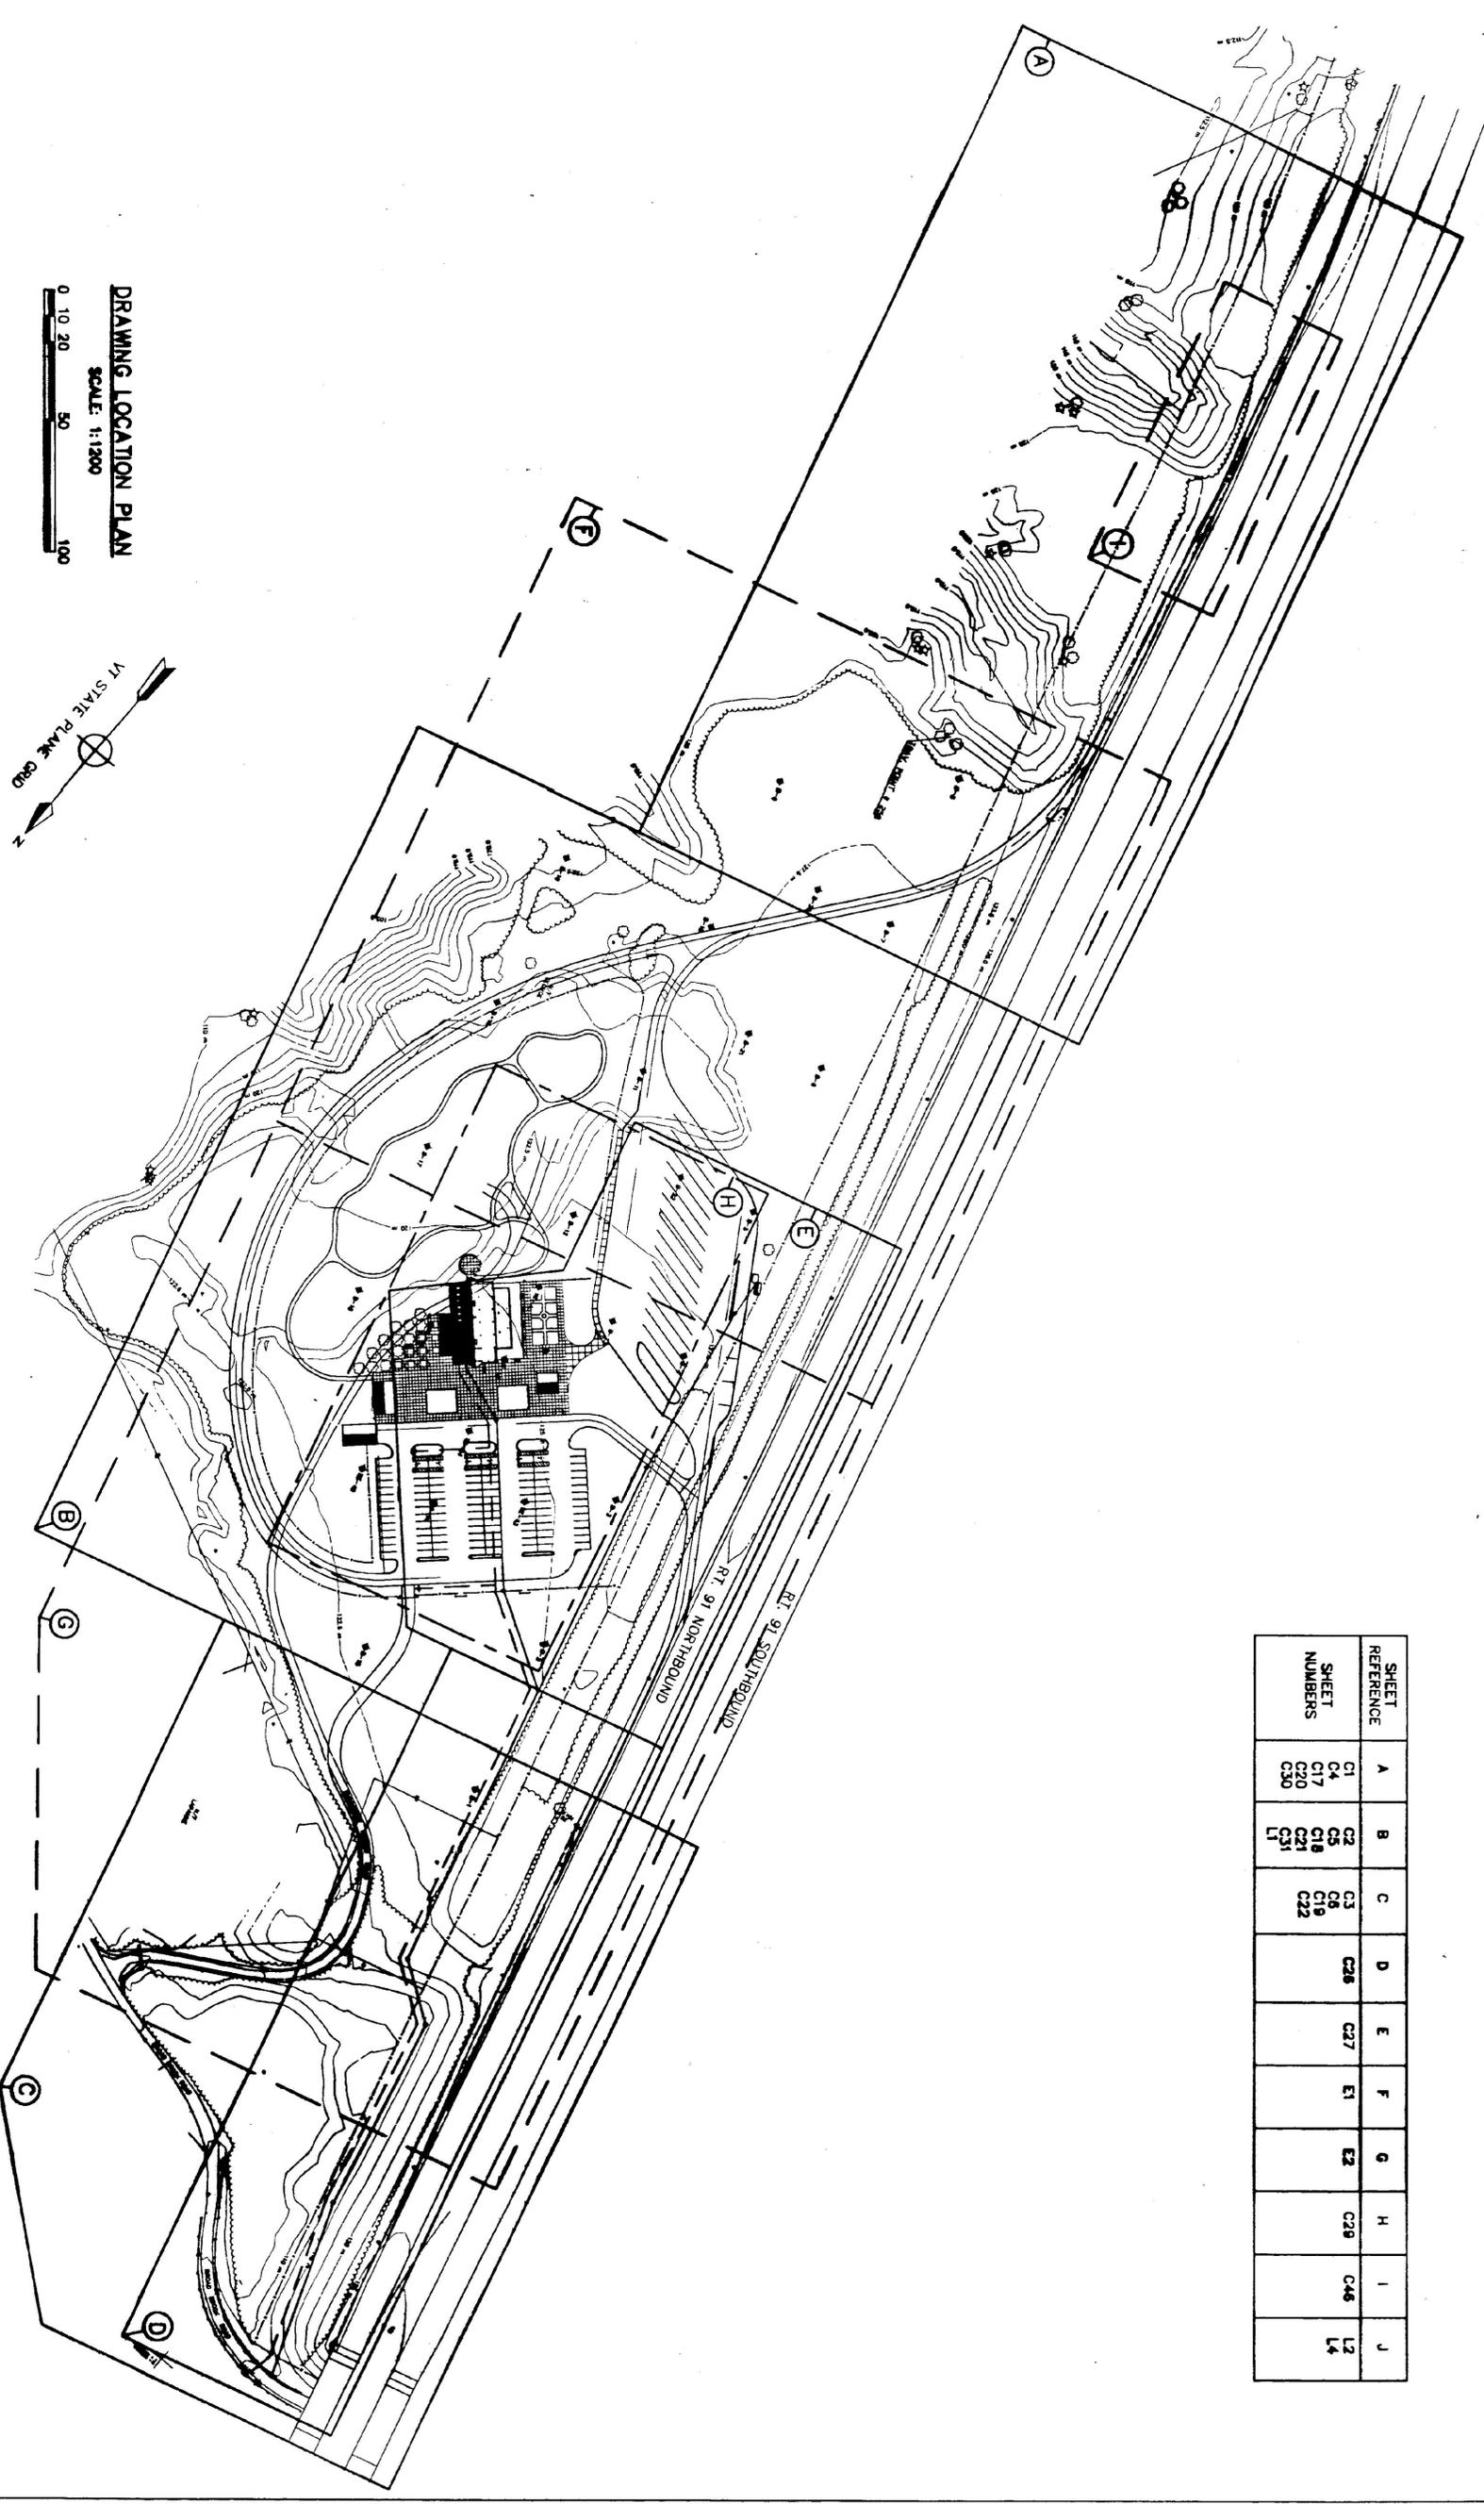

DRAWING LOCATION PLAN
SCALE: 1:1200

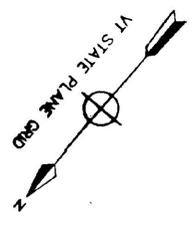

NO.	DATE	DRAWING	DRAWN (CHKD)	TIMOTHY D. SMITH & ASSOCIATES, PC ARCHITECTS OLD RAILROAD STATION 802-443-8184 NORTH BENNINGTON, VERMONT 05237 FAX 802-442-6241		PROJECT NO. IM 091-1 (30) SOUTHEAST VERMONT WELCOME CENTER GUILFORD, VERMONT		STATE OF VERMONT AGENCY OF ADMINISTRATION DEPARTMENT OF BUILDINGS & GENERAL SERVICES	SHEET NO. _____ OF _____ SHEETS
				WRIGHT ENGINEERING, LTD. CIVIL ENGINEERS 125 HUNTINGTON RD., P.O. BOX 178 FERRISBURGH, VERMONT 05752 TEL 778-8811 FAX 778-8815	BOB W. HALL CONSULTING ENGINEER, INC. 540 HALLAM STREET FERRISBURGH, VERMONT 05752 TEL 778-8888 FAX 778-8888	T.J. BOYLE AND ASSOCIATES LANDSCAPE ARCHITECTS 301 COLLIER STREET BURLINGTON, VT 05401 TEL 848-1542 FAX 848-3005	DSGN BY: DRWN BY: CHKD BY:		
		RECORD DRAWING		STATE OF VERMONT AGENCY OF ADMINISTRATION DEPARTMENT OF BUILDINGS & GENERAL SERVICES		IP			