


LEGEND

- | EXISTING | | PROPOSED | |
|----------|-----------------------|----------|---|
| ◆ B-1 | SOIL BORING | — | SANITARY SEWER |
| — | PAVED LINE | — | STORM SEWER/OVERFLOW |
| — | GRAVEL ROAD | — | WATER MAIN |
| — | LOWE TREE | — | WATER DISTRIBUTION LINE |
| — | THREE TREE | — | NON-POTABLE WATER |
| — | PROPERTY LINE | — | LP GAS LINE |
| — | GROUND CONTROL PT | — | CONDUIT |
| — | CONTOURS (0.5 m INT) | — | SEWER MANHOLE |
| — | GUARD RAIL | — | CATCH BASIN |
| — | CONC HIGHWAY MONUMENT | — | THRUST BLOCK |
| — | CATCH BASIN | — | FIRE HYDRANT |
| — | EDGE OF WETLAND | — | YARD HYDRANT |
| | | — | GATE VALVE |
| | | — | RETAINING WALL |
| | | — | CONTOURS (0.5 m INT) |
| | | — | SILT FENCE W/HAY BALES |
| | | — | BOX BEAM GUARD RAIL |
| | | — | STEEL BEAM GUARD RAIL |
| | | — | CULVERT |
| | | — | ROADWAY CENTERLINE (W/20 m STATION TICKS) |
| | | — | TRAFFIC SIGN |
| | | — | SWALE |
| | | — | RIP-RAP |
| | | — | FENCE |

SCALE: 1:500

DESIGN STATIONING HAS BEEN LEFT FOR LOCATIONAL AND INFORMATIONAL PURPOSES ONLY. STATIONING SHOWN IS NOT AS-BUILT.

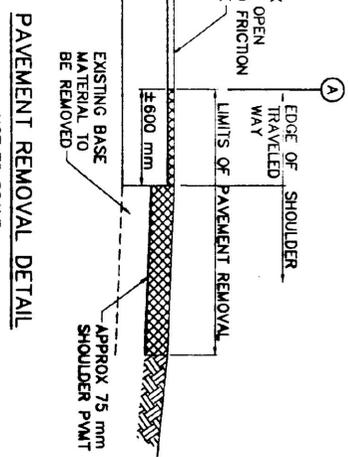

OFFSET LEFT	STATION	OFFSET RIGHT
0.414	-0+001.486	0.907
1.280	0+020	0.445
1.802	0+040	
2.008	0+060	
2.214	0+080	
2.197	0+100	
2.110	0+120	
2.031	0+140	
1.978	0+160	
1.938	0+180	
1.907	0+200	
3.834	0+240	

NOTE: OFFSETS ARE PERPENDICULAR TO THE ROAD CENTERLINE

NOTE:
IN LOCATIONS OF GUARDRAIL/PAVEMENT REMOVAL/REPLACEMENT THE AREA SHALL BE PROTECTED BY SIGAGE LANE CLOSURE AND CONCRETE MEDIAN BARRIER PER DRAWING C-17. THE CONTRACTOR SHALL PROCEED CONTINUOUSLY AND DILIGENTLY ON ALL WORK REQUIRING A LANE CLOSURE OF THE INTERSTATE SUCH THAT THE DURATION OF THE CLOSURE WILL BE THE MINIMUM REQUIRED. NO WINTER LANE CLOSURE OF THE INTERSTATE SHALL BE ALLOWED (BETWEEN NOVEMBER 1 AND APRIL 15)

RECORD DRAWING
SHOWN PICTORALLY
MAY NOT BE TO SCALE

THESE AS-BUILT OR RECORD DRAWINGS HAVE BEEN PREPARED, IN PART, ON THE BASIS OF INFORMATION OBTAINED AND FURNISHED BY OTHERS. THE DRAWER WILL NOT BE RESPONSIBLE FOR ANY ERRORS OR OMISSIONS WHICH HAVE BEEN RECEIVED OR DERIVED FROM SUCH INFORMATION OR INFORMATION BY OTHERS.

NO.	DATE	REVISIONS	DESIGN CHIEF	DATE
2	12/20/98	AS-BUILT INFORMATION ADDED	KAS	
1	12/15/98	REVISIONS PER PER/TWMA REVIEW	KAS	

TIMOTHY D. SMITH & ASSOCIATES, PC ARCHITECTS
OLD RAILROAD STATION
802-442-8184

ROBERT W. HALL
CONSULTING ENGINEER, INC.
435-780-2889

T.J. BOYLE AND ASSOCIATES
LANDSCAPE ARCHITECTS
488-488-3888

PROJECT NO. IM 091-1 (30)
SOUTHEAST VERMONT WELCOME CENTER
GUILFORD, VERMONT

STATE OF VERMONT
AGENCY OF ADMINISTRATION
DEPARTMENT OF
BUILDINGS & GENERAL SERVICES

SHEET TITLE: DEMOLITION PLAN, DETAIL AND LEGEND

DESIGN BY: JAC
DRAWN BY: DSM
CHECK BY: JAC

DATE: 1-16-98

SHEET NO. _____ OF _____ SHEETS