



PLAN  
SCALE: 1:500

- NOTES:
1. FINISHED PAVEMENT GRADE STA 1+318 TO 1+459 TO BE ADJUSTED IN FIELD TO MATCH EXIST HIGHWAY EDGE OF PAVEMENT.
  2. OPEN GRADE FRICTION COURSE (OGFC) REQUIRED ON ACCELERATION LANE FROM STA 1+280 TO STA 1+559. TRANSITION WEAR COURSE TO OGFC.

THE CERTIFICATION BELOW APPLIES ONLY TO AS-BUILT NOTATIONS AND NOT TO THE ORIGINAL BASIS OR INTENT OF DESIGN.

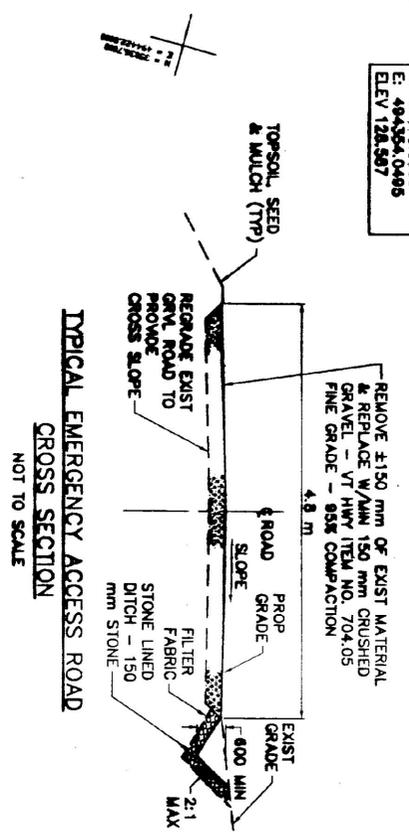

TYPICAL EMERGENCY ACCESS ROAD  
CROSS SECTION  
NOT TO SCALE

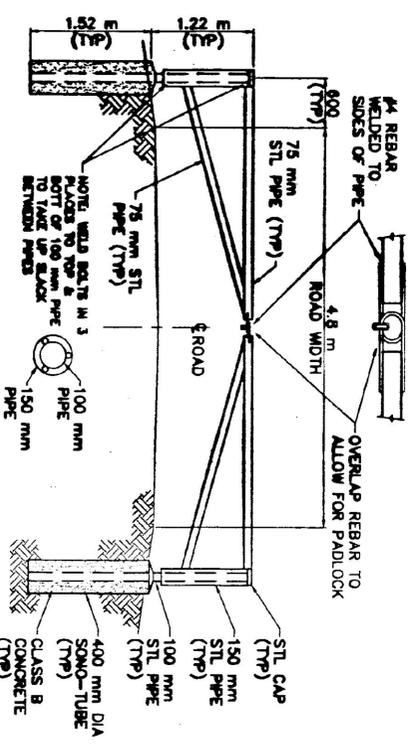

ACCESS ROAD GATE DETAIL  
NOT TO SCALE

RECORD DRAWING

SHOWN PICTORALLY  
MAY NOT BE TO SCALE

CTR NOTE:  
ALL STEEL TO RECEIVE  
(1) COAT PRIMER AND  
(2) COATS EPOXY  
PAINT - ORANGE

NO.	DATE	REVISIONS	DRWN	CHKD
2	10/20/99	AS-BUILT INFORMATION ADDED	DSM	KAS
1	08/25/99	REVISED PER BIR/THVA REVIEW	DSM	KAS



PROJECT NO. IM 091-1 (30)  
SOUTHEAST VERMONT WELCOME CENTER  
GUILDFORD, VERMONT

STATE OF VERMONT  
AGENCY OF ADMINISTRATION  
DEPARTMENT OF  
BUILDINGS & GENERAL SERVICES



DESIGN BY: JAC  
DRAWN BY: DSM  
CHECKED BY: JAC  
DATE: 1-16-98

TIMOTHY D. SMITH & ASSOCIATES, PC ARCHITECTS  
OLD RAILROAD STATION  
902-442-8184

NORTH BENNINGTON, VERMONT 05257  
FAX 902-442-5241

ROBT W. HALL  
CONSULTING ENGINEERS, INC.  
444 WELDON STREET EXTENSION, RT. 4  
BENNINGTON, VERMONT 05201  
405-786-8888

T.J. BOYLE AND ASSOCIATES  
LANDSCAPE ARCHITECTS  
301 COLLEGE STREET  
BENNINGTON, VERMONT 05201  
405-848-3000

WRIGHT ENGINEERING, LTD.  
100 WASHINGTON ST. - 2ND FLOOR, RT. 176  
BENNINGTON, VERMONT 05201  
405-786-8111

STATE OF VERMONT  
REGISTERED PROFESSIONAL ENGINEER  
TIMOTHY D. SMITH  
LICENSE NO. 10000