


TRUCK PARKING ACCESS ROAD/ACCELERATION RAMP PROFILE
SCALE: 1:500 H
1:100 V

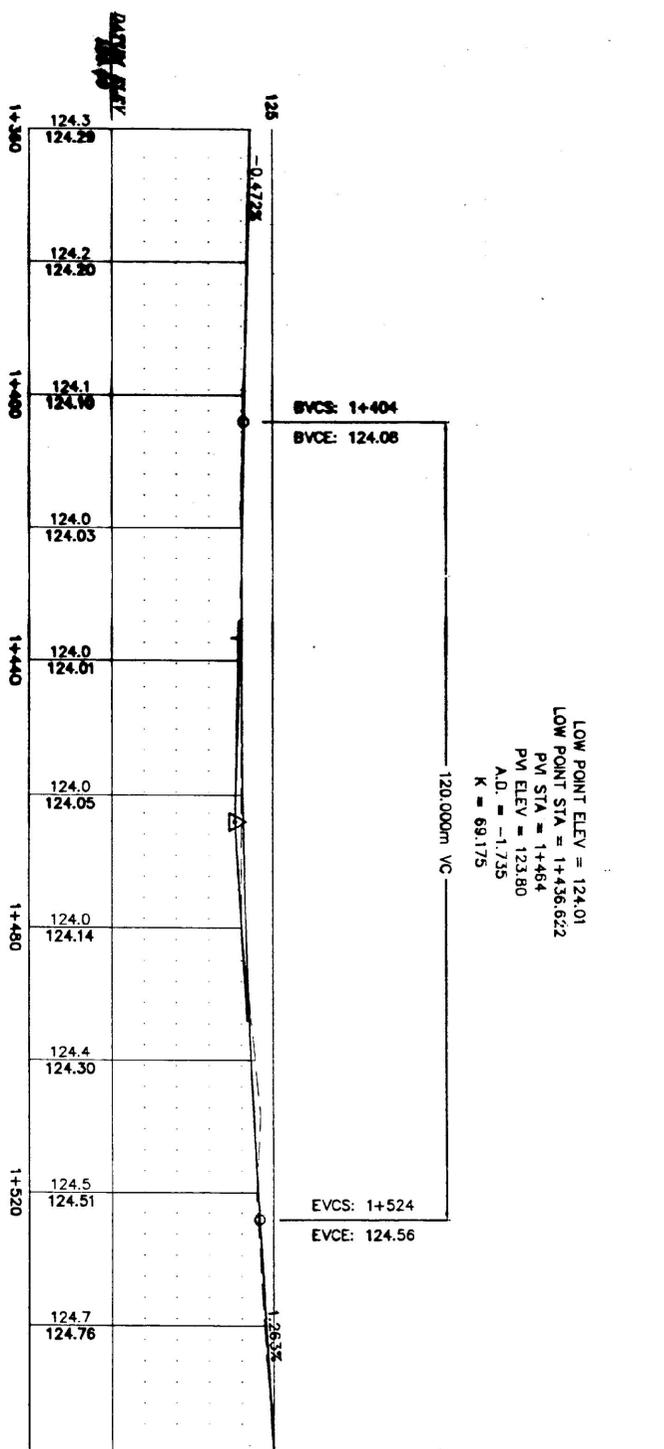

TRUCK PARKING ACCESS ROAD/ACCELERATION RAMP PROFILE
SCALE: 1:500 H
1:100 V

THE CERTIFICATION BELOW APPLIES ONLY TO AS-BUILT NOTATIONS AND NOT TO THE ORIGINAL BASIS OR INTENT OF DESIGN.



RECORD DRAWING
SHOWN PICTORALLY
MAY NOT BE TO SCALE
THESE AS-BUILT OR RECORD DRAWINGS HAVE BEEN PREPARED, IN PART, ON THE BASIS OF INFORMATION, CONTAINED AND FORWARDED BY THE CONTRACTOR, AND THE ENGINEER ASSOCIATED WITH THIS DRAWING DOES NOT BE RESPONSIBLE FOR ANY ERRORS OR OMISSIONS WHICH HAVE BEEN INCORPORATED INTO THIS DOCUMENT AS A RESULT OF INFORMATION BY OTHERS.

NO. 1		DATE	DESCRIPTION
NO. 2		DATE	DESCRIPTION
NO. 3		DATE	DESCRIPTION
NO. 4		DATE	DESCRIPTION
NO. 5		DATE	DESCRIPTION
NO. 6		DATE	DESCRIPTION
NO. 7		DATE	DESCRIPTION
NO. 8		DATE	DESCRIPTION
NO. 9		DATE	DESCRIPTION
NO. 10		DATE	DESCRIPTION
NO. 11		DATE	DESCRIPTION
NO. 12		DATE	DESCRIPTION
NO. 13		DATE	DESCRIPTION
NO. 14		DATE	DESCRIPTION
NO. 15		DATE	DESCRIPTION
NO. 16		DATE	DESCRIPTION
NO. 17		DATE	DESCRIPTION
NO. 18		DATE	DESCRIPTION
NO. 19		DATE	DESCRIPTION
NO. 20		DATE	DESCRIPTION
NO. 21		DATE	DESCRIPTION
NO. 22		DATE	DESCRIPTION
NO. 23		DATE	DESCRIPTION
NO. 24		DATE	DESCRIPTION
NO. 25		DATE	DESCRIPTION
NO. 26		DATE	DESCRIPTION
NO. 27		DATE	DESCRIPTION
NO. 28		DATE	DESCRIPTION
NO. 29		DATE	DESCRIPTION
NO. 30		DATE	DESCRIPTION

PROJECT NO. JM 091-1 (30)
SOUTHEAST VERMONT WELCOME CENTER
GUILFORD, VERMONT

STATE OF VERMONT
AGENCY OF ADMINISTRATION
DEPARTMENT OF
BUILDINGS & GENERAL SERVICES

DESIGN BY: JAC
DRAWN BY: DSM
CHECK BY: JAC
DATE: 1-16-98

TRUCK PARKING ACCESS ROAD/
ACCELERATION RAMP PROFILE

SHEET NO. _____ OF _____ SHEETS

TIMOTHY D. SMITH & ASSOCIATES, PC ARCHITECTS
OLD RAILROAD STATION
802-442-8184

ROBT W. HALL
CONSULTING ENGINEERS, INC.
440 MADISON STREET EXTENSION, 2ND FLOOR
MONTPELIER, VERMONT 05602
802-253-3333

T.J. BOYLE AND ASSOCIATES
LANDSCAPE ARCHITECTS
50 COLLEGE STREET
BRUNSWICK, VERMONT 05410
802-253-3333

VERMONT PROFESSIONAL SEAL