


INTERSTATE I-91 (SOUTHBOUND)

INTERSTATE I-91 (NORTHBOUND)

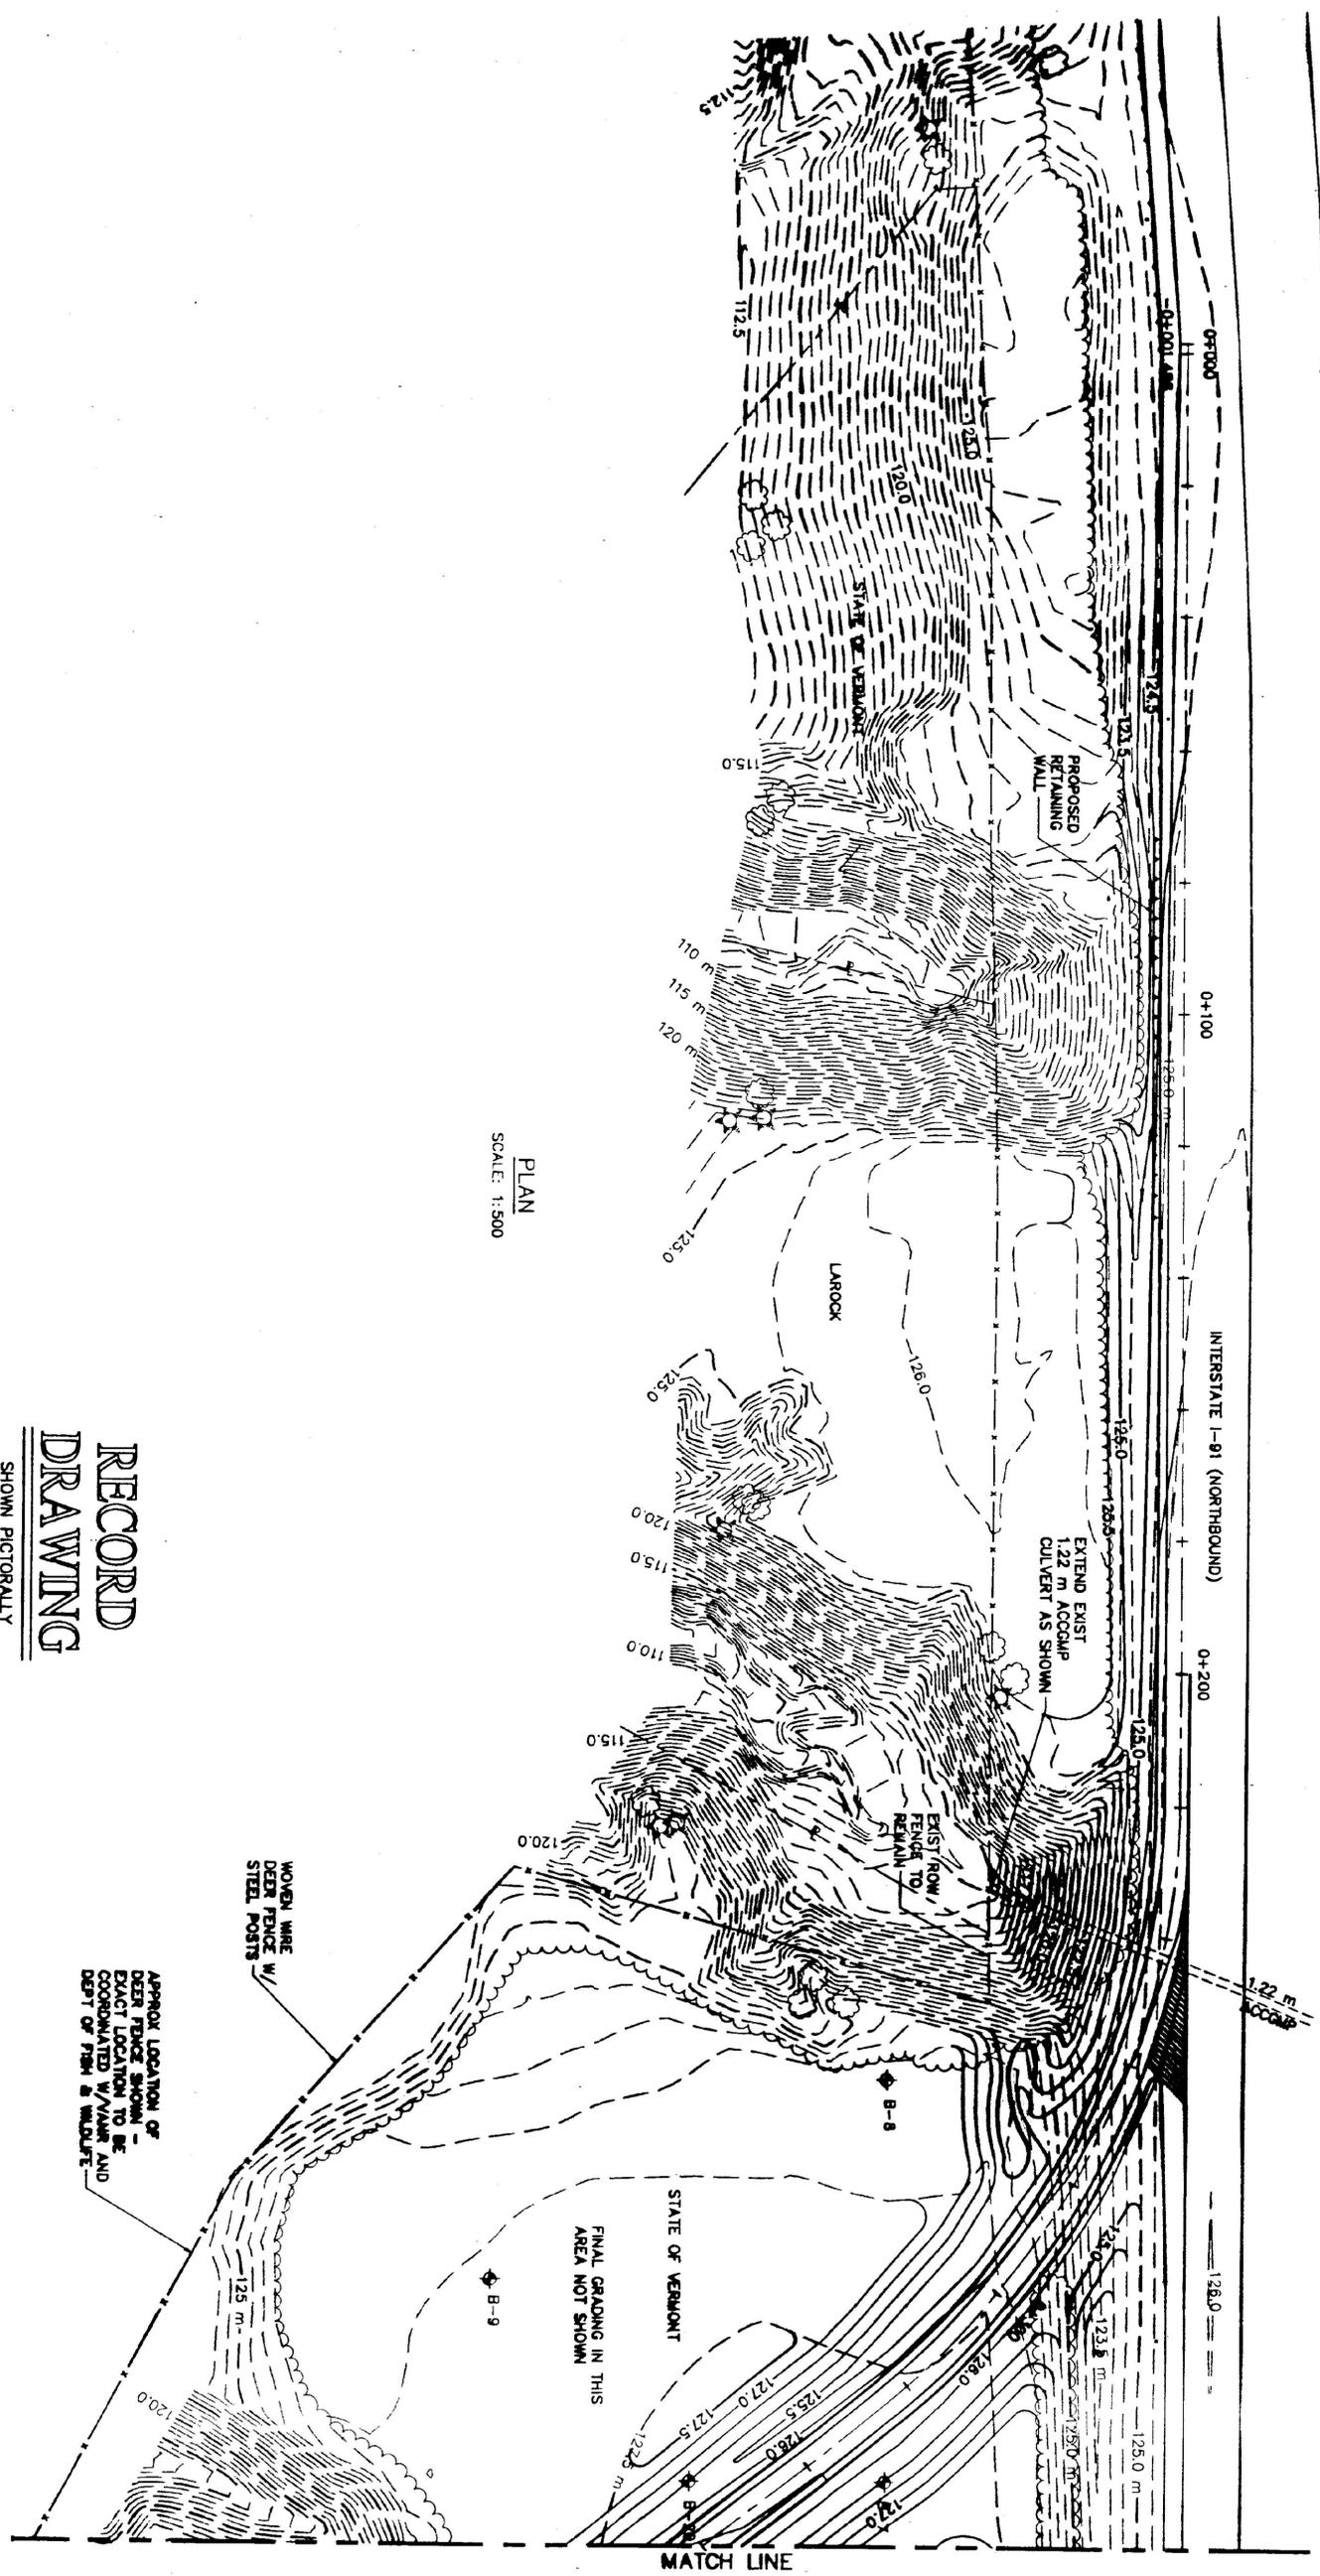

**RECORD  
DRAWING**

SHOWN PICTORALLY  
MAY NOT BE TO SCALE

THESE AS-BUILT OR RECORD DRAWINGS  
HAVE BEEN PREPARED, IN PART, ON THE  
BASIS OF INFORMATION COMPILED AND  
FURNISHED BY OTHERS. THE ENGINEER WILL  
NOT BE RESPONSIBLE FOR ANY ERRORS OR  
OMISSIONS WHICH HAVE BEEN INCORPORATED  
INTO THIS DOCUMENT AS A RESULT OF  
INFORMATION BY OTHERS.



APPROX LOCATION OF  
DEER FENCE SHOWN -  
EXACT LOCATION TO BE  
COORDINATED WITH AND  
DEPT OF FISH & WILDLIFE

WOVEN WIRE  
DEER FENCE W/  
STEEL POSTS

STATE OF VERMONT  
FINAL GRADING IN THIS  
AREA NOT SHOWN

MATCH LINE

NO.	DATE	REVISIONS	DESIGNED BY	CHECKED BY
1	12/99	AS-BUILT INFORMATION ADDED	DSM	KAS



PROJECT NO. IM 091-1 (30)  
SOUTHEAST VERMONT WELCOME CENTER  
GUILFORD, VERMONT

DESIGNED BY: JAC  
DRAWN BY: DSM  
CHECKED BY: JAC

STATE OF VERMONT  
AGENCY OF ADMINISTRATION  
DEPARTMENT OF  
BUILDINGS & GENERAL SERVICES

DATE: 1-18-99  
SHEET NO. 17 OF 17 SHEETS

C17

TIMOTHY D. SMITH & ASSOCIATES, PC ARCHITECTS  
OLD RAILROAD STATION  
802-442-8184

ROBT W. HALL  
CONSULTING ENGINEERS, INC.  
540 MADISON STREET EXTENSION, FTE. 2  
MADISON, VERMONT 05401-0008  
802-442-3000

T.J. BOYLE AND ASSOCIATES  
LANDSCAPE ARCHITECTS  
300 COLLEGE STREET  
BURLINGTON, VERMONT 05401  
802-442-3000

WRIGHT ENGINEERING, LTD.  
CIVIL ENGINEERS  
140 WASHINGTON ST. - 7th FLOOR  
MONTPELIER, VERMONT 05602-4111  
802-748-0044