

NO.	DATE	BY	REVISIONS
1	12/15/99	DSM	AS-BUILT INFORMATION ADDED
		DSM	DESIGN CHANGES

TIMOTHY D. SMITH & ASSOCIATES, PC ARCHITECTS
 OLD RAILROAD STATION
 805-442-8184

ROBERT W. HALL
 CONSULTING ENGINEERS, INC.
 545 MARKET STREET EXTENSION, STE. 3
 FERRISBURGH, VERMONT 05752-3005
 TEL: 789-3005


T.J. BOYLE AND ASSOCIATES
 LANDSCAPE ARCHITECTS
 301 COLLIER STREET
 BURLINGTON, VERMONT 05401-1820
 TEL: 863-2529

PROJECT NO. IM 091-1 (30)
 SOUTHEAST VERMONT WELCOME CENTER
 GUILFORD, VERMONT

DESIGN BY: JAC
 DRAWN BY: DSM
 CHECK BY: JAC

STATE OF VERMONT
 AGENCY OF ADMINISTRATION
 DEPARTMENT OF
 BUILDINGS & GENERAL SERVICES

DATE: 1-16-98
 SHEET NO. _____ OF _____ SHEETS

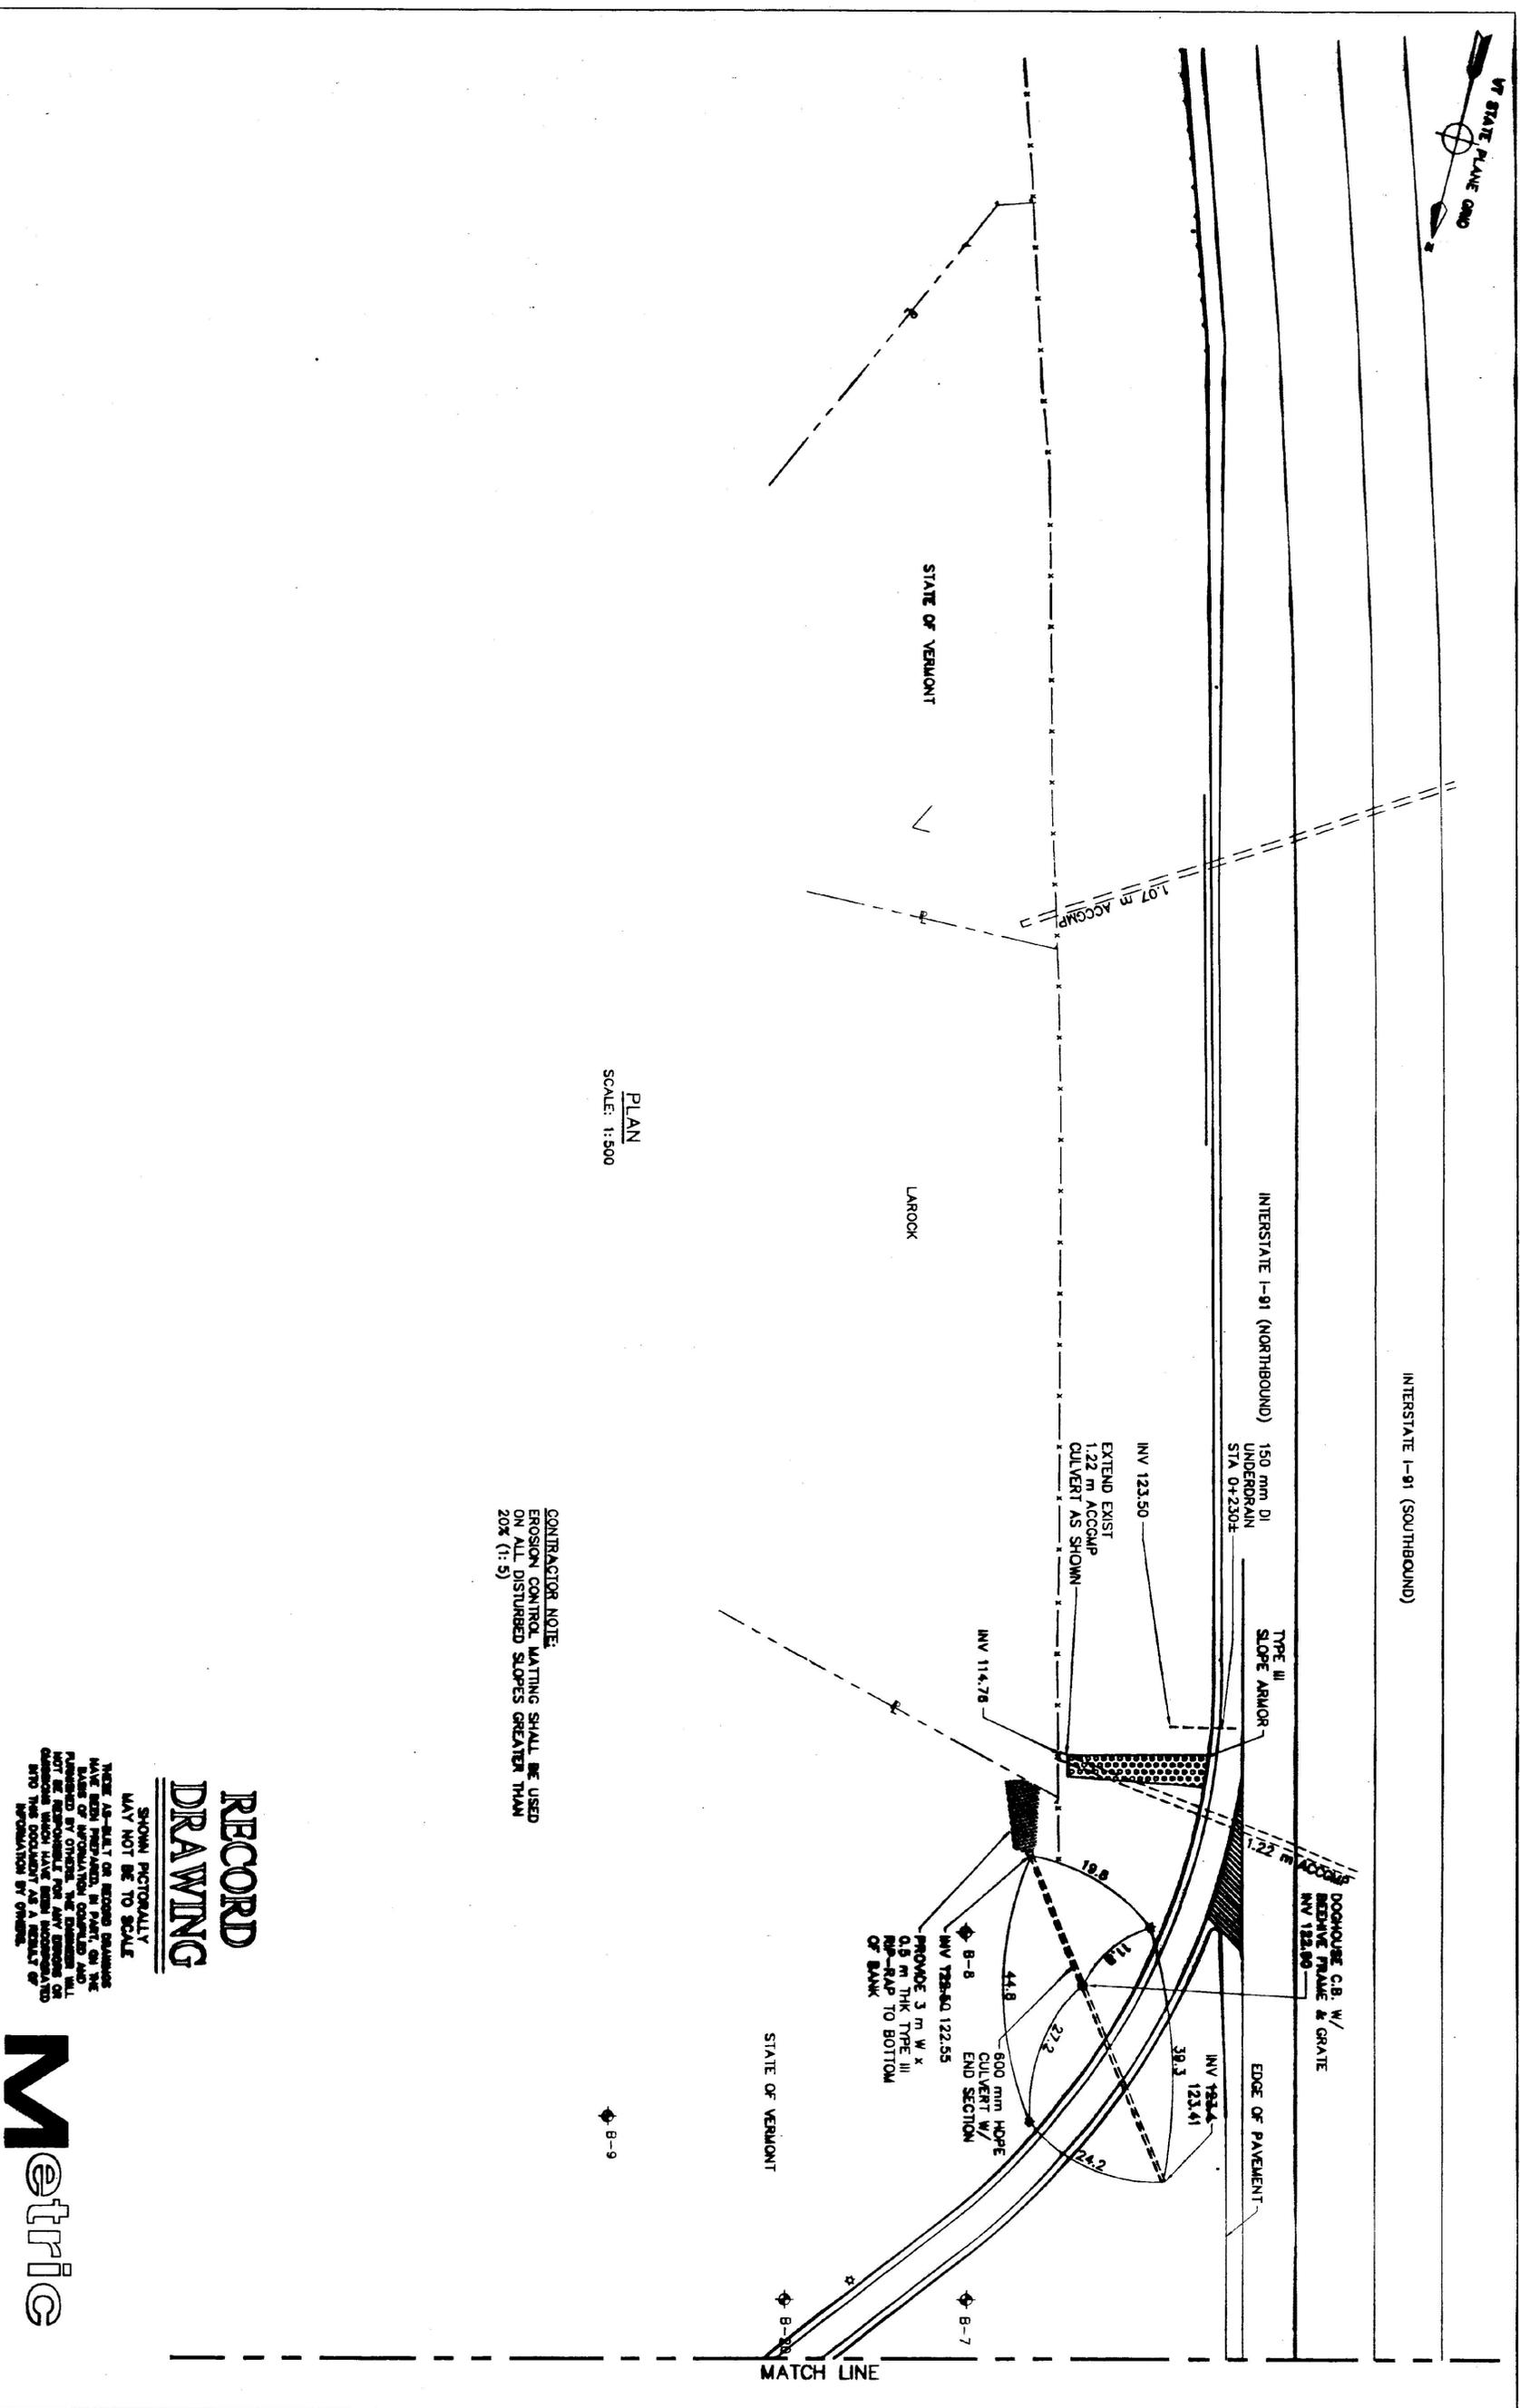

PLAN
 SCALE: 1:500

CONTRACTOR NOTE:
 EROSION CONTROL MATTING SHALL BE USED
 ON ALL DISTURBED SLOPES GREATER THAN
 20% (1:5)

**RECORD
 DRAWING**

SHOWN PICTORALLY
 MAY NOT BE TO SCALE

NOTE: AS-BUILT OR RECORD DRAWINGS
 HAVE BEEN PREPARED IN PART BY THE
 CONTRACTOR. THE CONTRACTOR SHALL
 BE RESPONSIBLE FOR ANY ERRORS OR
 OMISSIONS WHICH HAVE BEEN INCORPORATED
 INTO THIS DOCUMENT AS A RESULT OF
 INFORMATION BY OWNER.



C20