



NOTES:  
1. FOR 'AS-BUILT' RIM ELEVATIONS  
SEE PLAN SHT C21.  
2. PROFILE NOT CORRECTED TO SHOW  
'AS-BUILT' INFORMATION.

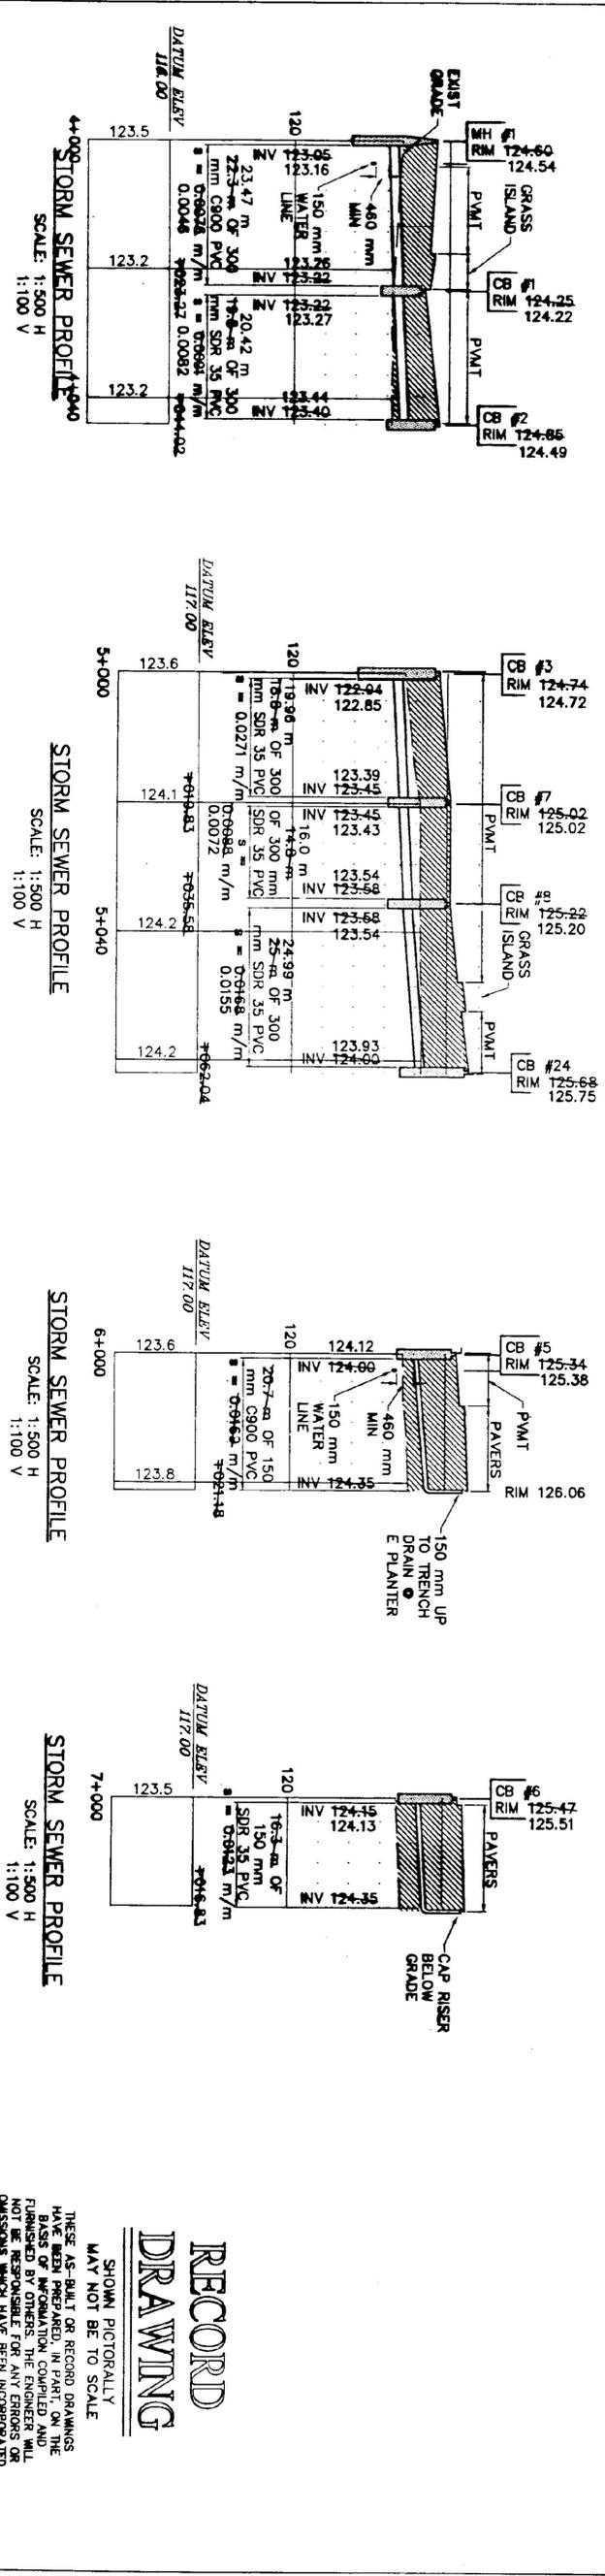

**RECORD DRAWING**  
SHOWN PICTORALLY  
MAY NOT BE TO SCALE  
THESE 'AS-BUILT' OR RECORD DRAWINGS  
HAVE BEEN PREPARED IN PART ON THE  
BASIS OF INFORMATION COMPILED AND  
FURNISHED BY OTHERS. THE ENGINEER WILL  
NOT BE RESPONSIBLE FOR ANY ERRORS OR  
OMISSIONS WHICH HAVE BEEN INCORPORATED  
INTO THIS DOCUMENT AS A RESULT OF  
INFORMATION BY OTHERS.

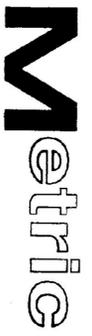

NO.		DATE		REVISIONS		DRAWN		CHECKED	
1		12/00		AS-BUILT INFORMATION ADDED		DSM		KAS	
<p><b>TIMOTHY D. SMITH &amp; ASSOCIATES, PC ARCHITECTS</b>                  OLD RAILROAD STATION                  802-442-8184</p> <p><b>ROBERT W. HALL CONSULTING ENGINEERS, INC.</b>                  400 BALDWIN STREET, SUITE 2                  BIRCHINGTON, VT 05410                  802-663-3555</p> <p><b>T.J. BOYLE AND ASSOCIATES LANDSCAPE ARCHITECTS</b>                  300 COLLEGE STREET                  BIRCHINGTON, VT 05410                  802-663-3555</p>									
<p>PROJECT NO. IM 091-1 (30)                  SOUTHEAST VERMONT WELCOME CENTER                  GUILFORD, VERMONT                  PRELIMINARY DRAWINGS</p>									
DESIGN BY:		JAC		DRAWN BY:		DSM		CHECKED BY:	
DATE:		1-16-06		SHEET NO.:		OF:		SHEETS	
<p>STATE OF VERMONT                  AGENCY OF ADMINISTRATION                  DEPARTMENT OF                  BUILDINGS &amp; GENERAL SERVICES</p>									

**C23**