




STORM SEWER PROFILE
SCALE: 1:500 H
1:100 V

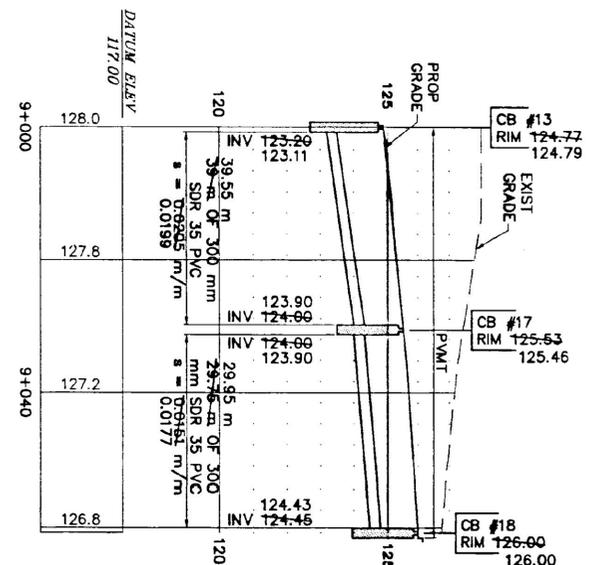


STORM SEWER PROFILE
SCALE: 1:500 H
1:100 V

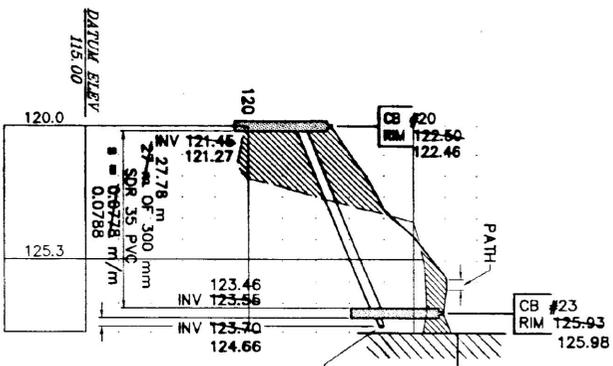

STORM SEWER PROFILE
SCALE: 1:500 H
1:100 V

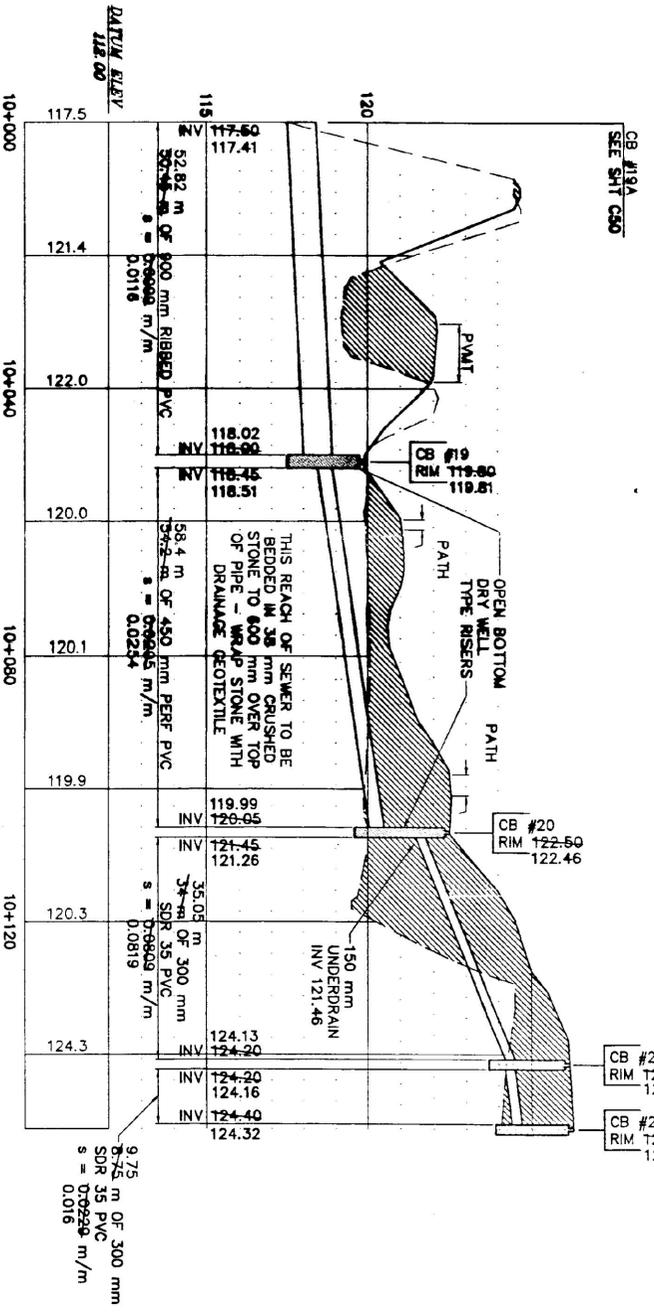

STORM SEWER PROFILE
SCALE: 1:500 H
1:100 V

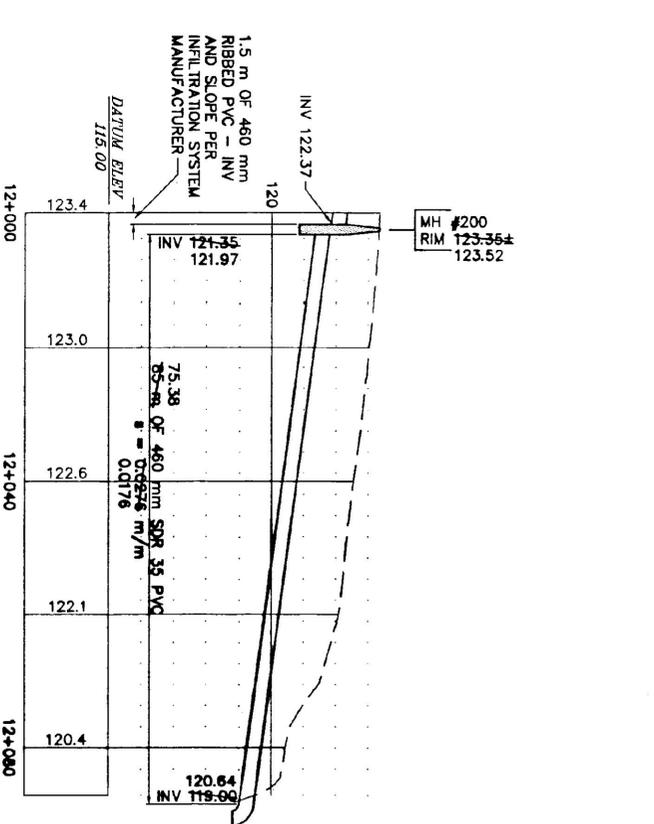

INFILTRATION GALLERY OVERFLOW PROFILE
SCALE: 1:500 H
1:100 V

RECORD DRAWING
SHOWN PICTORALLY
MAY NOT BE TO SCALE
THESE AS-BUILT OR RECORD DRAWINGS
HAVE BEEN PREPARED IN PART ON THE
BASIS OF INFORMATION CONTAINED IN
THIS DRAWING. CONTRACTOR SHALL
NOT BE RESPONSIBLE FOR ANY ERRORS OR
OMISSIONS WHICH HAVE BEEN INCORPORATED
INTO THIS DOCUMENT AS A RESULT OF
INFORMATION BY OTHERS.



PROJECT NO. IM 091-1 (30)

SOUTHEAST VERMONT WELCOME CENTER
GUILDFORD, VERMONT

SHEET TITLE: STORM SEWER PROFILES - TRUCK PARKING AREA

NO.	DATE	REVISIONS	DSM	KAS	CHXD
1	12/99	AS-BUILT INFORMATION ADDED	DSM	KAS	CHXD

TIMOTHY D. SMITH & ASSOCIATES, PC ARCHITECTS OLD RAILROAD STATION 802-442-8184		ROBT W. HALL CONSULTING ENGINEERS, INC. 444 MADISON STREET EXTENSION, STE. 2 BURLINGTON, VERMONT 05401-0002 802-888-3535		T.J. BOYLE AND ASSOCIATES LANDSCAPE ARCHITECTS 301 COLLINGS STREET BURLINGTON, VERMONT 05401-1502 802-888-3535	
DESIGN BY:	JAC	DATE:	1-16-98	SHEET NO.	OF SHEETS
DRAWN BY:	DSM	STATE OF VERMONT AGENCY OF ADMINISTRATION DEPARTMENT OF BUILDINGS & GENERAL SERVICES			
CHXD BY:	MPY	C24			